


DISTRICT	COUNTY	ROUTE	PROJECT	SHEET
4-0	LACKAWANNA	I-81		
CITY OF SCRANTON AND BORO OF DUNMORE				
REVISIONS				

TABULATION OF QUANTITIES		
ITEM	UNIT	QUANTITY
POST MOUNTED SIGNS, TYPE A, LOGO	SQ.FT.	
POST MOUNTED SIGNS, TYPE B, LOGO	SQ.FT.	
POST MOUNTED SIGNS, TYPE C, LOGO	SQ.FT.	
BREAKAWAY SYSTEMS	EACH	
* STEEL S OR W BEAM POSTS	LBS.	
LOGO SIGN MOUNTING	EACH	
RESET POST MOUNTED SIGN, TYPE A	EACH	
EXTRUDED PANEL REPLACEMENT	SQ. FT.	
REMOVAL OF POST MOUNTED MOTORIST SERVICE SIGNS, TYPES B, C & F	L.S.	-

* APPROXIMATE QUANTITY FOR INFORMATION ONLY

SYMBOLS	
○	Existing Sign to Remain
△	Existing Sign to be Removed
◻	Existing Sign Reset as Shown
●	NEW SIGN
×	FUTURE SIGN
⊗	Existing Utility Pole

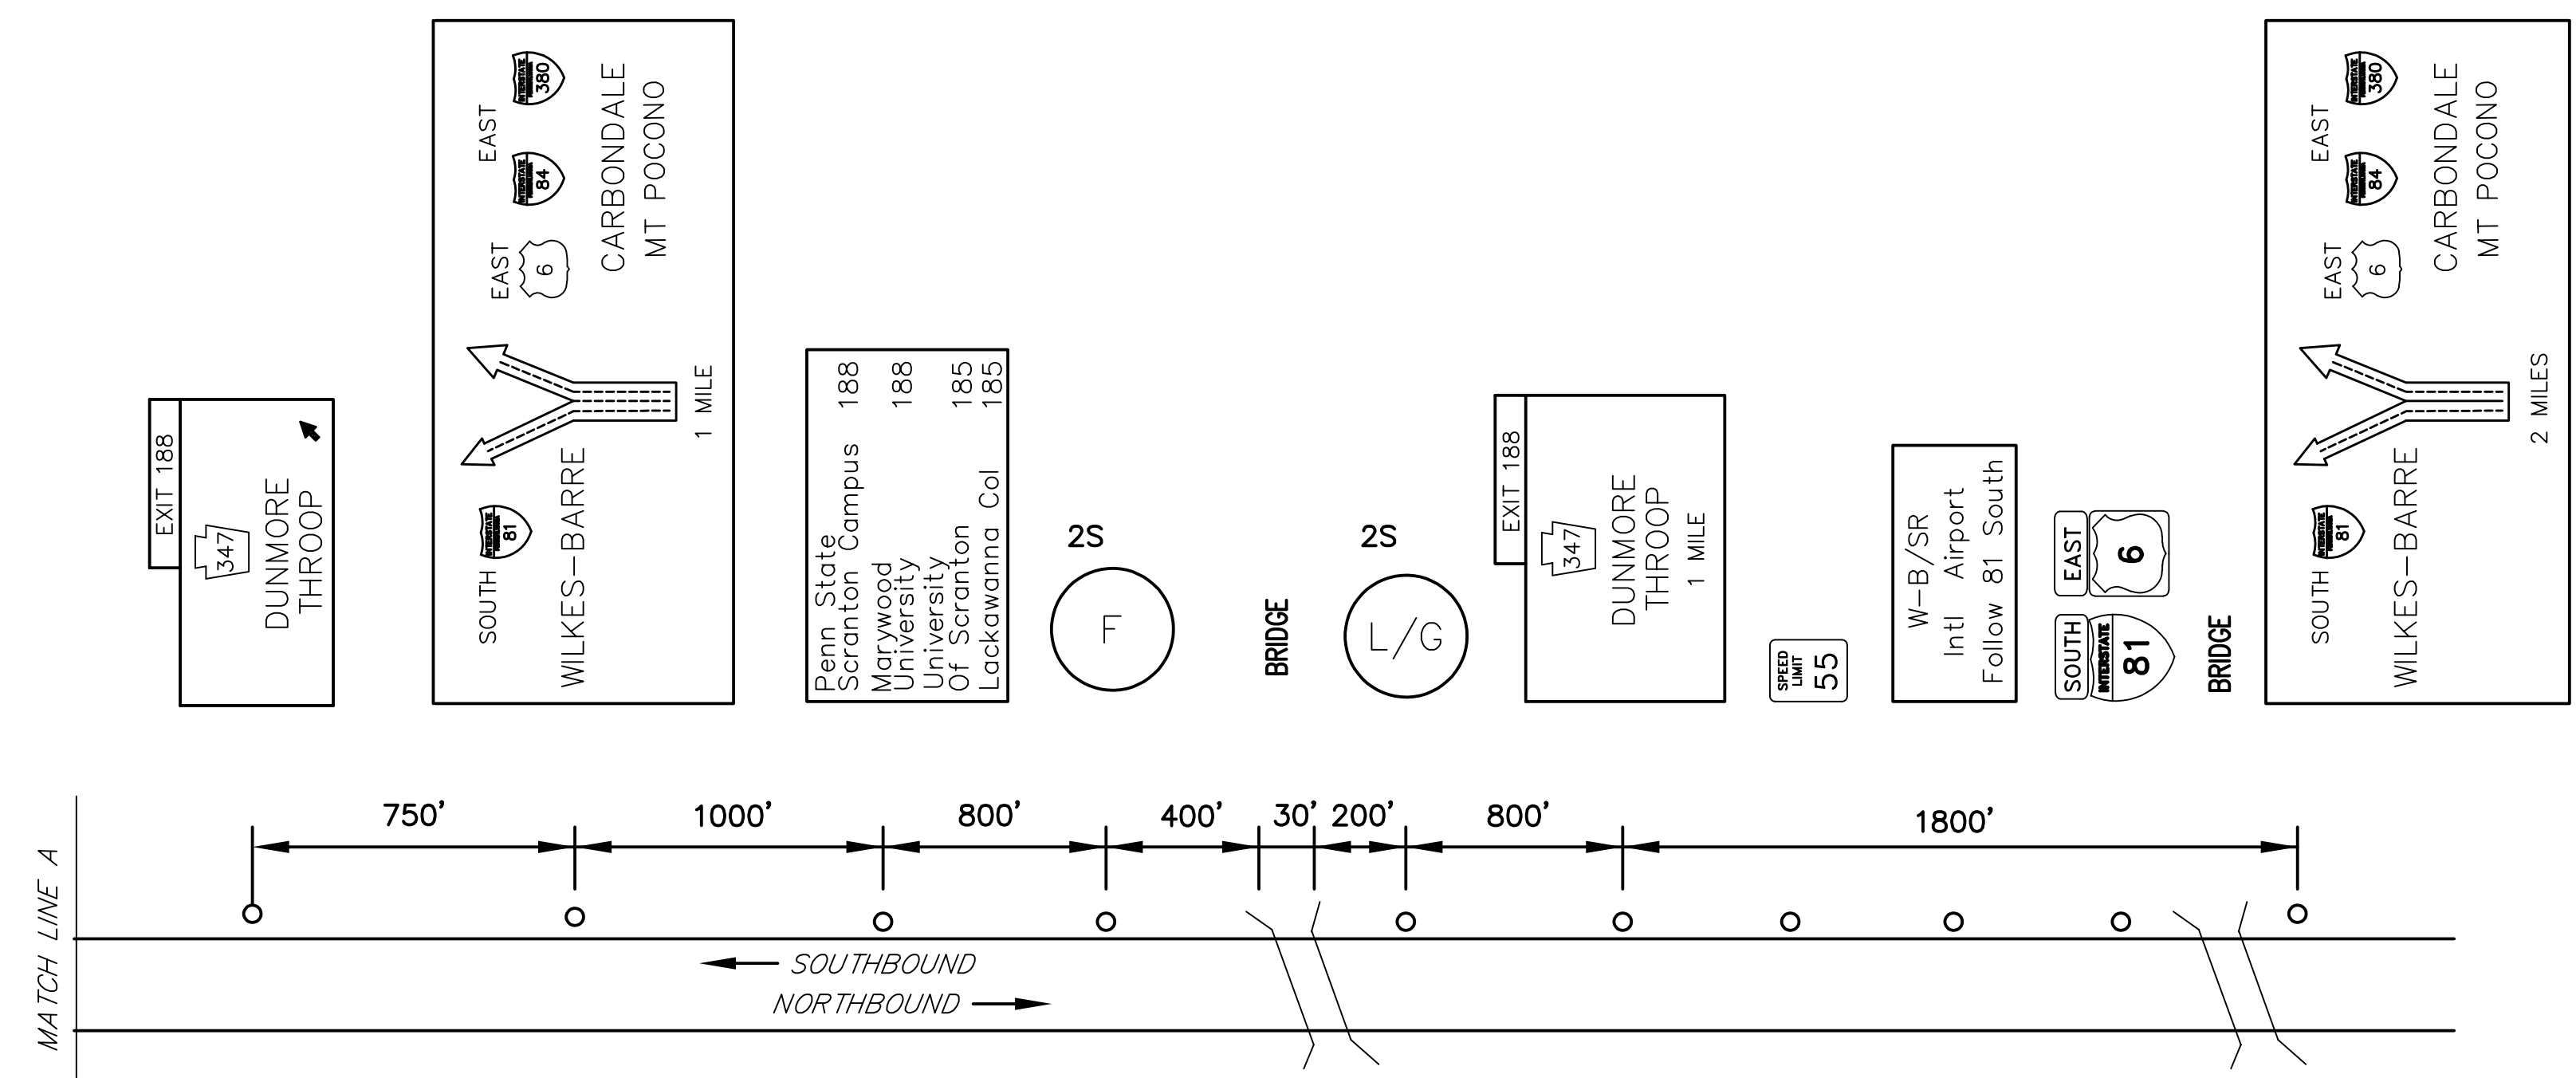

NB NOT ELIGIBLE - INSUFFICIENT SPACE

MAINLINE SCHEMATIC
NOT TO SCALE

LEGEND

2S - GUIDE RAIL




NOTES

LANE CLOSURES & LANE RESTRICTIONS
NOT PERMITTED 6:00AM THRU 9:00AM
AND 3:00PM THRU 6:00PM,
MONDAY THRU FRIDAY.

NO LANE CLOSURES & LANE RESTRICTIONS
DURING HOLIDAY PERIODS AS DEFINED BY DISTRICT 4-0.

EXIT 188 SPECIFIC INFORMATION PANEL			
LEGEND	DIRECTION	BUSINESS	LOGO. NO.
GAS	SB	EXXON (24 HRS/DIESEL)	5
		SUNOCO	7
		SHEETZ	10
FOOD	SB	BURGER KING	1
		McDONALD'S	2
		WENDY'S	3
		DUNKIN' DONUTS	9
		SUBWAY	11
LODGING	SB	BAYMONT SUITES	4
		SLEEP INN & SUITES	8

SB SIGNS

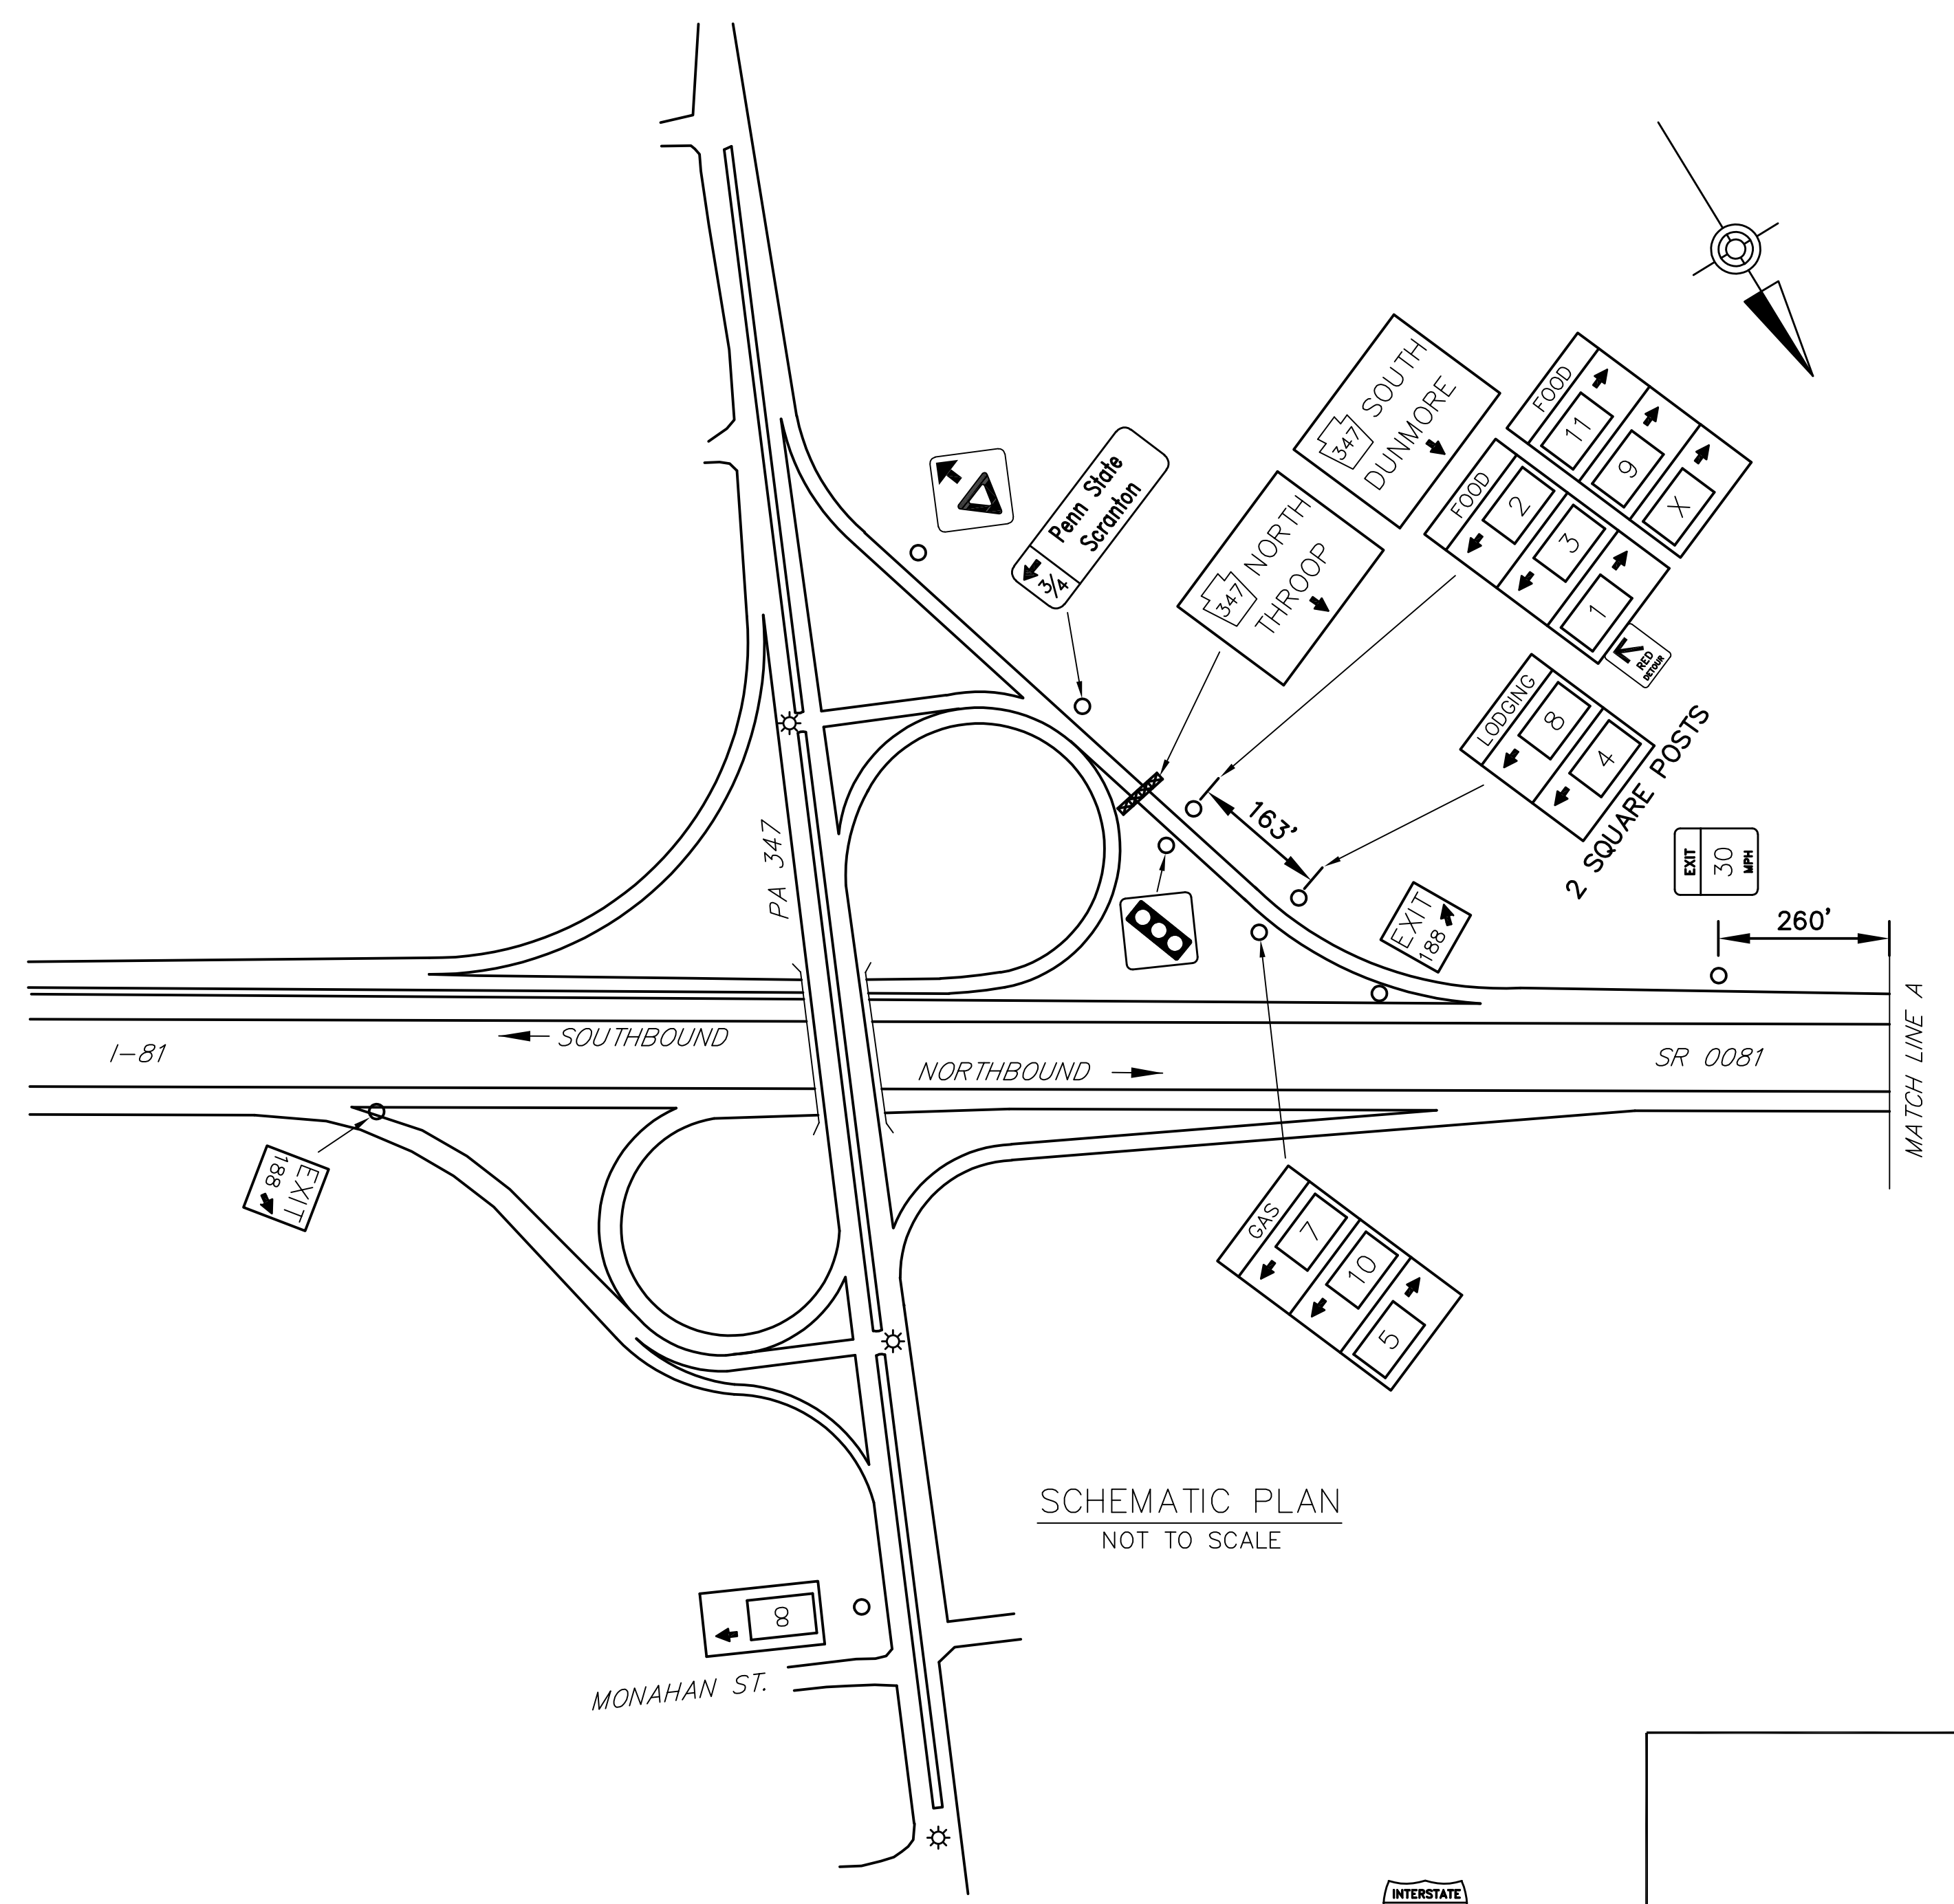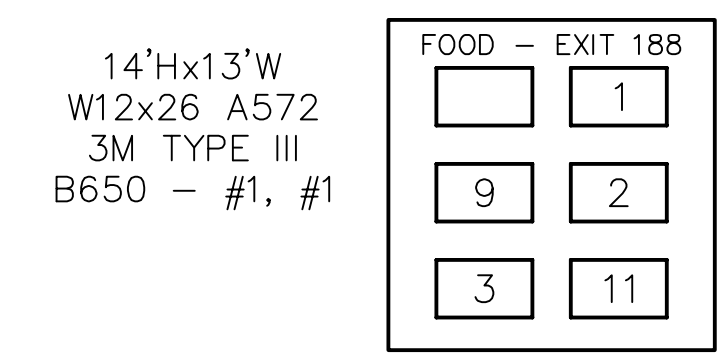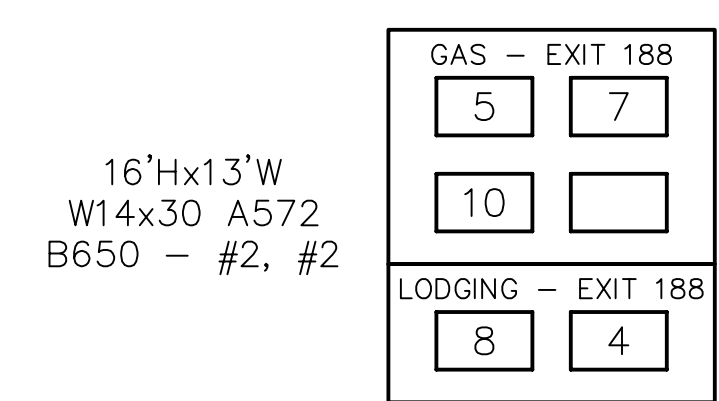

SCHEMATIC PLAN
NOT TO SCALE

DUNMORE / THROOP
 EXIT 188

\NORTHDUN\PROJECTS\4-0\AS-BUILT DRAWINGS\VENNDOT DISTRICT 04\LACKAWANNA - 3510-XX-SHOW-BL-EXIT 188 PLAN
 SHEET 07 OF 2023 6.30 AM