

NB NOT ELIGIBLE - INSUFFICIENT SPACE

MAINLINE SCHEMATIC
NOT TO SCALE

## LEGEND

2S - GUIDE RAIL

## NOTES

LANE CLOSURES & LANE RESTRICTIONS NOT PERMITTED 6:00AM THRU 9:00AM AND 3:00PM THRU 6:00PM, MONDAY THRU FRIDAY.

NO LANE CLOSURES & LANE RESTRICTIONS
DURING HOLIDAY PERIODS AS DEFINED BY DISTRICT 4-0.

SB	SIGNS


EXIT 188 SPECIFIC INFORMATION PANEL					
LEGEND	DIRECTION	BUSINESS	LOGO. NO.		
GAS	SB	EXXON (24 HRS/DIESEL)	5		
		SUNOCO	7		
		SHEETZ	10		
FOOD	SB	BURGER KING	1		
		McDONALD'S	2		
		WENDY'S	3		
		DUNKIN' DONUTS	9		
		SUBWAY	11		
LODGING	SB	BAYMONT SUITES	4		
		SLEEP INN & SUITES	8		

GAS - EXIT 188
5 7

16'H×13'W
W14×30 A572
B650 - #2, #2

LODGING - EXIT 188
8 4

14'Hx13'W W12x26 A572 3M TYPE III B650 — #1, #1

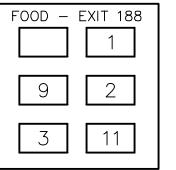

TABULATION OF QUANTITIES

ITEM UNIT QUANTITY

POST MOUNTED SIGNS, TYPE A, LOGO SQ.FT.

POST MOUNTED SIGNS, TYPE B, LOGO SQ.FT.

POST MOUNTED SIGNS, TYPE C, LOGO SQ.FT.

BREAKAWAY SYSTEMS EACH

\* STEEL S OR W BEAM POSTS LBS.

LOGO SIGN MOUNTING EACH

RESET POST MOUNTED SIGN, TYPE A EACH

EXTRUDED PANEL REPLACEMENT SQ. FT.

REMOVAL OF POST MOUNTED MOTORIST SERVICE SIGNS, TYPES B, C & F

\* APPROXIMATE QUANTITY FOR INFORMATION ONLY

4-0	LAC	KAWANNA	I-81			
C	ITY OF	SCRANTON	AND BOR	O OF	DUNI	ИOR
		RE	VISIONS			
	SYM	IBOLS				
	<u> </u>	<u>IDOLO</u>				

COUNTY


ROUTE PROJECT

SHEET

- O Existing Sign to Remain
- △ Existing Sign to be Removed □ Existing Sign Reset as Shown
- NEW SIGN

DISTRICT

- × FUTURE SIGN
- Ø Existing Utility Pole

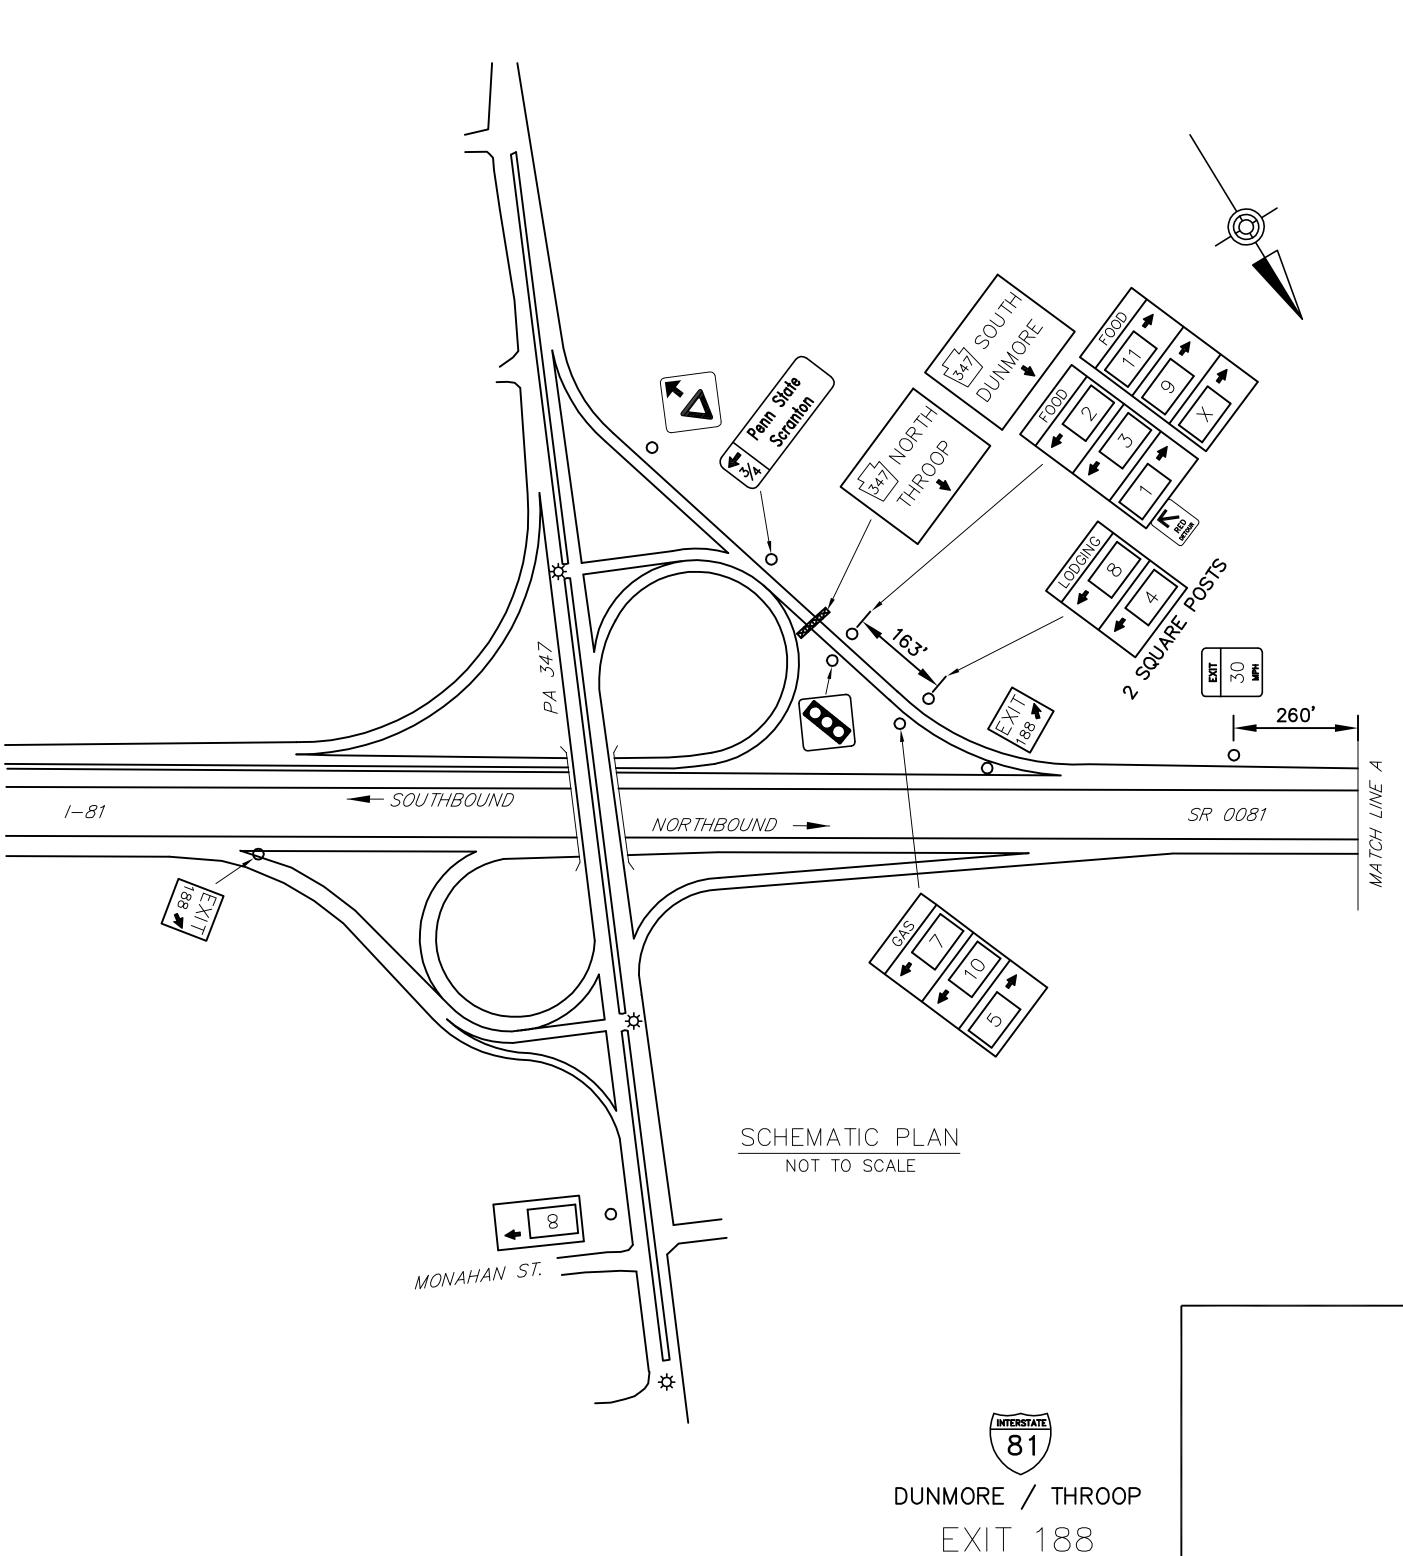

O:\2015JOBS\215076-01\HW\PSE\AS-BUILT DRAWINGS\PENNDOT DISTRICT 04\LACKA June/26/2023 12:58 PM