
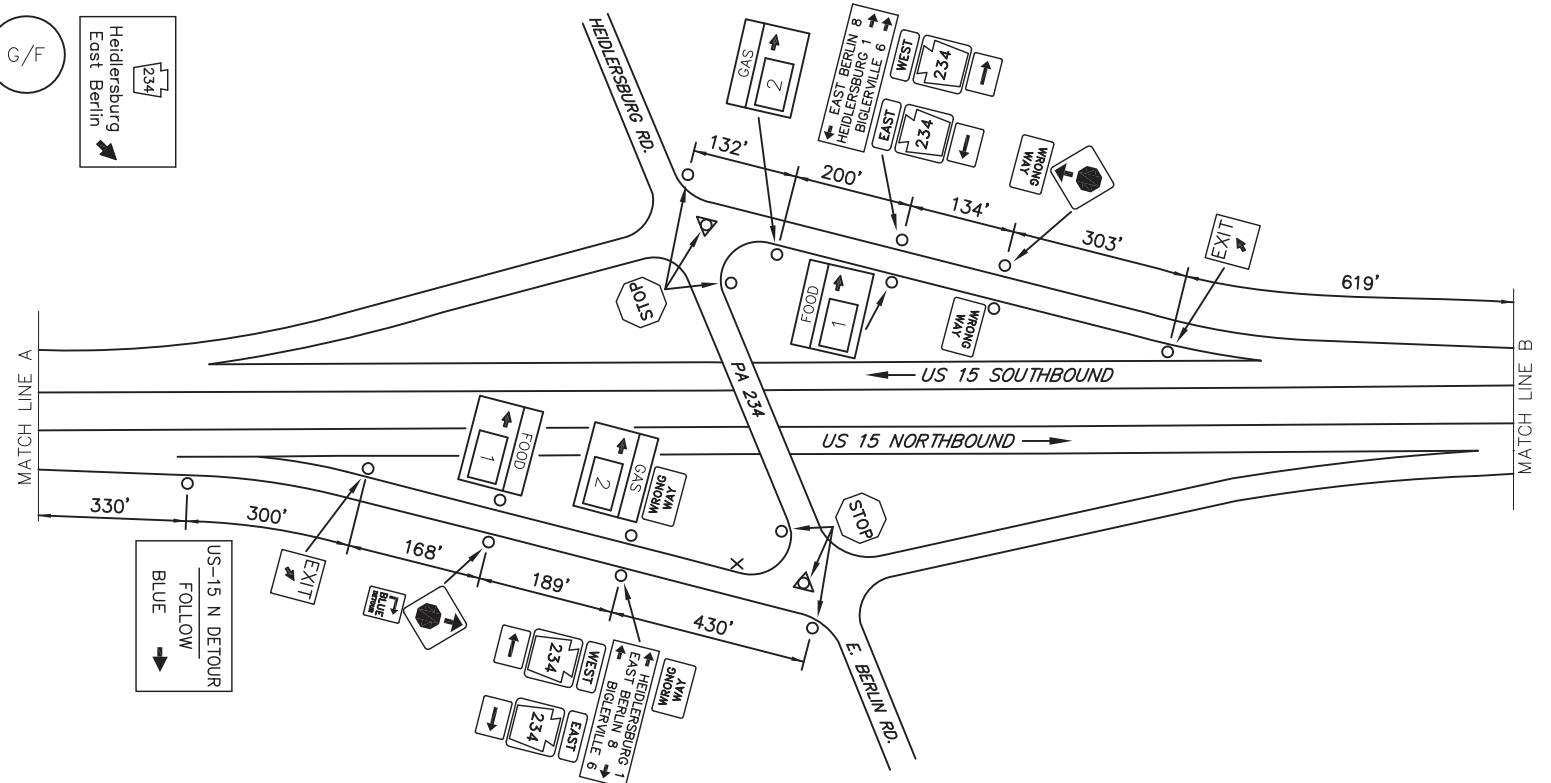


DISTRICT	COUNTY	ROUTE	PROJECT	SHEET
8-0	ADAMS	U.S. 15	HUNTINGTON & TYRONE TOWNSHIPS	
REVISIONS				


ITEM	UNIT	QUANTITY
POST MOUNTED SIGNS, TYPE A, LOGO	SQ.FT.	-
POST MOUNTED SIGNS, TYPE B, LOGO	SQ.FT.	-
POST MOUNTED SIGNS, TYPE C, LOGO	SQ.FT.	-
BREAKAWAY SYSTEMS	EACH	-
* STEEL S OR W BEAM POSTS	LBS.	-
LOGO SIGN MOUNTING	EACH	-
EXTRUDED PANEL REPLACEMENT	SQ.FT.	-
REMOVAL OF POST MOUNTED MOTORIST SERVICE SIGNS, TYPES B, C & F	L.S.	-

○	Existing Sign to Remain
△	Existing Sign to be Removed
□	Existing Sign Reset as Shown
●	NEW SIGN
×	FUTURE SIGN
∅	Existing Utility Pole

* APPROXIMATE QUANTITY FOR INFORMATION ONLY

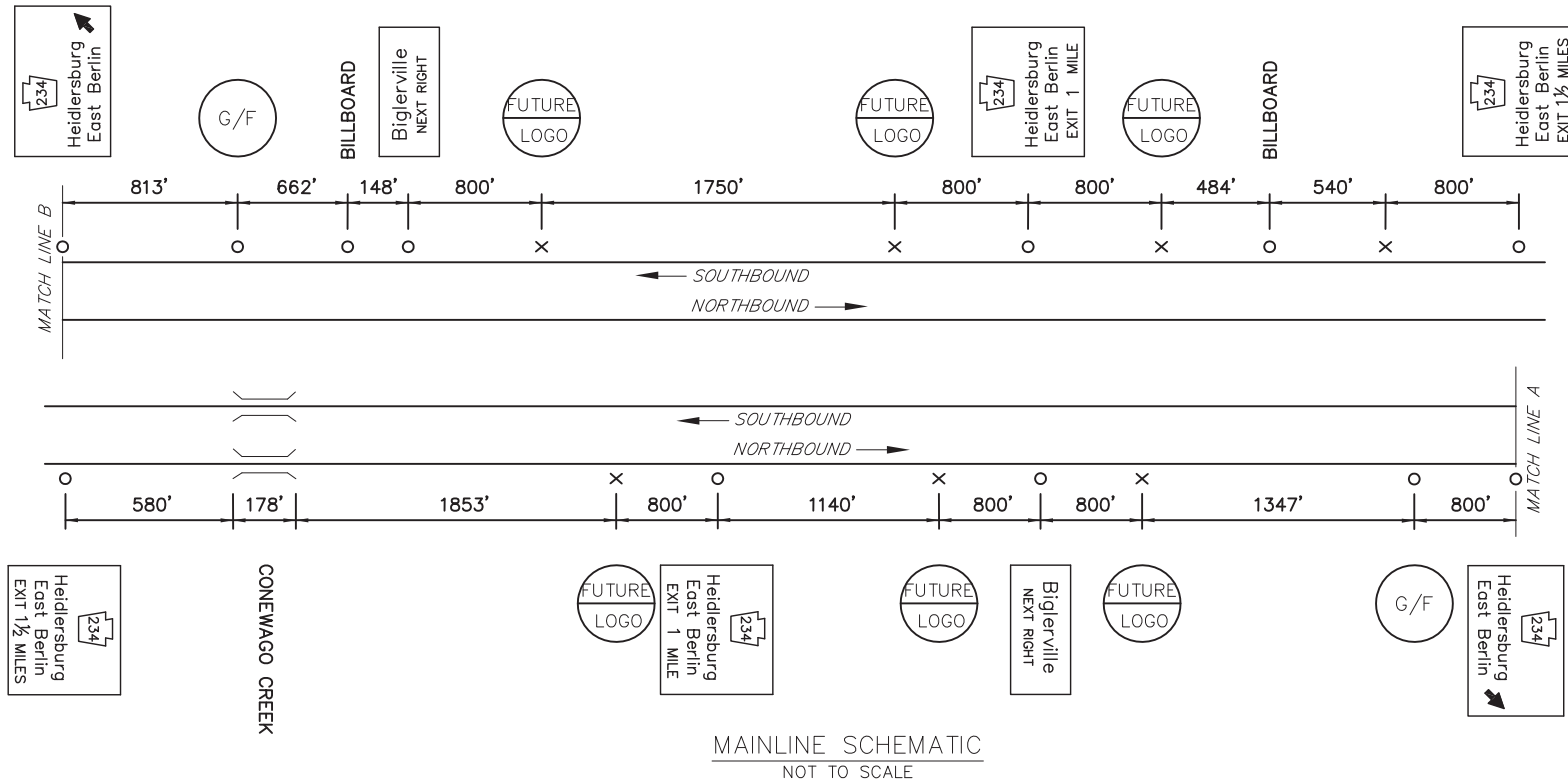

LEGEND	DIRECTION	BUSINESS	LOGO. NO.
FOOD	NB/SB	RUTTER'S (24 HRS)	1
GAS	NB/SB	RUTTER'S (24 HRS/DIESEL)	2

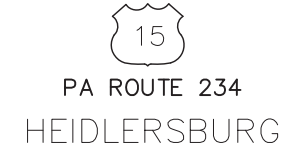

I:\projects\1505-15\1505-15_VIA_PVE_AS-BUILT_DRAWINGS\VENDOT_DISTRICT_08\ADAMS - 01\10-00_SITING-US15_HEIDLERSBURG_EXIT_PLAN.dwg 7/1/2013 3:10 PM