
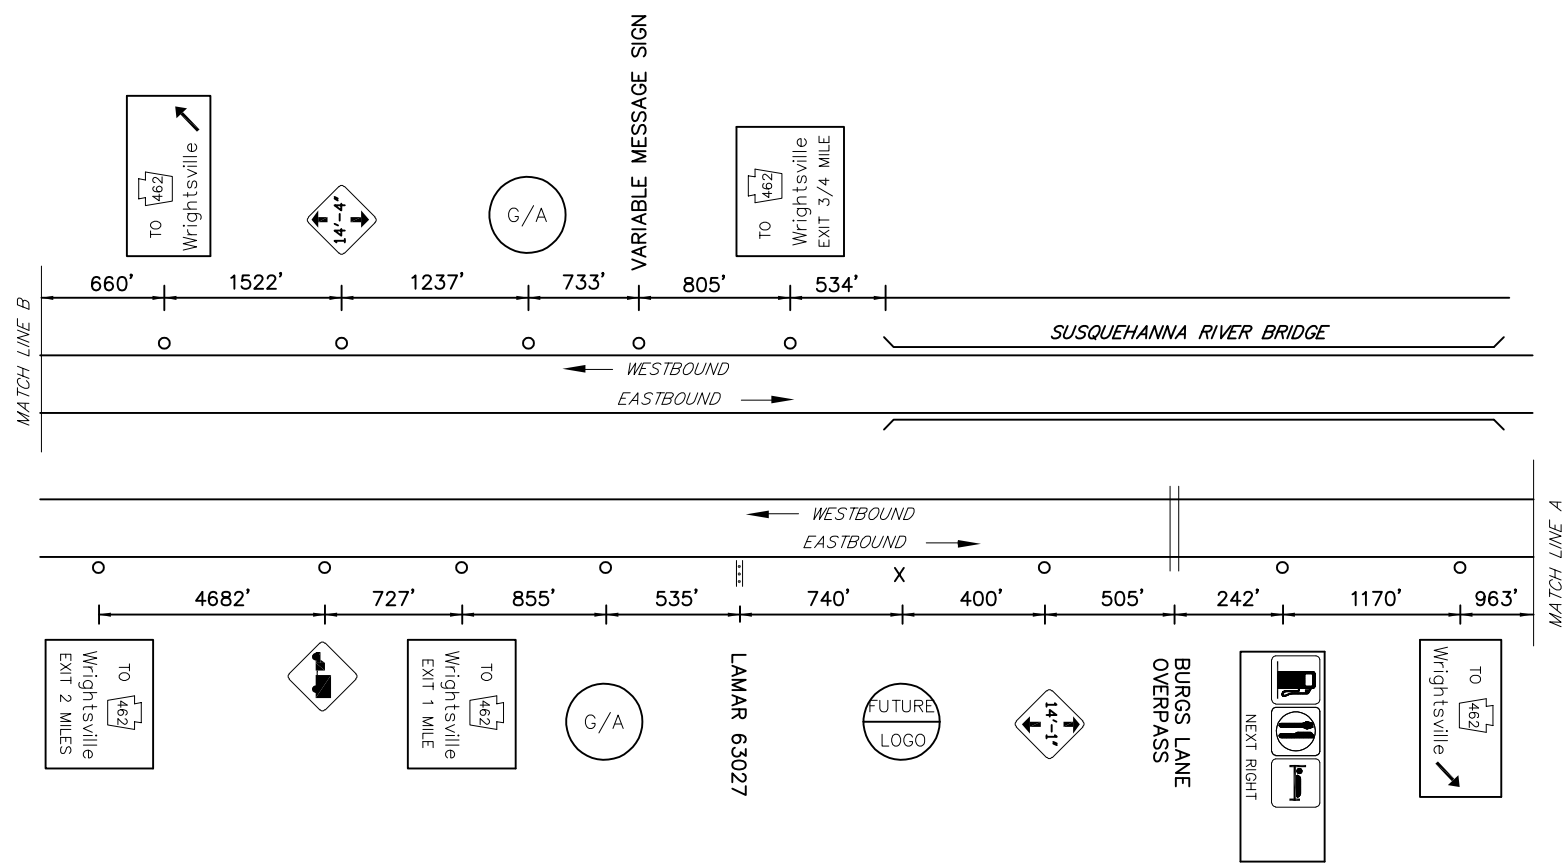


| DISTRICT | COUNTY | ROUTE | PROJECT | SHEET |
|------------------------------|--------|-------|---------|-------|
| 8-0 | YORK | US 30 | | |
| HELLAM AND WINDSOR TOWNSHIPS | | | | |
| REVISIONS | | | | |
| | | | | |
| | | | | |
| | | | | |

| ITEM | UNIT | QUANTITY |
|--|--------|----------|
| POST MOUNTED SIGNS, TYPE A, LOGO | SQ.FT. | |
| POST MOUNTED SIGNS, TYPE B, LOGO | SQ.FT. | |
| POST MOUNTED SIGNS, TYPE C, LOGO | SQ.FT. | |
| BREAKAWAY SYSTEMS | EACH | |
| * STEEL S OR W BEAM POSTS | LBS. | |
| LOGO SIGN MOUNTING | EACH | |
| REMOVAL OF POST MOUNTED MOTORIST SERVICE SIGNS, TYPES A & E | EACH | |
| REMOVAL OF POST MOUNTED MOTORIST SERVICE SIGNS, TYPES B, C & F | L.S. | |

* APPROXIMATE QUANTITY FOR INFORMATION ONLY

| | |
|---|------------------------------|
| ○ | Existing Sign to Remain |
| △ | Existing Sign to be Removed |
| ◻ | Existing Sign Reset as Shown |
| ● | NEW SIGN |
| × | FUTURE SIGN |
| ⊗ | Existing Utility Pole |

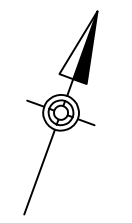


MAINLINE SCHEMATIC
NOT TO SCALE


LEGEND
2S - GUIDE RAIL

NOTE:
FREEWAY LANE CLOSURES
ONLY PERMITTED BETWEEN
10:00 PM AND 6:00 AM.

| LEGEND | DIRECTION | BUSINESS | LOGO NO. |
|------------|-----------|--------------------------|----------|
| GAS | EB/WB | RUTTER'S (24 HRS/DIESEL) | 3 |
| | | ROYAL FARMS (DIESEL) | 4 |
| ATTRACTION | EB/WB | | |

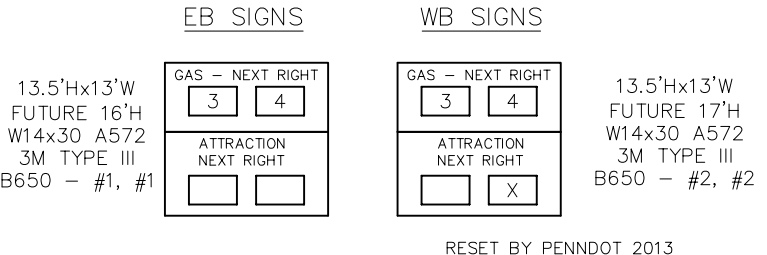

RESET BY PENNDOT 2013

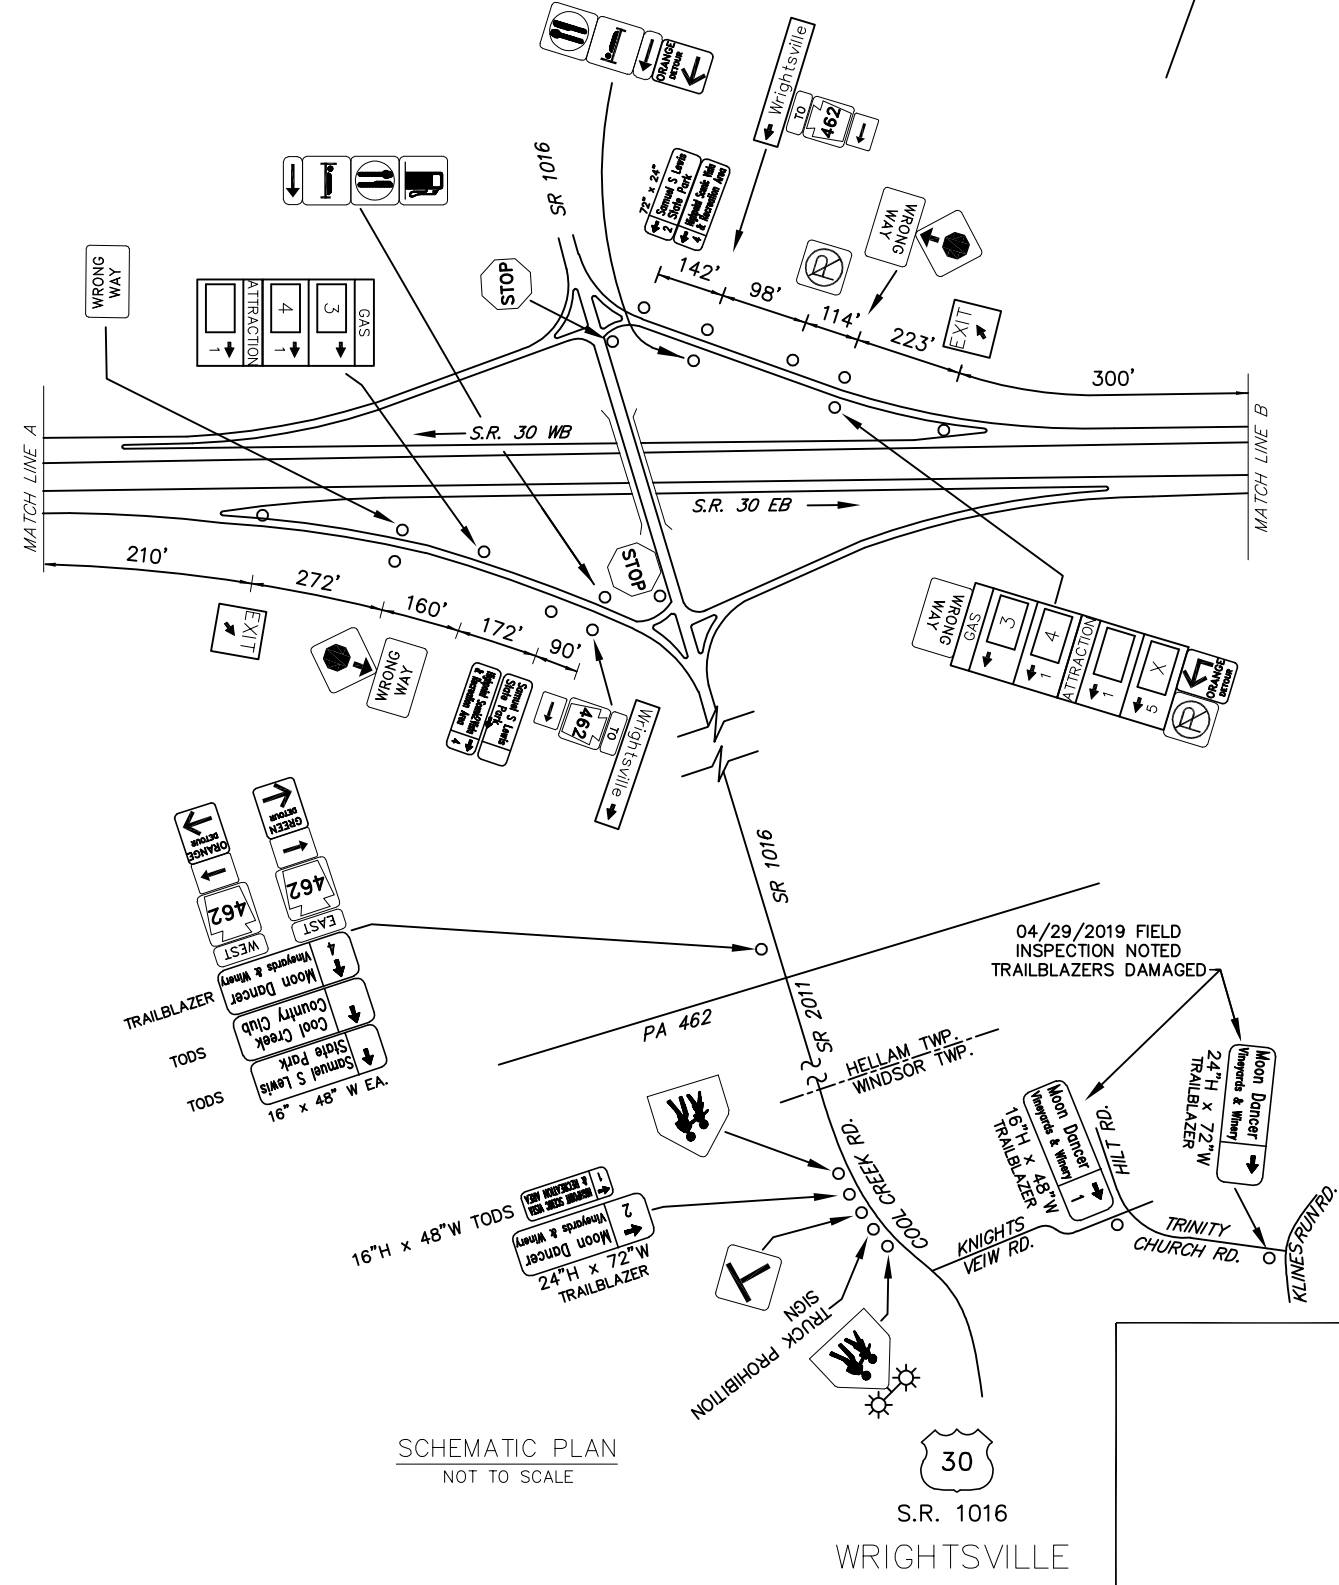

SCHEMATIC PLAN
NOT TO SCALE

30
S.R. 1016
WRIGHTSVILLE

I:\PROJECTS\2019\PA 462\PROJECTS\2019\PA 462\AS-BUILT\DRAWINGS\PENNDOT\DISTRICT 8R\YORK - 6410-KI-SMTX-CUSB-WRIGHTSVILLE PLAN
 January 7, 2019 09:28:18 AM