


DISTRICT	COUNTY	ROUTE	PROJECT	SHEET
5-0	MONROE	I-380		
BORO OF MOUNT POCONO				
COOLBAUGH & TOBYHANNA TOWNSHIPS				
REVISIONS				

- SYMBOLS**
- Existing Sign to Remain
  - △ Existing Sign to be Removed
  - ◻ Existing Sign Reset as Shown
  - NEW SIGN
  - ✕ FUTURE SIGN
  - ∅ Existing Utility Pole

**TABULATION OF QUANTITIES**

ITEM	UNIT	QUANTITY
POST MOUNTED SIGNS, TYPE A, LOGO	SQ.FT.	
POST MOUNTED SIGNS, TYPE B, LOGO	SQ.FT.	
POST MOUNTED SIGNS, TYPE C, LOGO	SQ.FT.	
BREAKAWAY SYSTEMS	EACH	
* STEEL S OR W BEAM POSTS	LBS.	
LOGO SIGN MOUNTING	EACH	
FLAT SHEET PANEL REPLACEMENT	SQ.FT.	
EXTRUDED PANEL REPLACEMENT	SQ.FT.	
REMOVAL OF POST MOUNTED MOTORIST SERVICE SIGNS, TYPES B, C & F	L.S.	

\* APPROXIMATE QUANTITY FOR INFORMATION ONLY

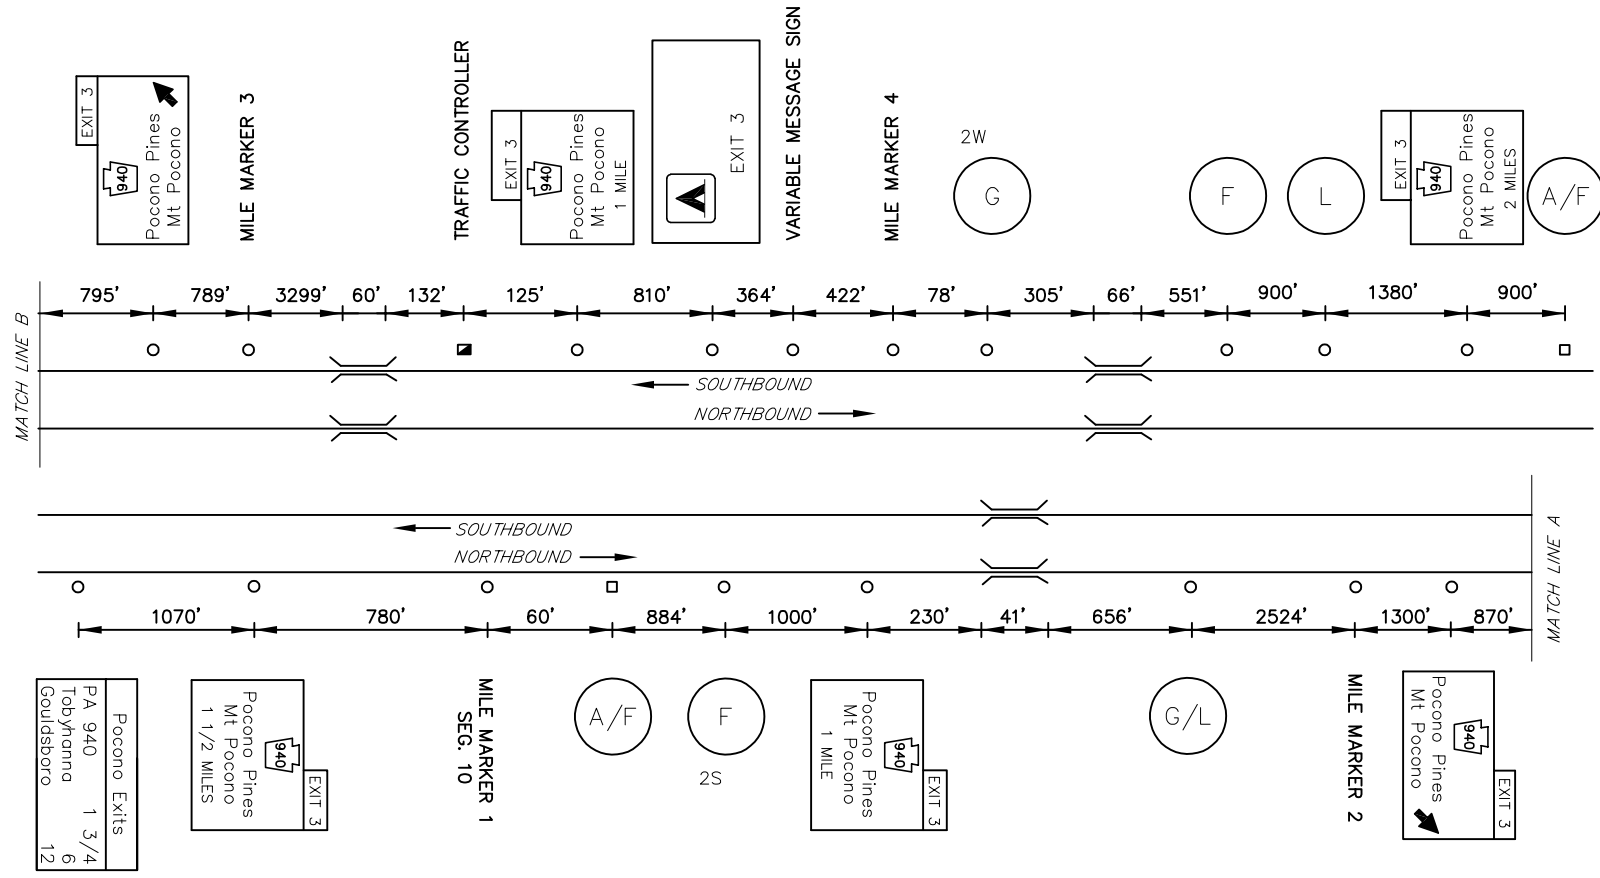

MAINLINE SCHEMATIC  
NOT TO SCALE

**LEGEND**

2S/2W - GUIDE RAIL

DO NOT CLOSE OR RESTRICT TRAVEL LANES BETWEEN 6:00 AM & 9:00 AM, AND BETWEEN 3:00 PM & 6:00 PM MONDAY THRU FRIDAY.

NO WORK PERMITTED ON POCONO RACEWAY EVENT DATES.

DO NOT WORK DURING HOLIDAY PERIODS.


LEGEND	DIRECTION	BUSINESS	LOGO NO.
GAS	NB/SB		
FOOD	NB/SB	BURGER KING	3
		KFC	2
		McDONALD'S (24 HRS)	5
		WENDY'S	1
		PERKINS FAMILY RESTAURANT-BAKERY	8
		SUBWAY	4
		STARBUCKS	6
LODGING	NB/SB	HOTEL MOUNT POCONO	7
		COMFORT INN & SUITES	9
		THE INN AT POCONO MANOR	12
ATTRACTION	NB/SB	MOUNT AIRY CASINO - RESORT	10
		KALAHARI RESORTS	13

1-MILE EXTENSION OF DISTANCE CRITERIA APPLIES PER PUB. 46 SEC. 1.22.4.2(b)


**NB SIGNS**



12'Hx19'W  
FUTURE 14'H  
W12x26 A572  
3M TYPE III  
B650 - #2, #2

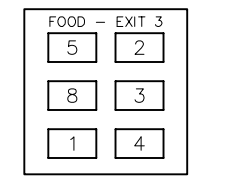


14'Hx13'W  
W10x26 A572  
3M TYPE III  
B650 - #2, #1  
08/8/2019 FIELD INSPECTION NOTED EXPOSED REBAR ON BOTH FOUNDATIONS

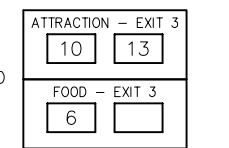


12'Hx13'W  
FUTURE 16'H  
W10x26 A572  
TYPE IX LEGEND  
TYPE III BACKGROUND  
B650 - #1, #2


**SB SIGNS**

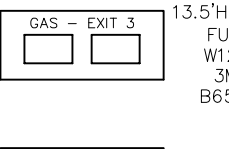


6'Hx13'W  
13.5'H TOP SECTION  
FUTURE 12'H  
W12x26 A572  
3M TYPE III  
B650 - #1 #1

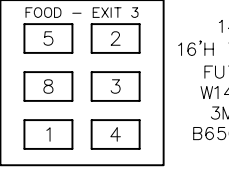


14'Hx13'W  
16'H TOP SECTION  
FUTURE 16'H  
W14x30 A572  
3M TYPE III  
B650 - #2, #1

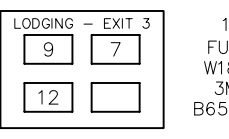

10'Hx13'W  
FUTURE 16'H  
W18x40 A572  
3M TYPE III  
B650 - #2, #2

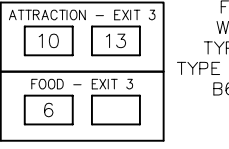

12'H x 13'W  
FUTURE 16'H  
W14x30 A572  
TYPE IX LEGEND  
TYPE III BACKGROUND  
B650 - #1 #1

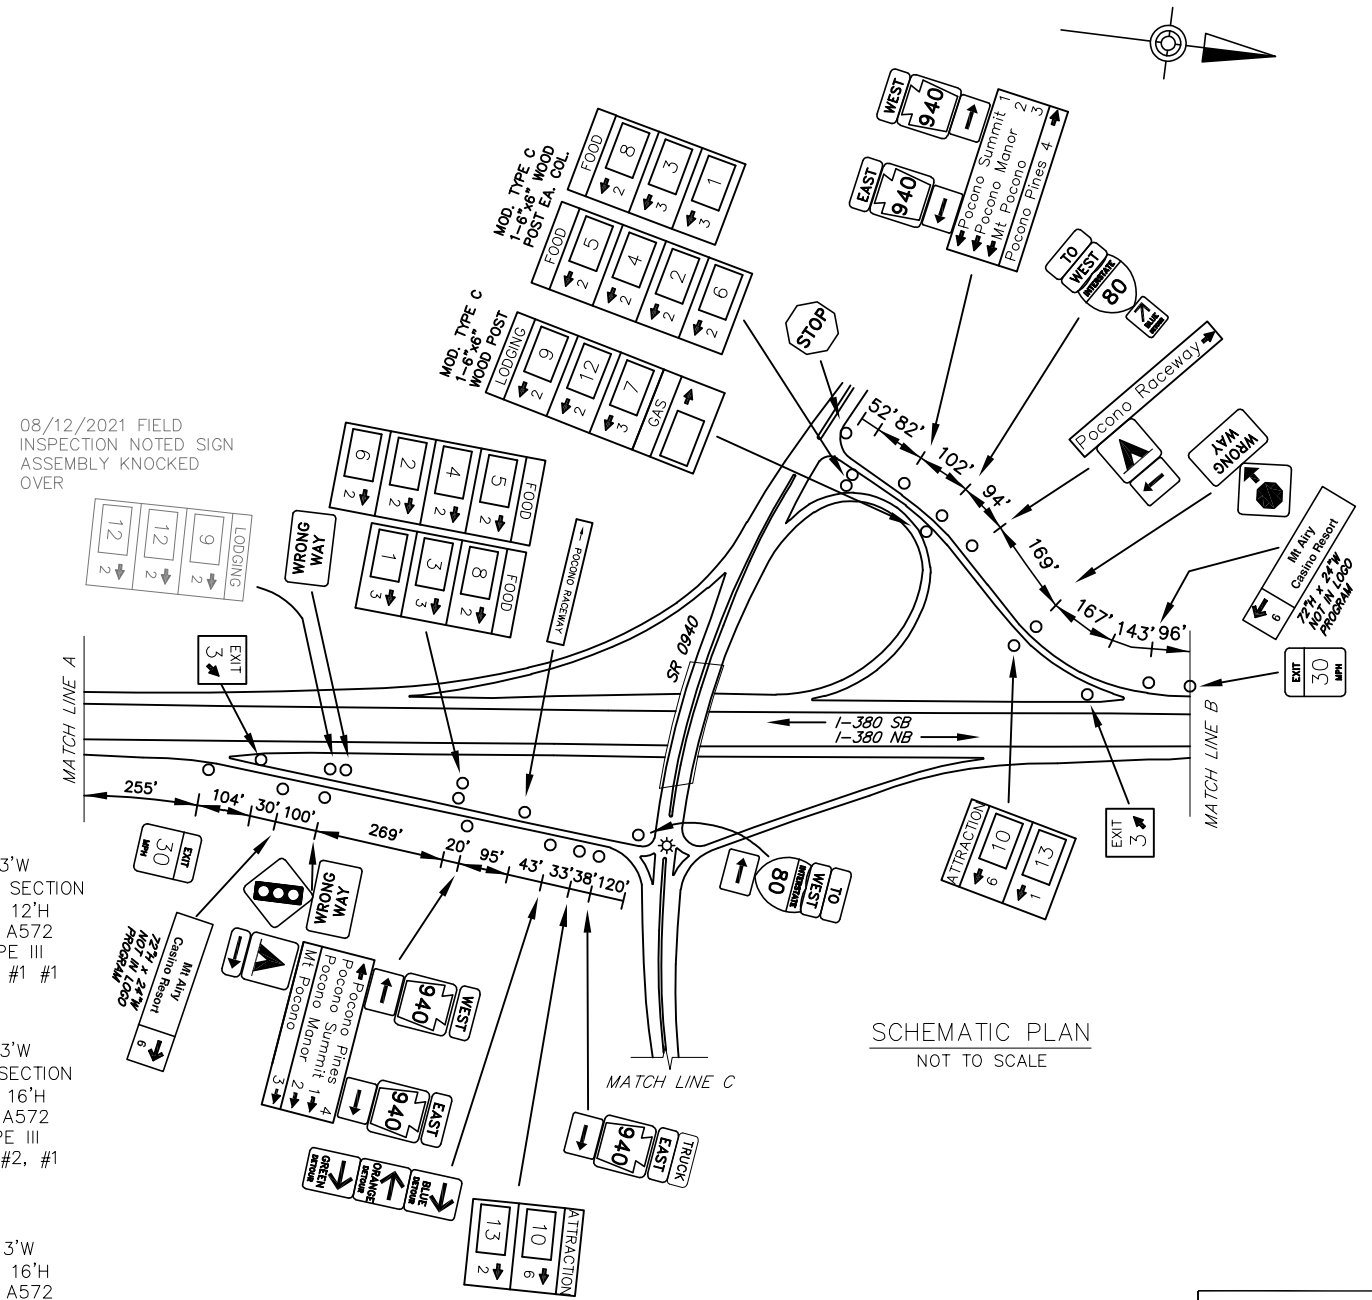

SCHEMATIC PLAN  
NOT TO SCALE






SR 0940 (MT POCONO)  
EXIT 3  
SHEET 1 OF 2 THIS EXIT

\\sawtooth\cadd\paw\proj\2021\5076-DISTRICTS\5076-DISTRICTS\5076-DR\WAP\5076-DR-BUILD.DWG - 4510-DWG - SHEET: 1-380-EXIT 3 - PLAN - 08/25/2021 9:09 AM

DISTRICT	COUNTY	ROUTE	PROJECT	SHEET
5-0	MONROE	1-380		
BORO OF MOUNT POCONO COOLBAUGH & TOBYHANNA TOWNSHIPS REVISIONS				

SYMBOLS	
○	Existing Sign to Remain
△	Existing Sign to be Removed
□	Existing Sign Reset as Shown
●	NEW SIGN
×	FUTURE SIGN
⊗	Existing Utility Pole

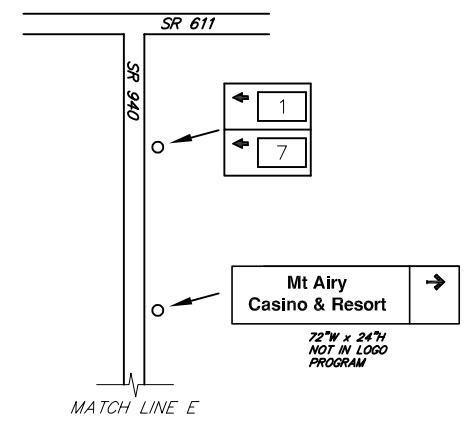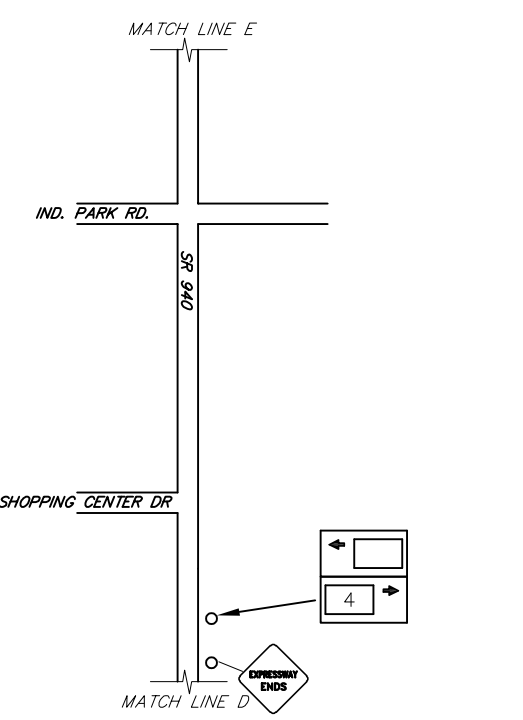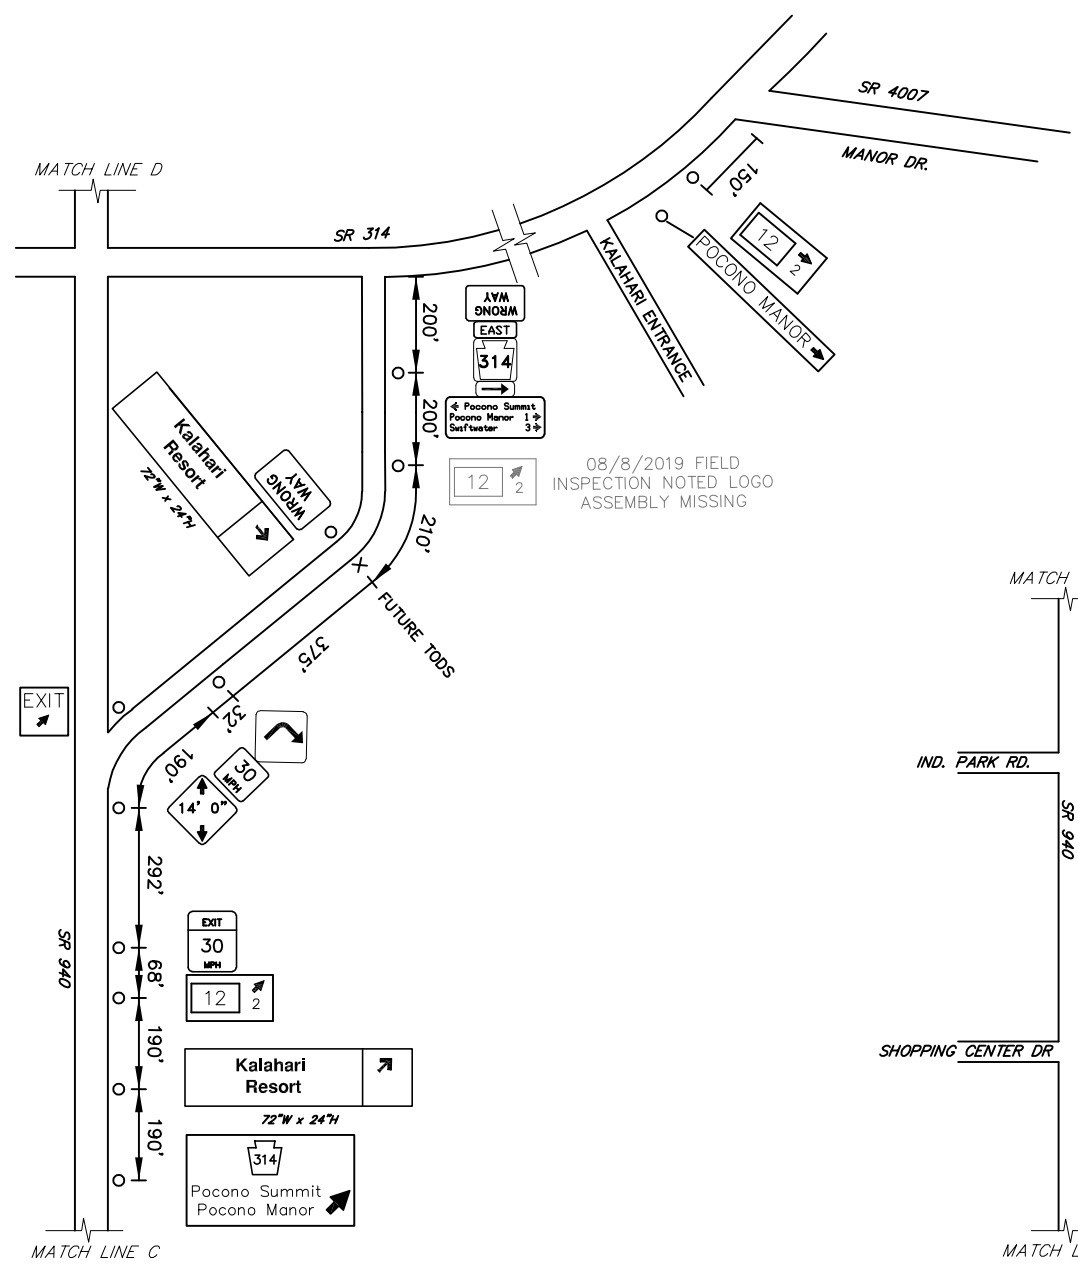

TOBYHANNA TOWNSHIP

BOROUGH OF MOUNT POCONO

BOROUGH OF MOUNT POCONO

FOOD	BURGER KING	3
	KFC	2
	McDONALD'S (24 Hours)	5
	WENDY'S	1
	PERKINS FAMILY RESTAURANT-BAKERY	8
	SUBWAY	4
LODGING	STARBUCKS	6
	HOTEL MOUNT POCONO	7
	COMFORT INN & SUITES	9
ATTRACTION	THE INN AT POCONO MANOR	12
	MOUNT AIRY CASINO - RESORT	10
	KALAHARI RESORTS	13

SCHEMATIC PLAN  
NOT TO SCALE

MT POCONO  
EXIT 3  
SHEET 2 OF 2 THIS EXIT

V:\PROJECTS\2018\STATE PROJECTS\2018\525076-01\MAPS\AS-BUILT DRAWINGS\PERMITS DISTRICT 05\MCH01E - 45101-001\_S17XX-1380L\_EXIT 3 PLAN.dwg  
 07/19/2018 4:07 PM