





DISTRICT	COUNTY	ROUTE	PROJECT	SHEET
4-0	LUZERNE	I-81		
CITY OF WILKES-BARRE & HANOVER TOWNSHIP REVISIONS				

SYMBOLS	
○	Existing Sign to Remain
△	Existing Sign to be Removed
□	Existing Sign Reset as Shown
●	NEW SIGN
×	FUTURE SIGN
∅	Existing Utility Pole

TABULATION OF QUANTITIES		
ITEM	UNIT	QUANTITY
POST MOUNTED SIGNS, TYPE A, LOGO	SQ.FT.	-
POST MOUNTED SIGNS, TYPE A, LOGO (MODIFIED)	SQ.FT.	-
POST MOUNTED SIGNS, TYPE C, LOGO	SQ.FT.	-
BREAKAWAY SYSTEMS	EACH	-
* STEEL S OR W BEAM POSTS	LBS.	-
LOGO SIGN MOUNTING	EACH	-
LOGO SIGN MOUNTING, RESET	EACH	-
REMOVAL OF POST MOUNTED MOTORIST SERVICE SIGNS, TYPES A & E	EACH	-
REMOVAL OF POST MOUNTED MOTORIST SERVICE SIGNS, TYPES B, C & F	L.S.	-


\* APPROXIMATE QUANTITY FOR INFORMATION ONLY

- NOTES**
- REPLACE EXISTING LOGOS THAT ARE CLOUDED.
  - RESET EXISTING LOGOS ON NEW PANEL AS SHOWN.

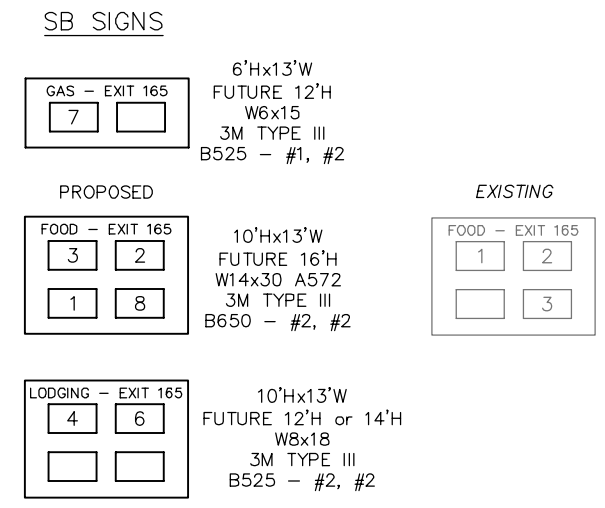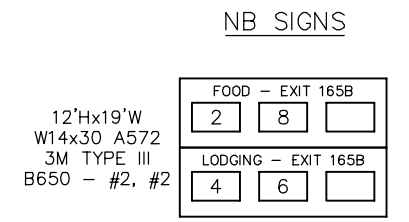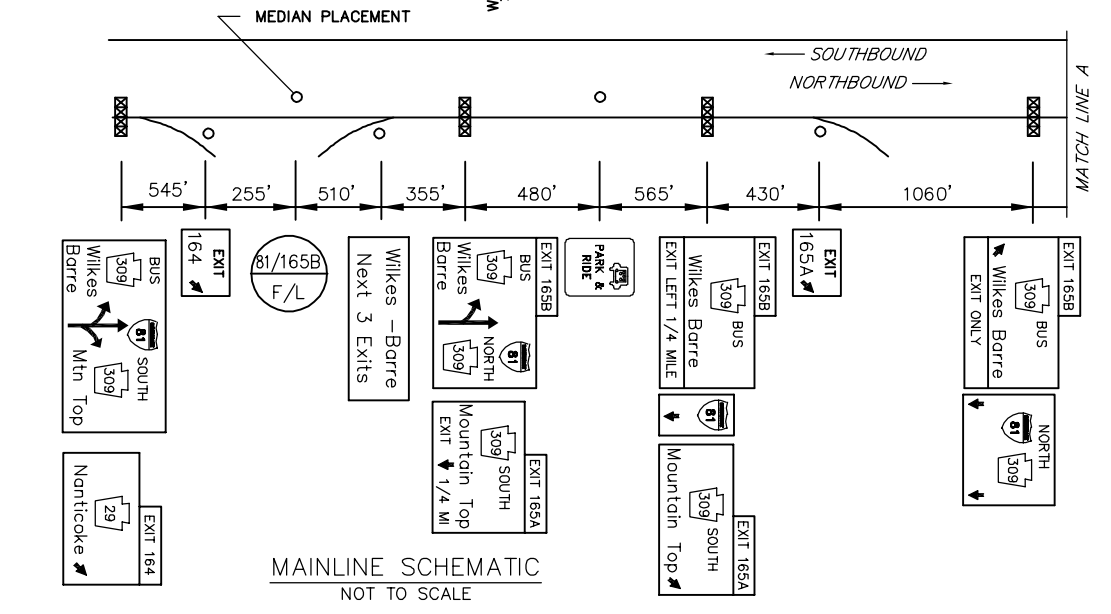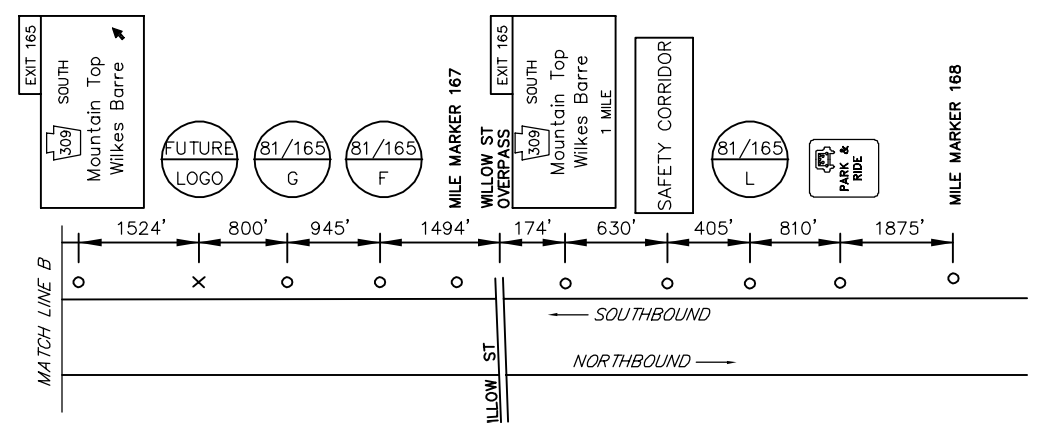

EXIT 165 SPECIFIC INFORMATION PANEL			
LEGEND	DIRECTION	BUSINESS	LOGO NO.
GAS	NB/SB	CITGO	7
FOOD	NB/SB	PERKINS RESTAURANT & BAKERY	2
		BURGER KING	8
	SB	McDONALD'S	1
		DUNKIN' DONUTS	3
		ECONO LODGE	4
LODGING	NB/SB	COMFORT INN & SUITES	6

FREEWAY LANE CLOSURES & RESTRICTIONS ONLY PERMITTED BETWEEN 9:00 PM AND 6:00 AM MONDAY THRU FRIDAY.  
WORK ALONG FREEWAY PERMITTED BETWEEN 9:00 AM AND 2:30 PM, UNLESS OTHERWISE APPROVED BY ENGINEERING DISTRICT.  
DO NOT WORK DURING HOLIDAY PERIODS.  
IF APPLICABLE, REINSTALL GUIDERAIL AT END OF EACH DAY.

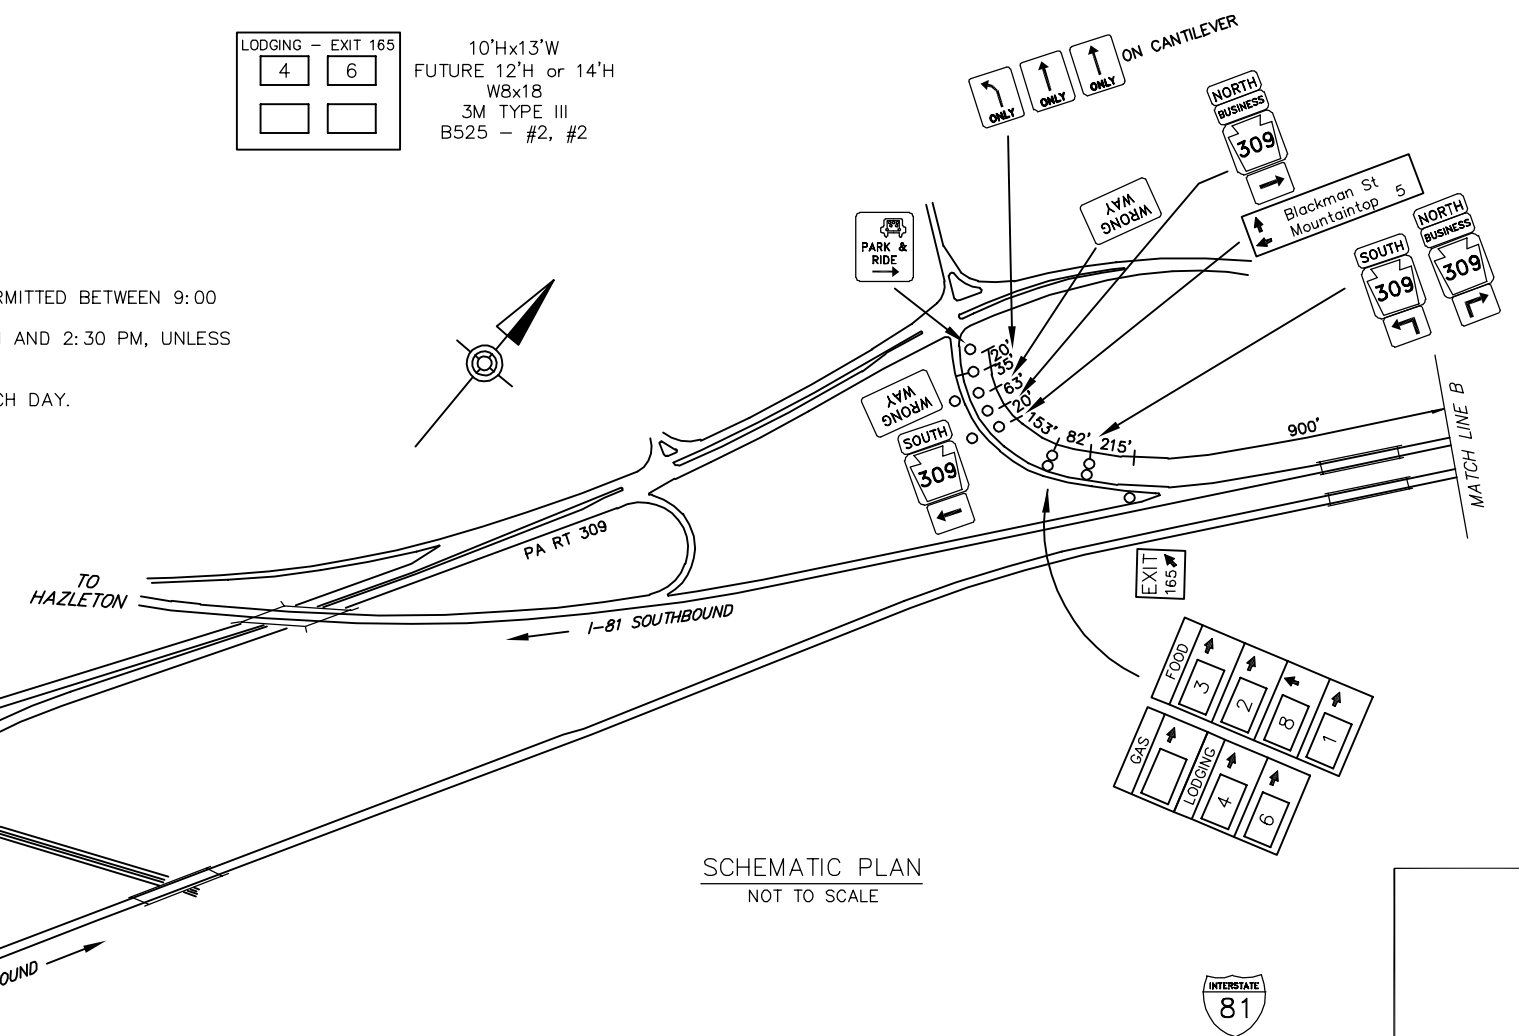

**SCHEMATIC PLAN**  
NOT TO SCALE



\SBE-MANUAL-DRAWING-FACTS-VENIS-DBS-201705-01\WAP\SEAS-BUILT DRAWINGS\PERMIDT DISTRICT GALLUZENE - 4010-XX-SHT-XX-161-EXIT-165 PLAN  
 JAMES J. BROWN, P.E.  
 JANUARY 25, 2018 2:52 PM