


DISTRICT	COUNTY	ROUTE	PROJECT	SHEET
9-0	CAMBRIA	U.S. 219		
RICHLAND TOWNSHIP REVISIONS				

TABULATION OF QUANTITIES		
ITEM	UNIT	QUANTITY
POST MOUNTED SIGNS, TYPE A, LOGO	SQ.FT.	-
POST MOUNTED SIGNS, TYPE B, LOGO	SQ.FT.	-
BREAKAWAY SYSTEMS	EACH	-
* STEEL W BEAM BREAKAWAY POSTS	LBS.	-
LOGO SIGN MOUNTING	EACH	-


* APPROXIMATE QUANTITY FOR INFORMATION ONLY

SYMBOLS	
○	Existing Sign to Remain
△	Existing Sign to be Removed
□	Existing Sign Reset as Shown
○	NEW SIGN
×	FUTURE SIGN
⊗	Existing Utility Pole

SB NOT ELIGIBLE - INSUFFICIENT SPACE

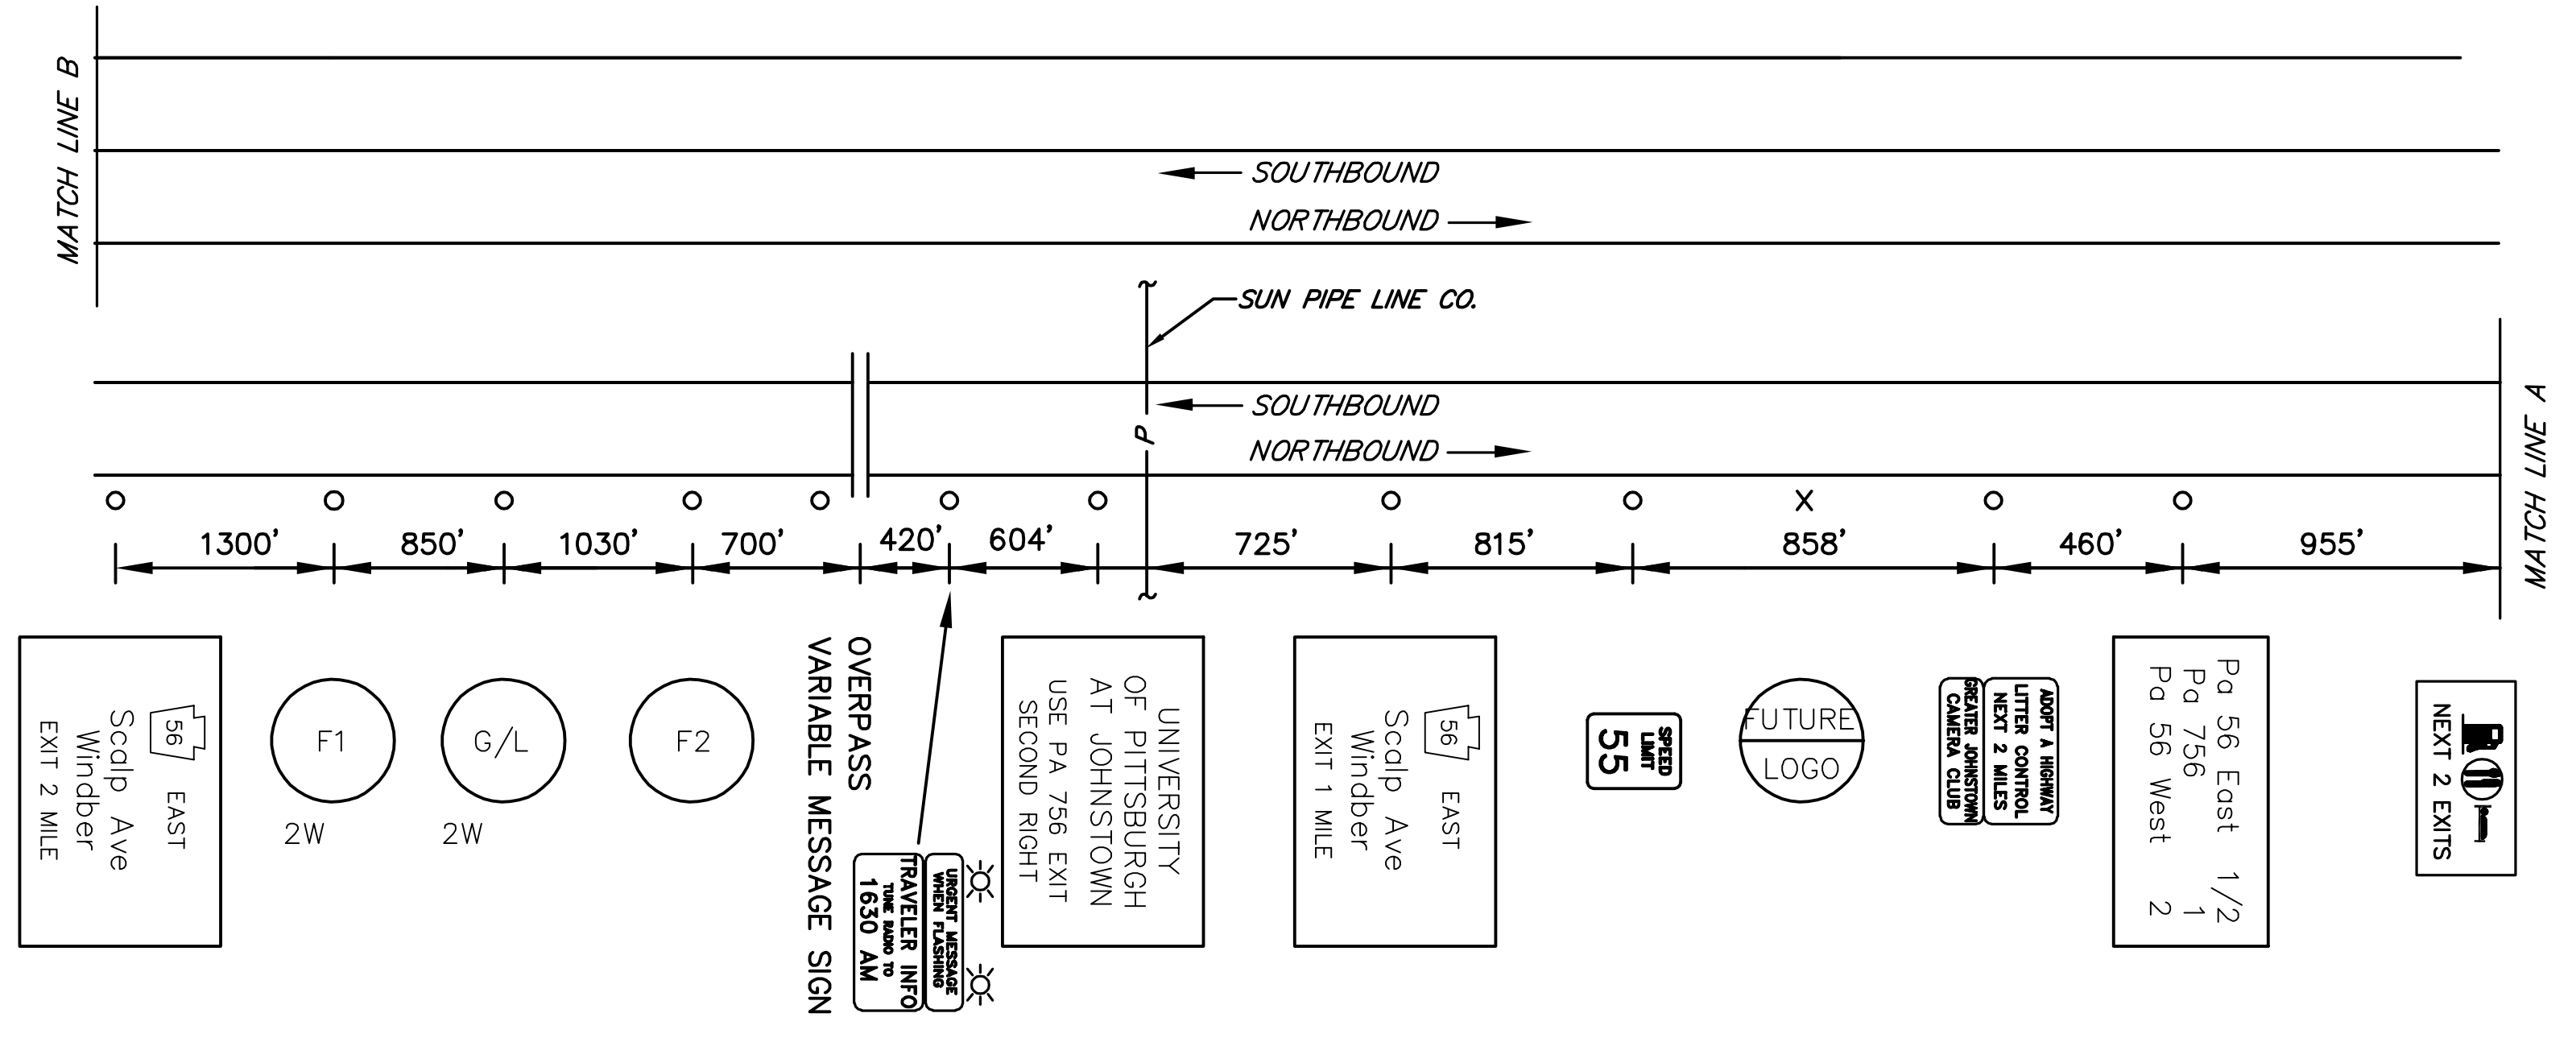

MAINLINE SCHEMATIC
NOT TO SCALE

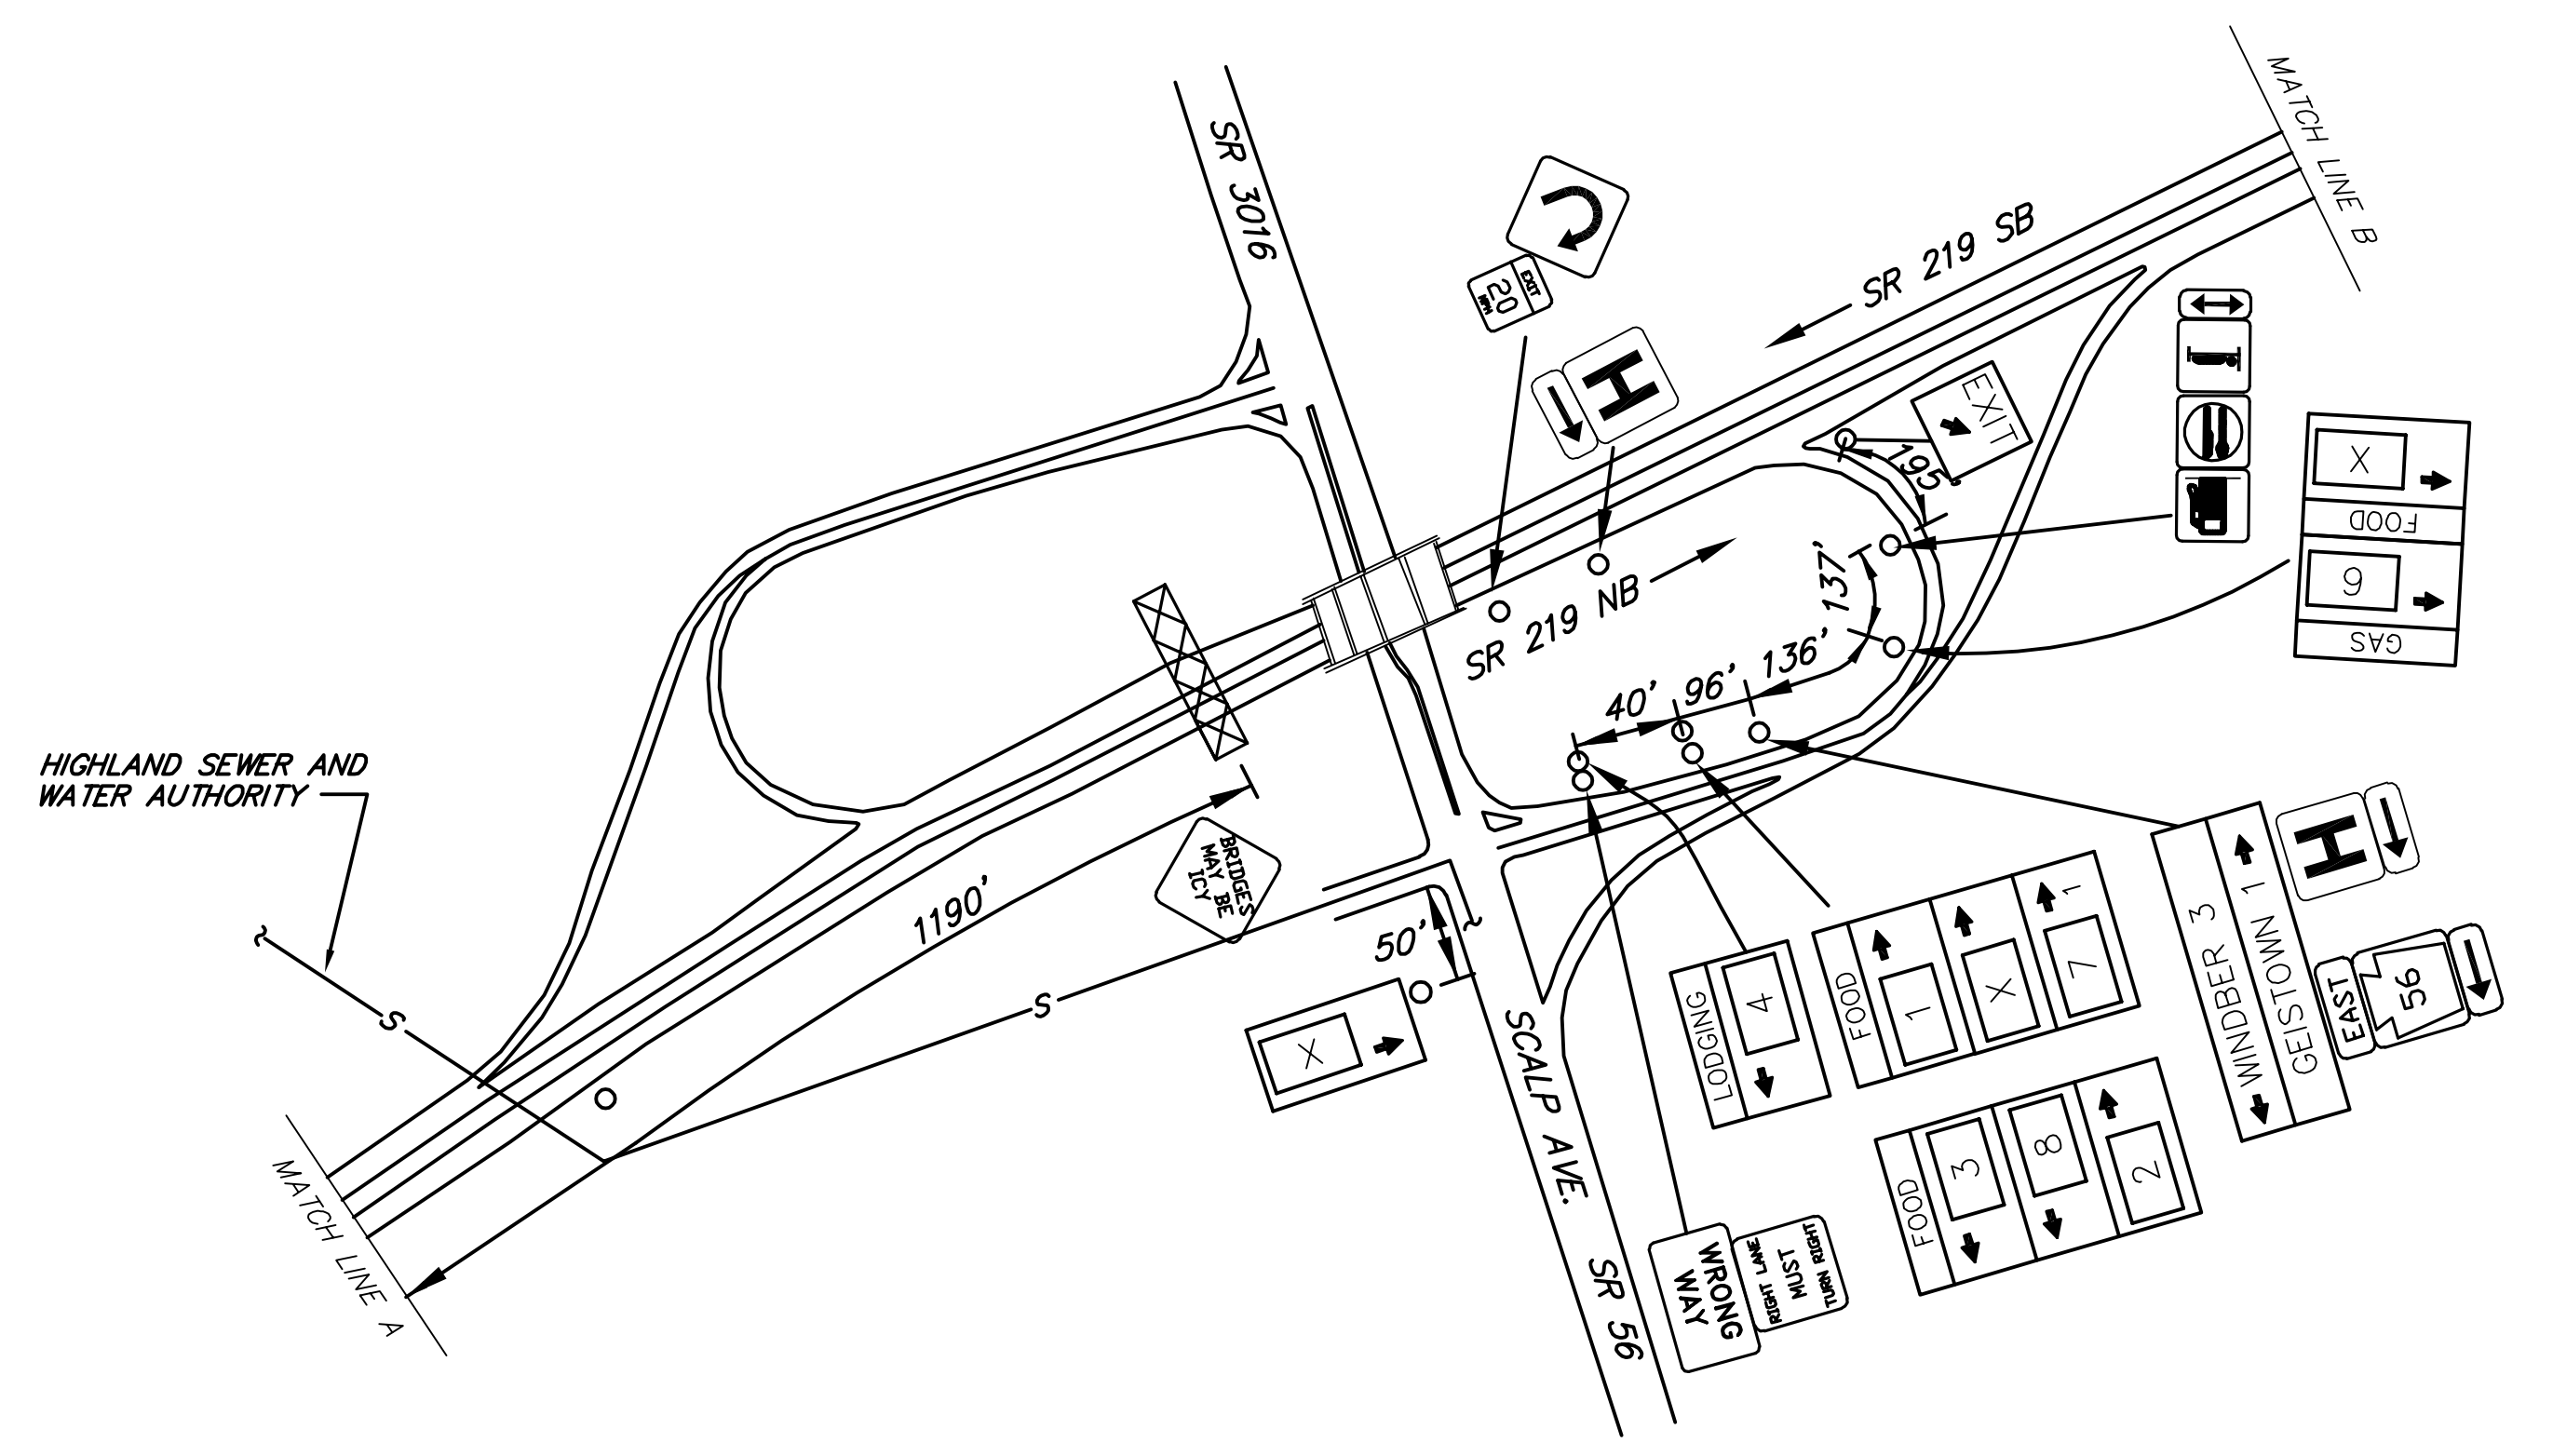

SCHEMATIC PLAN
NOT TO SCALE


LEGEND

2W - GUIDE RAIL


CALL RICHLAND TWP. ZONING OFFICER AT 617-226-2922 TO SPOT SIGN PLACEMENT IN FIELD. STRICT ADHERENCE TO TWP. REQUIREMENTS MUST BE MET.

WINDBER SPECIFIC INFORMATION PANEL			
LEGEND	DIRECTION	BUSINESS	LOGO NO.
GAS	NB	SHEETZ	6
		WENDY'S	2
FOOD	NB	DUNKIN'	3
		McDONALD'S	7
		EAT'N PARK	8
		VALLEY DAIRY RESTAURANT	1
LODGING	NB	HOLIDAY INN EXPRESS	4


NB SIGNS

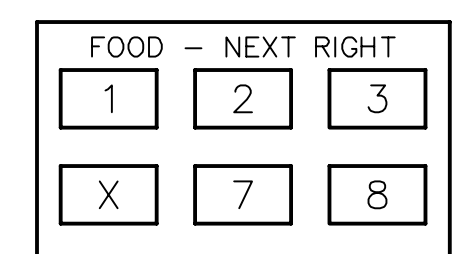

F2
10'H x 19'W
FUTURE 12'H
WBx21 A572
3M TYPE III
B525 - #2, #2

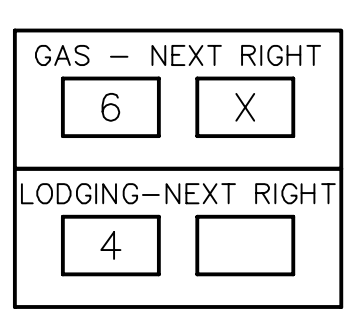

12'H x 13'W
FUTURE 15'H
W12x26 A572
3M TYPE III
B650 - #2, #1

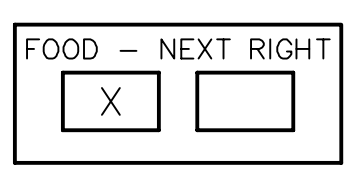

F1
6'H x 13'W
FUTURE 16'H
W14x30 A572
3M TYPE III
B650 - #4, #4



\S:\P\AN\PA\56\PA56\PROJECTS\2015\JBS\2015\2015-01\PA56\AS-BUILT\DRAWINGS\PERMITS\DISTRICT 09\CAMBRIA - 15\15-XX-SHTXK-03-WINDBER-EXT-PLAN February 19, 2015 10:43 AM