
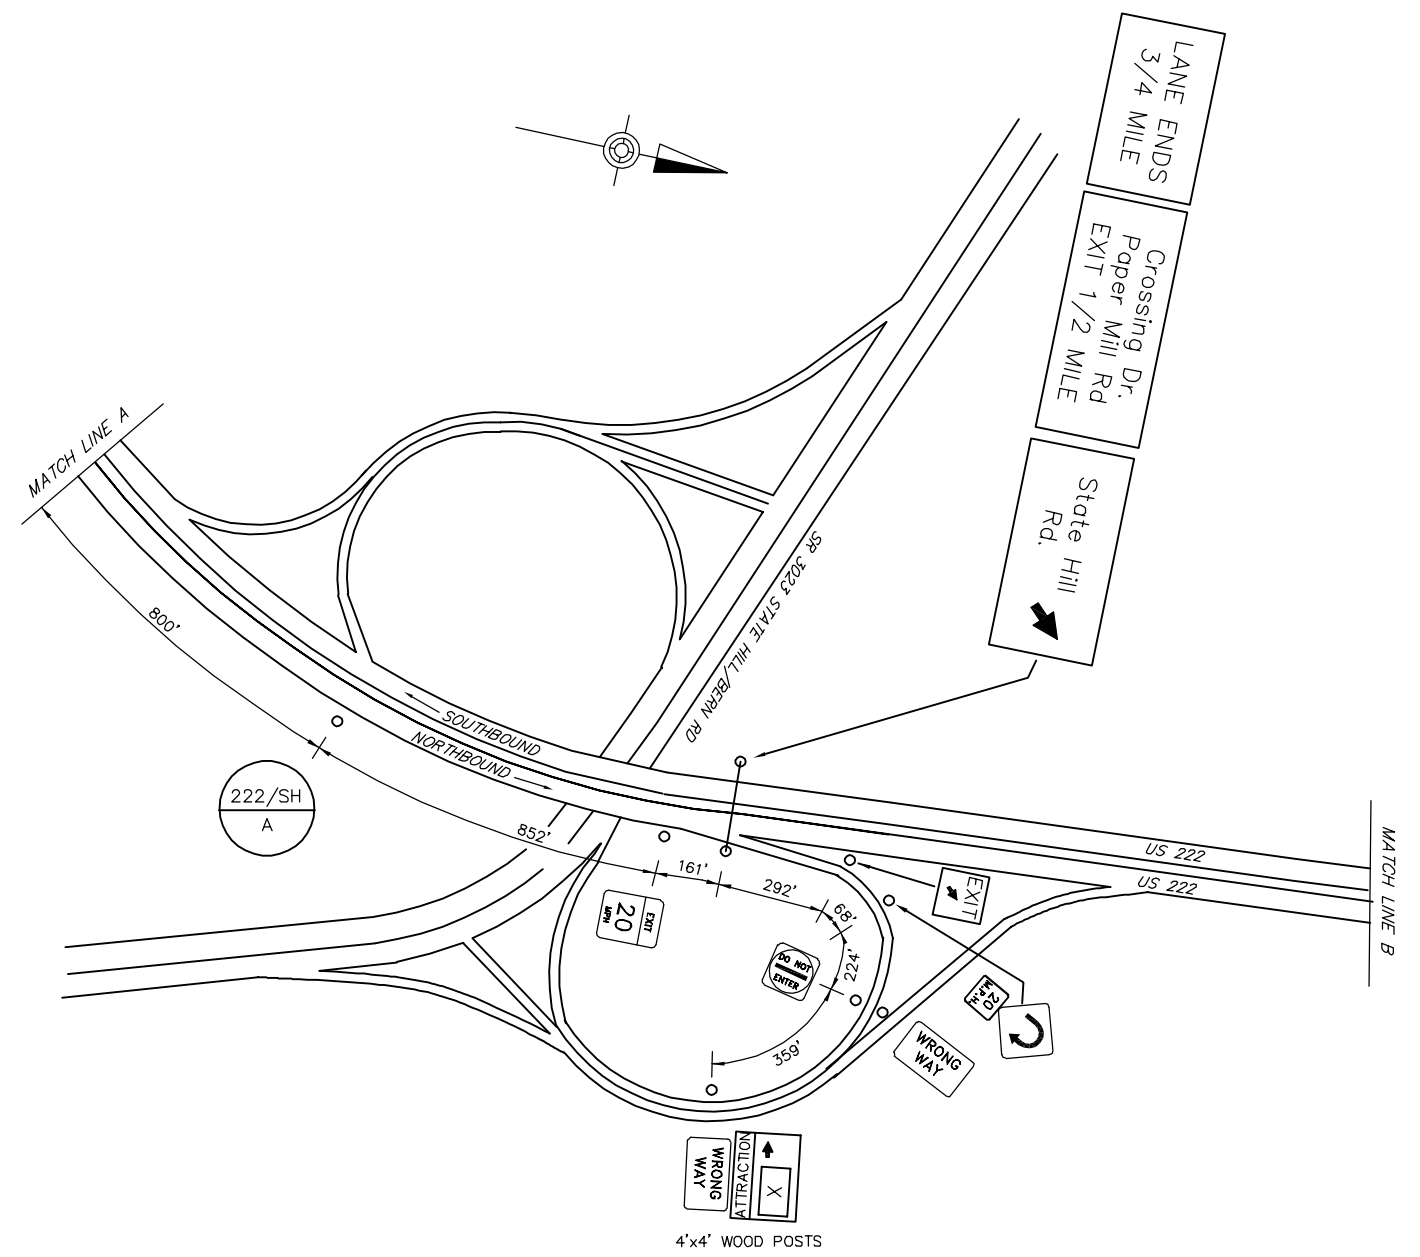


DISTRICT	COUNTY	ROUTE	PROJECT	SHEET
5-0	BERKS	SR-222		
WYOMISSING BORO REVISIONS				

SYMBOLS	
○	Existing Sign to Remain
△	Existing Sign to be Removed
◻	Existing Sign Reset as Shown
●	NEW SIGN
×	FUTURE SIGN
∅	Existing Utility Pole

TABULATION OF QUANTITIES		
ITEM	UNIT	QUANTITY
POST MOUNTED SIGNS, TYPE A, LOGO	SQ.FT.	
POST MOUNTED SIGNS, TYPE B, LOGO	SQ.FT.	
POST MOUNTED SIGNS, TYPE C, LOGO	SQ.FT.	
BREAKAWAY SYSTEMS	EACH	
* STEEL S OR W BEAM POSTS	LBS.	
LOGO SIGN MOUNTING	EACH	
REMOVAL OF POST MOUNTED MOTORIST SERVICE SIGNS, TYPES A & E	EACH	
REMOVAL OF POST MOUNTED MOTORIST SERVICE SIGNS, TYPES B, C & F	L.S.	

\* APPROXIMATE QUANTITY FOR INFORMATION ONLY

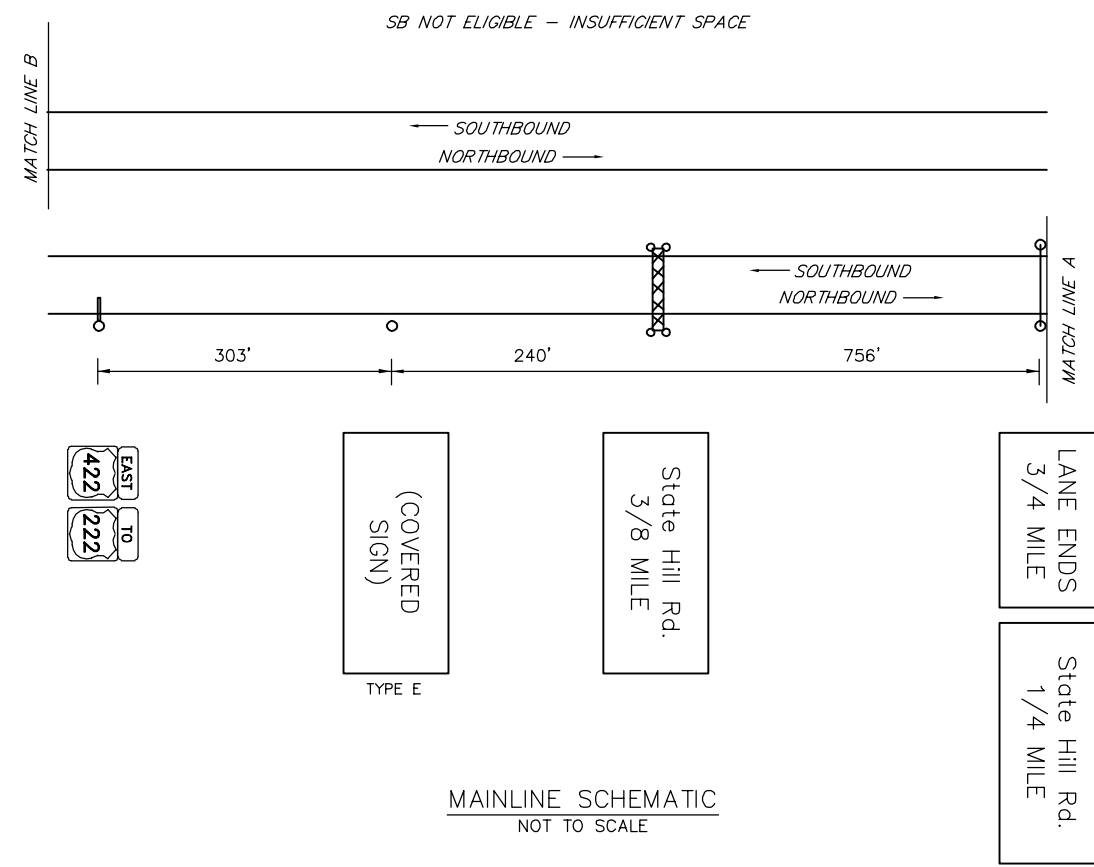

NOTE:  
LANE RESTRICTIONS AND LANE CLOSURES  
NOT PERMITTED 6:00 AM TO 9:00 AM  
AND 3:00 PM TO 6:00 PM MONDAY THRU  
FRIDAY.

STATE HILL RD EXIT SPECIFIC INFORMATION PANEL			
LEGEND	DIRECTION	BUSINESS	LOGO NO.
ATTRACTION	NB		

NB SIGNS  
6'Hx19'W  
FUTURE 12'H  
W12x26 A572  
ATTRACTION-NEXT RIGHT  
X □ □

S.R. 3023  
 STATE HILL ROAD

P:\VOTING\2012\12-15-12\WV\AS-BUILT DRAWINGS\VENNOT DISTRICT 05\BERKS - 05\10-KY SHHX-222- EXIT STATE HILL RD PLAN  
 10/23/12 10:24 PM