
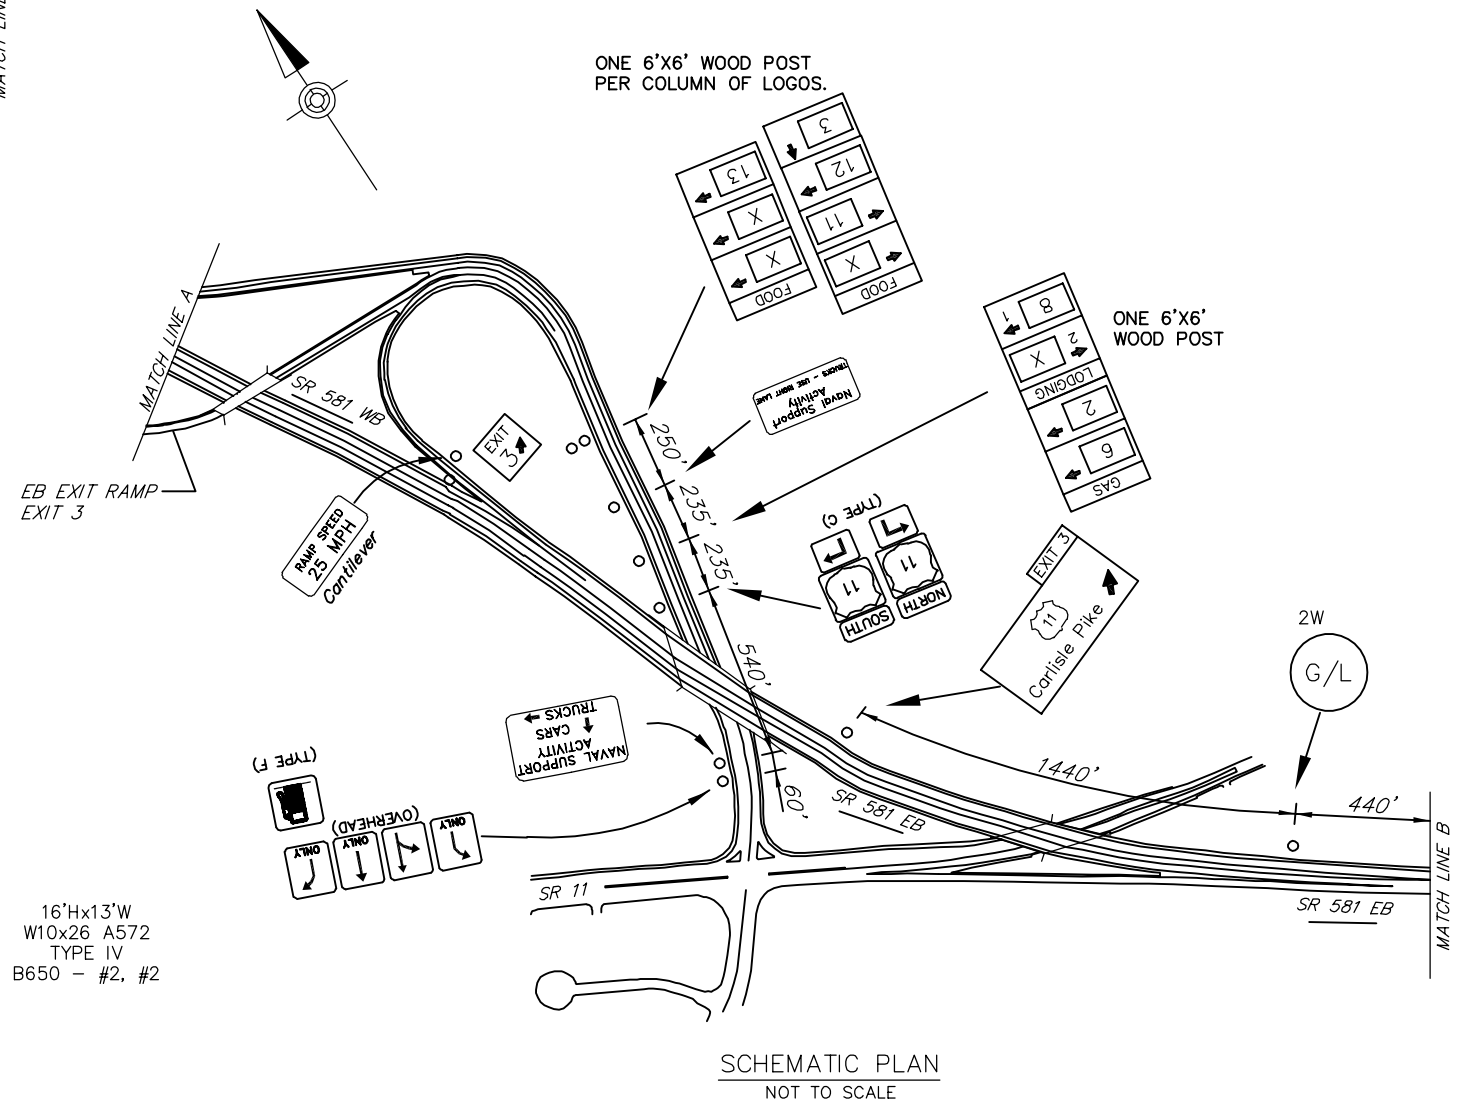


DISTRICT	COUNTY	ROUTE	PROJECT	SHEET
B-0	CUMBERLAND	SR 581		
HAMPDEN TOWNSHIP				
REVISIONS				


SYMBOLS	
○	Existing Sign to Remain
△	Existing Sign to be Removed
□	Existing Sign Reset as Shown
●	NEW SIGN
×	FUTURE SIGN
∅	Existing Utility Pole

TABULATION OF QUANTITIES		
ITEM	UNIT	QUANTITY
POST MOUNTED SIGNS, TYPE A, LOGO	SQ.FT.	390
POST MOUNTED SIGNS, TYPE B, LOGO	SQ.FT.	
POST MOUNTED SIGNS, TYPE C, LOGO	SQ.FT.	
BREAKAWAY SYSTEMS	EACH	
* STEEL S OR W BEAM POSTS	LBS.	
LOGO SIGN MOUNTING	EACH	
REMOVAL OF POST MOUNTED MOTORIST SERVICE SIGNS, TYPES A & E	EACH	
REMOVAL OF POST MOUNTED MOTORIST SERVICE SIGNS, TYPES B, C & F	L.S.	-

\* APPROXIMATE QUANTITY FOR INFORMATION ONLY

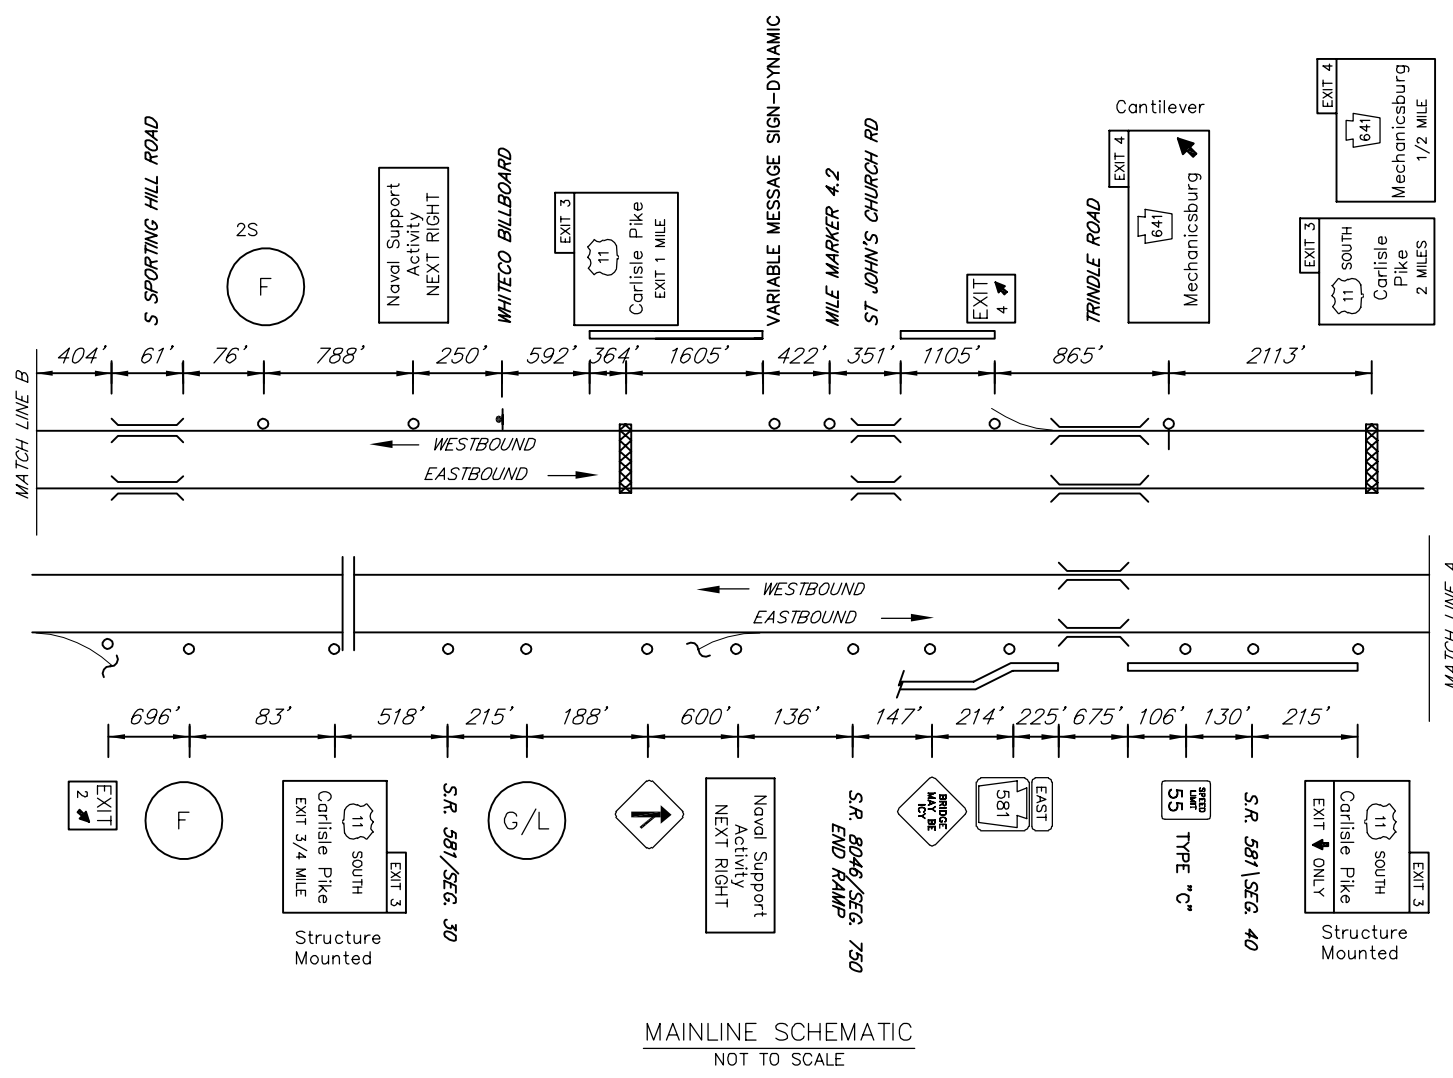

EXIT 3 SPECIFIC INFORMATION PANEL			
LEGEND	DIRECTION	BUSINESS	LOGO NO.
GAS	EB/WB	SUNOCO #7137	6
	WB	SHEETZ (DIESEL)	2
FOOD	EB/WB	BANGKOK WOK-THAI CUISINE	3
		GILLIGAN'S BAR & GRILL	11
		McDONALD'S	13
	EB	SHEETZ	12
	WB		
LODGING	EB/WB	HOLIDAY INN EXPRESS	8

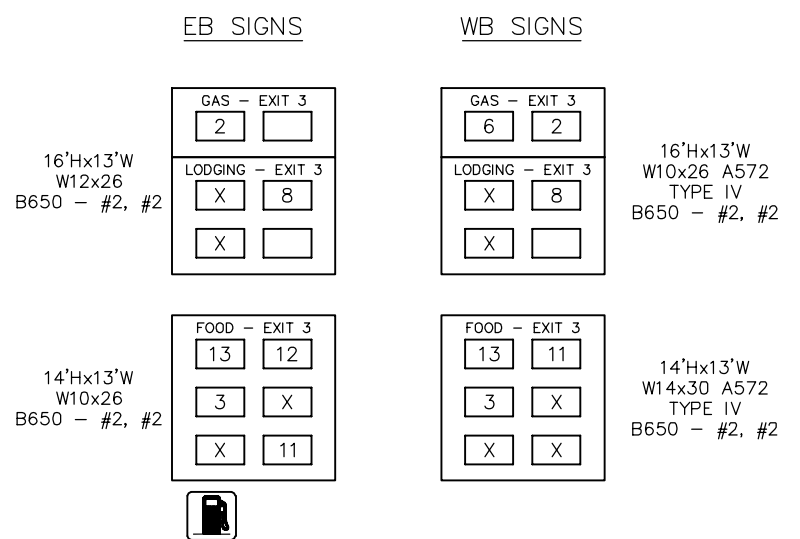

  
 581  
 CARLISLE PIKE  
 EXIT 3

\DRAWINGS\05\11\PROJECTS\2015\05\11\SR581\AS-BUILT\DRAWINGS\ENDNOT DISTRICT 08\CUMBERLAND - 21\10-XL-SR581-081 EXIT 3 PLAN.dwg 7/2022 11:44 AM