

DO NOT CLOSE OR RESTRICT TRAVEL LANES
BETWEEN 6:00 AM AND 9:00 AM, AND
BETWEEN 3:00 PM AND 6:00 PM, MONDAY THRU FRIDAY.
DO NOT WORK DURING HOLIDAY PERIODS.

11Th	H ST EXIT	SPECIFIC INFORMATION PANEL	
LEGEND	DIRECTION	BUSINESS	LOGO NO.
ATTRACTION	EB/WB	ALBRIGHT COLLEGE	2
ATTRACTION			

6'Hx13'W
FUTURE 12'H
W10x26
TYPE IX LEGEND
TYPE III BACKGROUND
B650 — #1, #1

ATTRACTION-NEXT RIGHT

2

X

EB SIGNS

ATTRACTION-NEXT RIGHT

2

X

WB SIGNS

6'Hx13'W
FUTURE 12'H
W8x21
TYPE IX LEGEND
TYPE III BACKGROUND
B525 — #1, #1


TABULATION OF QUANTIT	TES	
ITEM	UNIT	QUANTITY
POST MOUNTED SIGNS, TYPE A, LOGO	SQ.FT.	
POST MOUNTED SIGNS, TYPE B, LOGO	SQ.FT.	
POST MOUNTED SIGNS, TYPE C, LOGO	SQ.FT.	
BREAKAWAY SYSTEMS	EACH	
* STEEL S OR W BEAM POSTS	LBS.	
LOGO SIGN MOUNTING	EACH	
REMOVAL OF POST MOUNTED MOTORIST SERVICE SIGNS, TYPES A & E	EACH	
REMOVAL OF POST MOUNTED MOTORIST SERVICE SIGNS, TYPES B, C & F	L.S.	
* ADDROVIMATE OLIANTITY FOR INFORMATI	ON ONLY	

*	<b>APPROXIMATE</b>	<b>QUANTITY</b>	FOR	INFORMATION	ONLY
---	--------------------	-----------------	-----	-------------	------

DISTRICT	COUNTY	ROUTE	PROJECT	SHEET		
5-0	BERKS	PA-12				
	MUHLENBERG TOWNSHIP					
	RE	EVISIONS				
			_			
			•			

## **SYMBOLS**

- O Existing Sign to Remain
- △ Existing Sign to be Removed □ Existing Sign Reset as Shown
- NEW SIGN
  × FUTURE SIGN
- Ø Existing Utility Pole

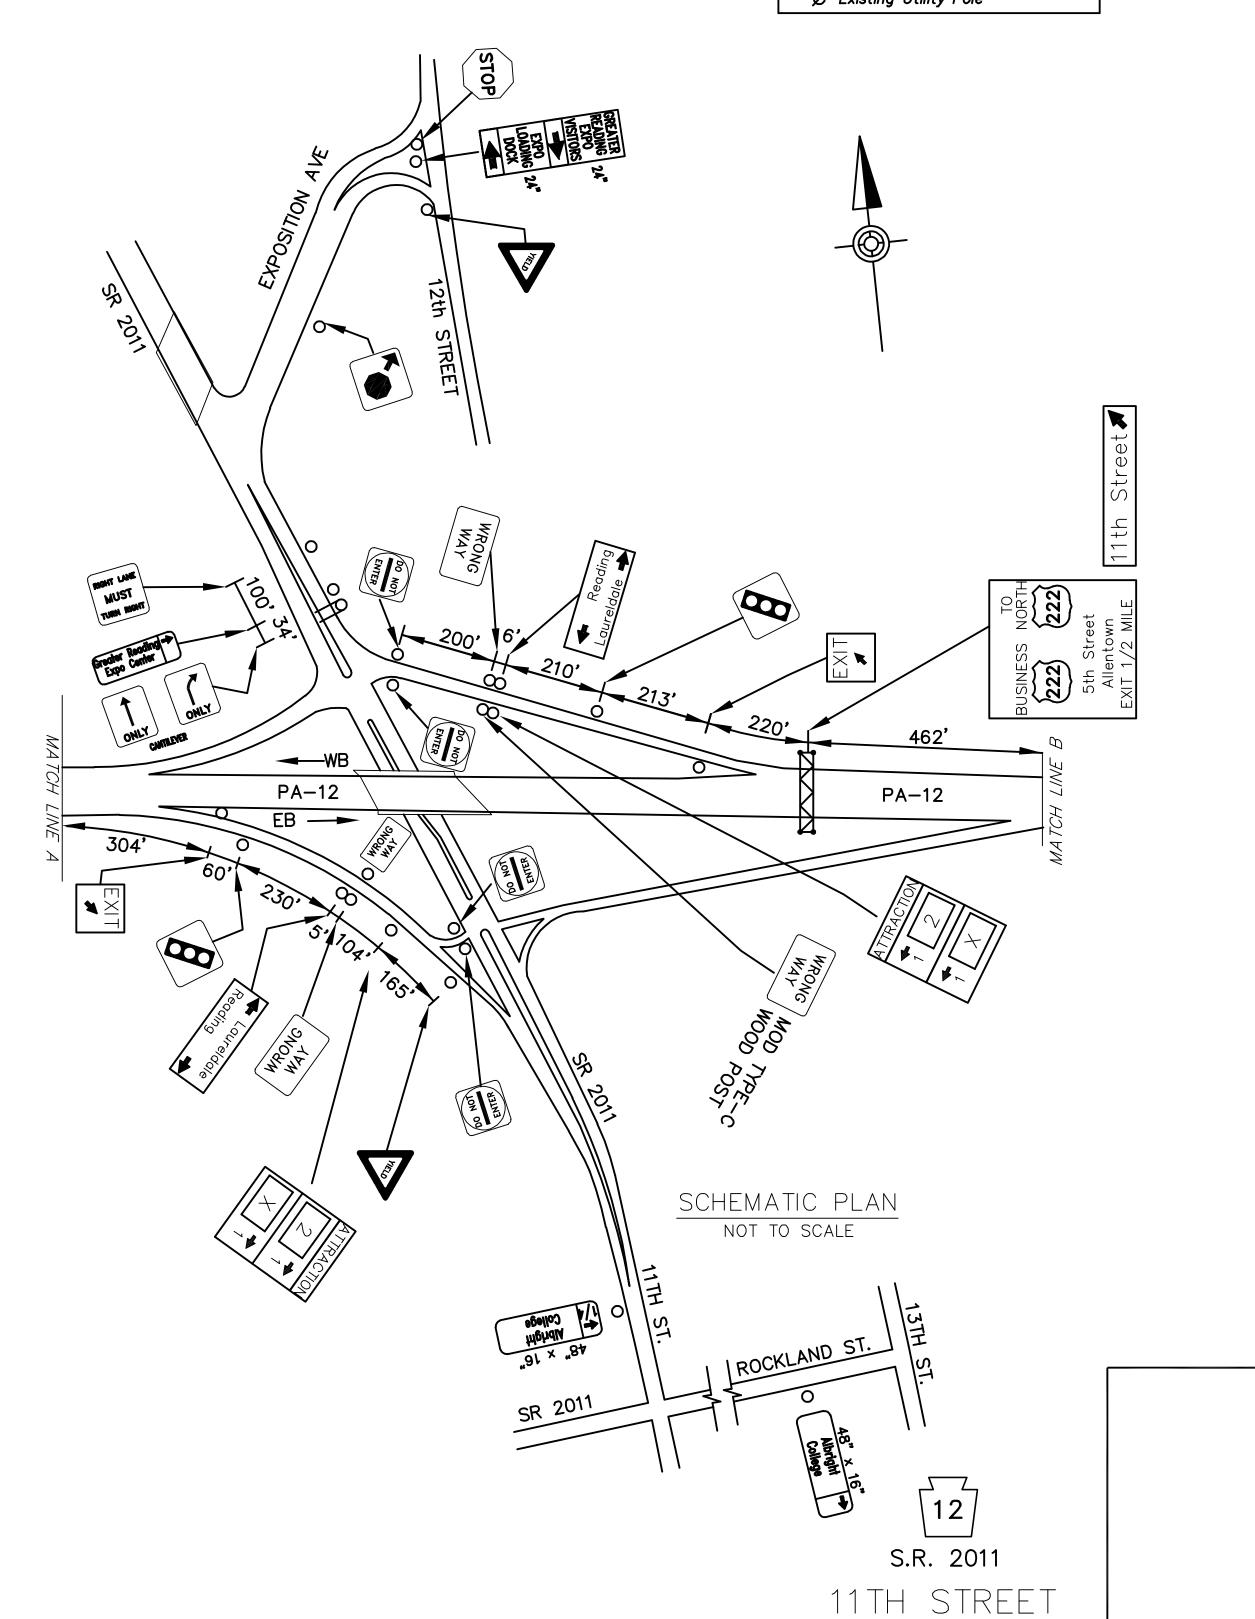

0:\2015JOBS\215076-01\HW\PSE\AS-BUILT DRAWINGS\PENNDOT DISTRICT 05\BERKS - 06\10-XX SHTXX-PA12\_EXI