

DISTRICT	COUNTY	ROUTE	PROJECT	SHEET
1-0	CRAWFORD	I-79	100-XX	X OF X
GREENWOOD TOWNSHIP UNION TOWNSHIP REVISIONS				



**SYMBOLS**

- Existing Sign to Remain
- △ Existing Sign to be Removed
- Existing Sign Reset as Shown
- ▣ Existing Sign Foundation
- NEW SIGN
- × FUTURE SIGN
- ∅ Existing Utility Pole

**TABULATION OF QUANTITIES**


ITEM	UNIT	QUANTITY
* STEEL S OR W BEAM POSTS	LBS.	---
BREAKAWAY SYSTEMS	EACH	---
POST MOUNTED SIGNS, TYPE A, LOGO	SQ.FT.	---
POST MOUNTED SIGNS, TYPE B, LOGO	SQ.FT.	---
RESET POST MOUNTED SIGNS, TYPE B, LOGO	EACH	---
REMOVE POST MOUNTED SIGNS, TYPE A, LOGO	EACH	---
REMOVE POST MOUNTED SIGNS, TYPE B, LOGO	EACH	---
LOGO SIGN MOUNTING	EACH	---
LOGO SIGN MOUNTING, RESET	EACH	---
REMOVAL OF POST MOUNTED MOTORIST SERVICE SIGNS, TYPES B, C & F	EACH	---

\* APPROXIMATE QUANTITY FOR INFORMATION ONLY

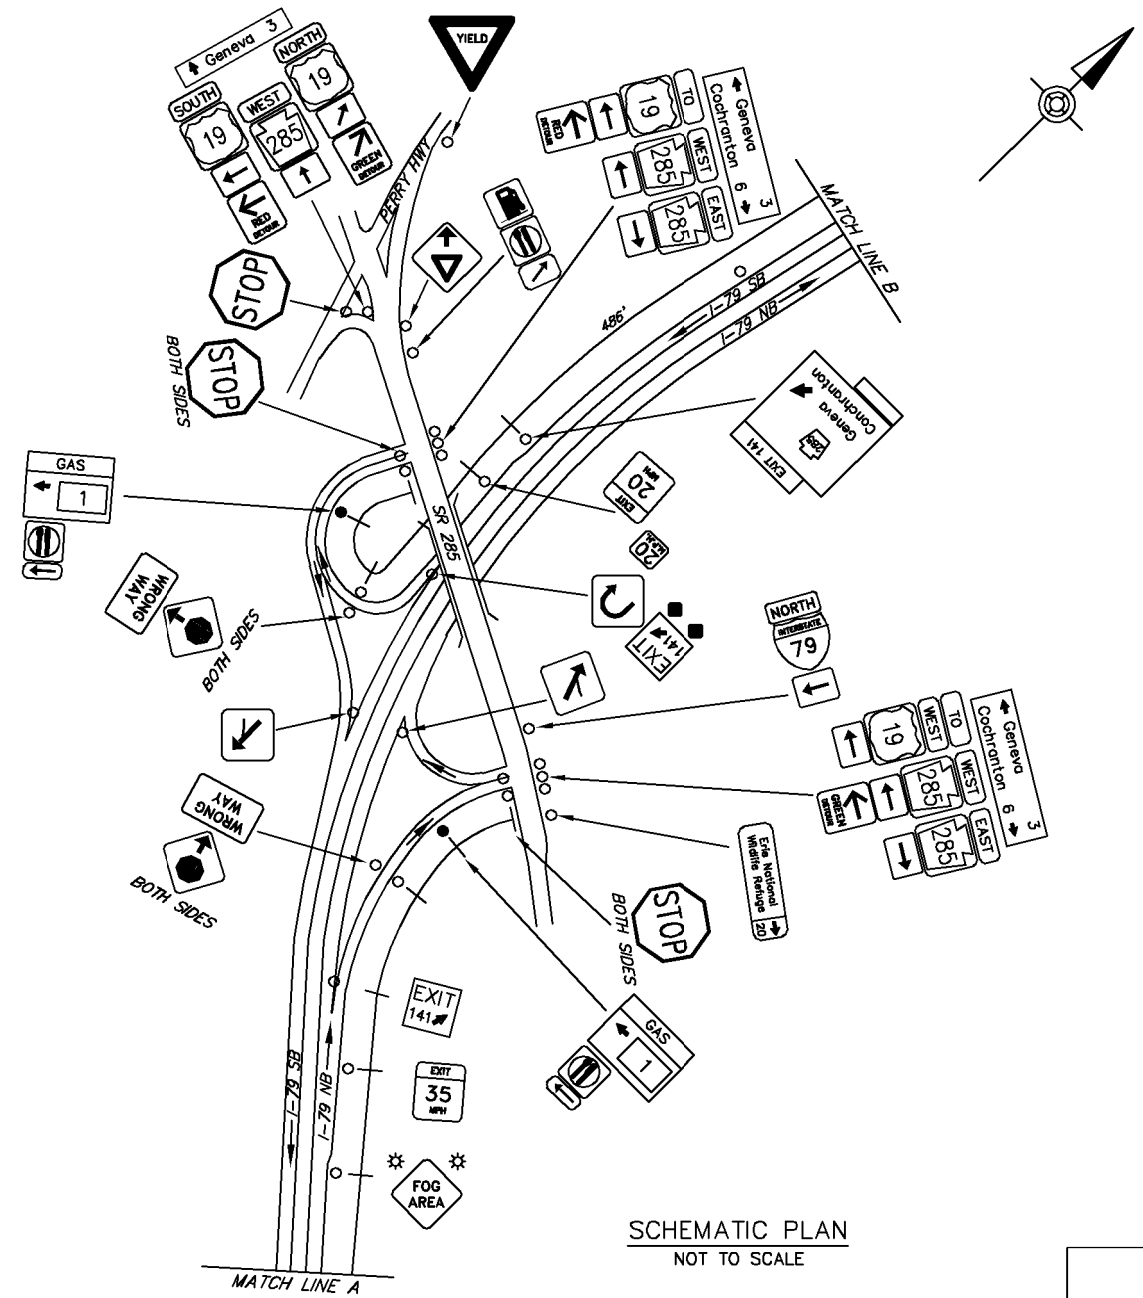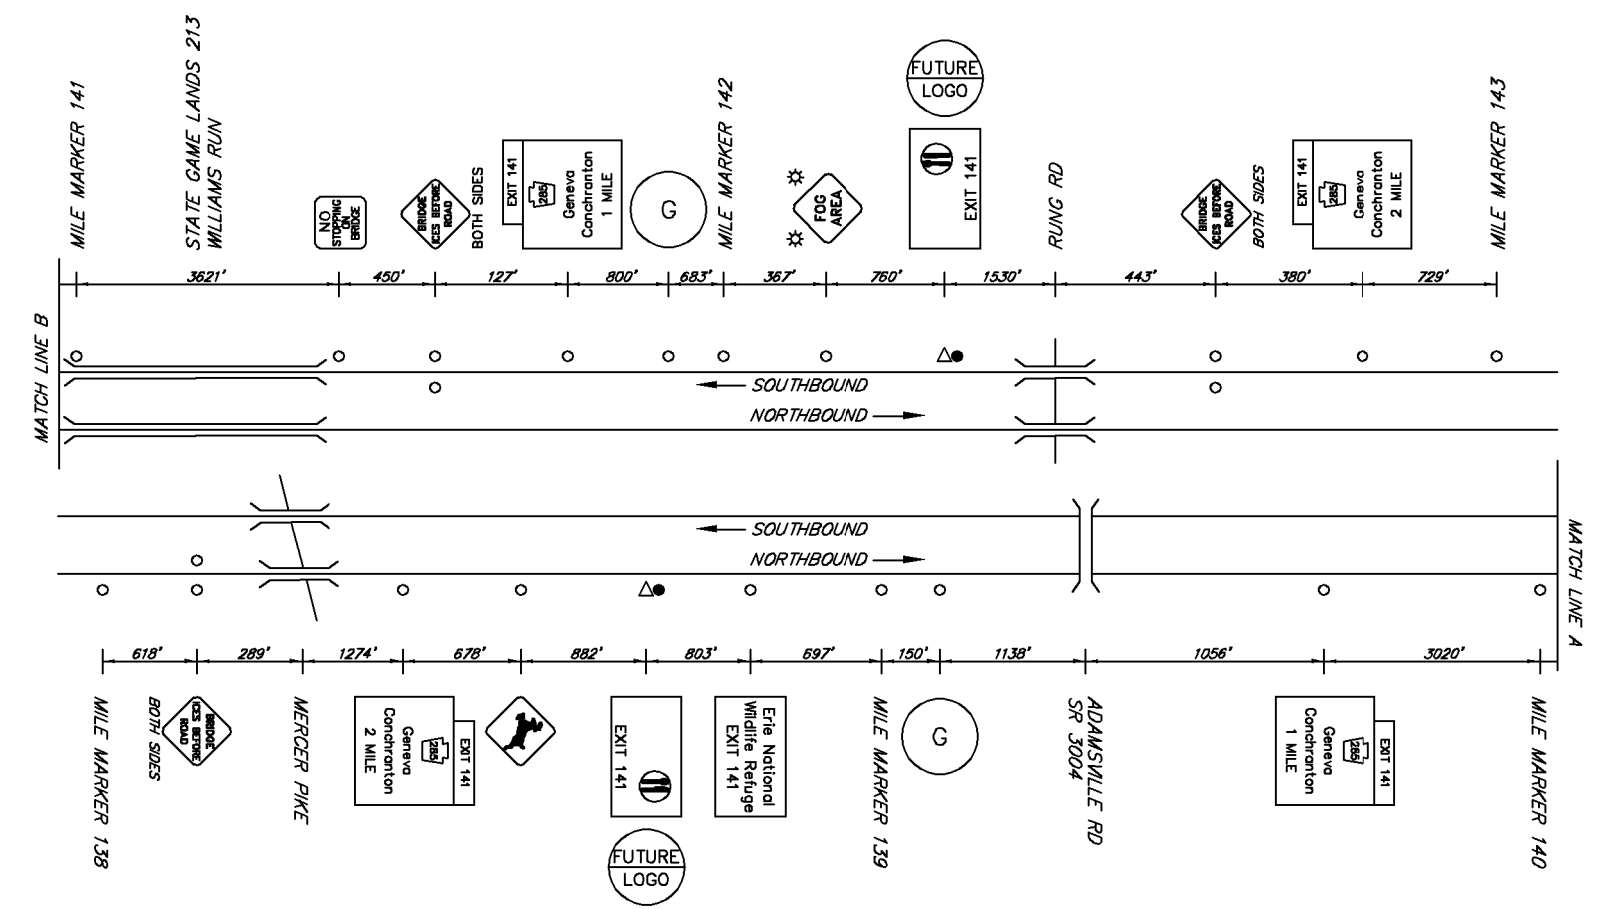

**EXIT 141 SPECIFIC INFORMATION PANEL**

LEGEND	DIRECTION	BUSINESS	LOGO NO.
GAS	NB/SB	CITGO (GENEVA FAST STOP) (24 HRS)	1

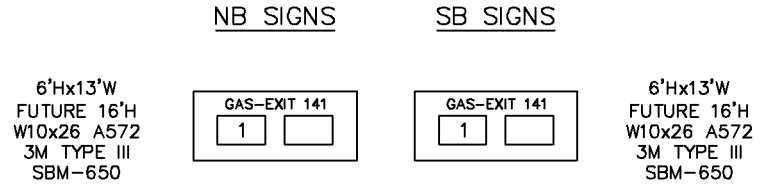

N:\PROJECTS\2018\1-0-CRAWFORD\AS-BUILT DRAWINGS\VENDOT DISTRICT 0\CRRAWFORD - 20\100-XX-SHDSX-TPL\_EXIT 141.PLAN  
 DATE: 5/20/2019 2:48 PM