DISTRICT	COUNTY	ROUTE	PROJECT	SHEET
3-0	LYCOMING	I-180	10-XX	XX OF XX
FAIRFIELD AND MUNCY TOWNSHIPS				
REVISIONS				

TABULATION OF QUANTITIES		
ITEM	UNIT	QUANTITY
POST MOUNTED SIGNS, TYPE A, LOGO	SQ.FT.	
POST MOUNTED SIGNS, TYPE B, LOGO	SQ.FT.	
POST MOUNTED SIGNS, TYPE C, LOGO	SQ.FT.	
BREAKAWAY SYSTEMS	EACH	
* STEEL S OR W BEAM POSTS	LBS.	
LOGO SIGN MOUNTING	EACH	
REMOVAL OF POST MOUNTED MOTORIST SERVICE SIGNS, TYPES A, B, C, E & F	L.S.	

* APPROXIMATE QUANTITY FOR INFORMATION ONLY

SYMBOLS

- ○ *Existing Sign to Remain*
- △ *Existing Sign to be Removed*
- □ *Existing Sign Reset as Shown*
- ● NEW SIGN
- × FUTURE SIGN
- Ø *Existing Utility Pole*

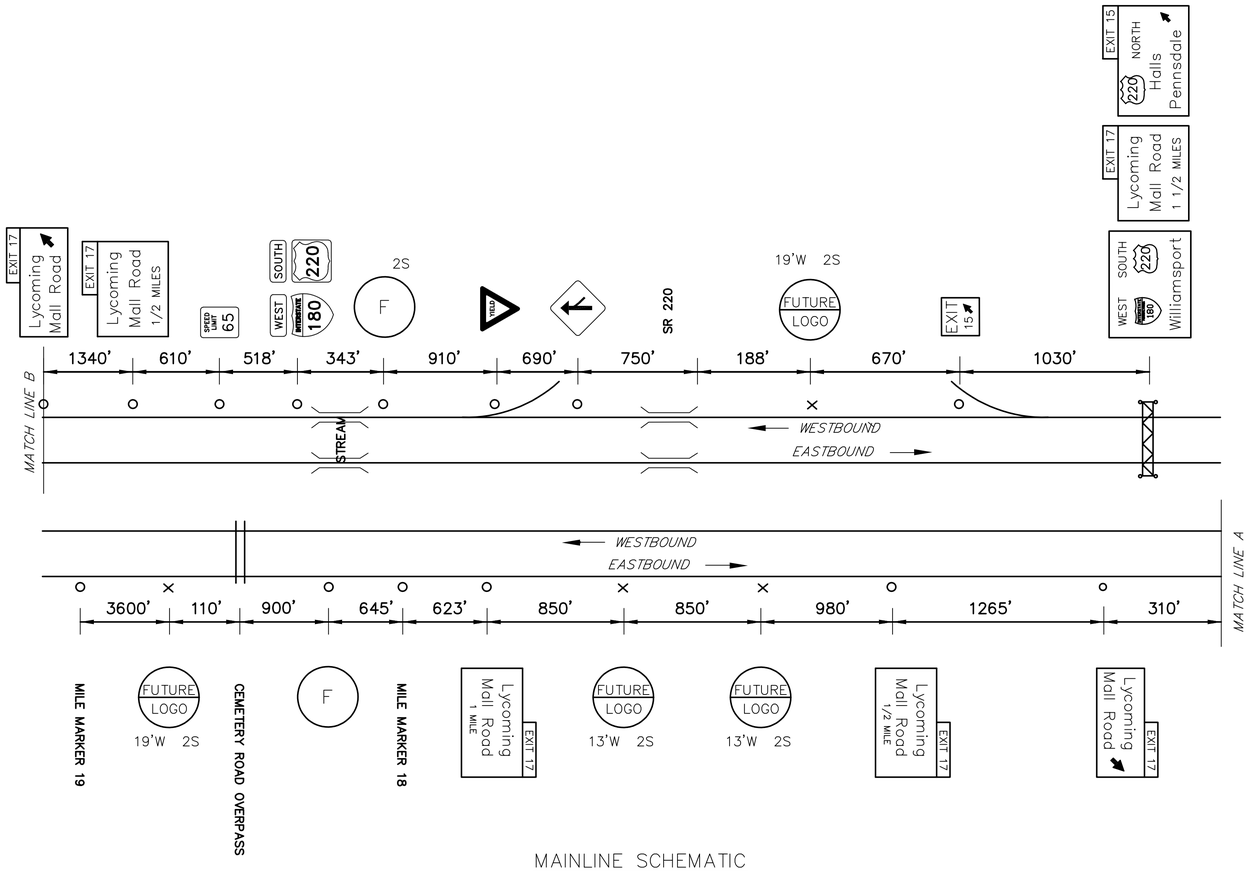

MAINLINE SCHEMATIC
NOT TO SCALE

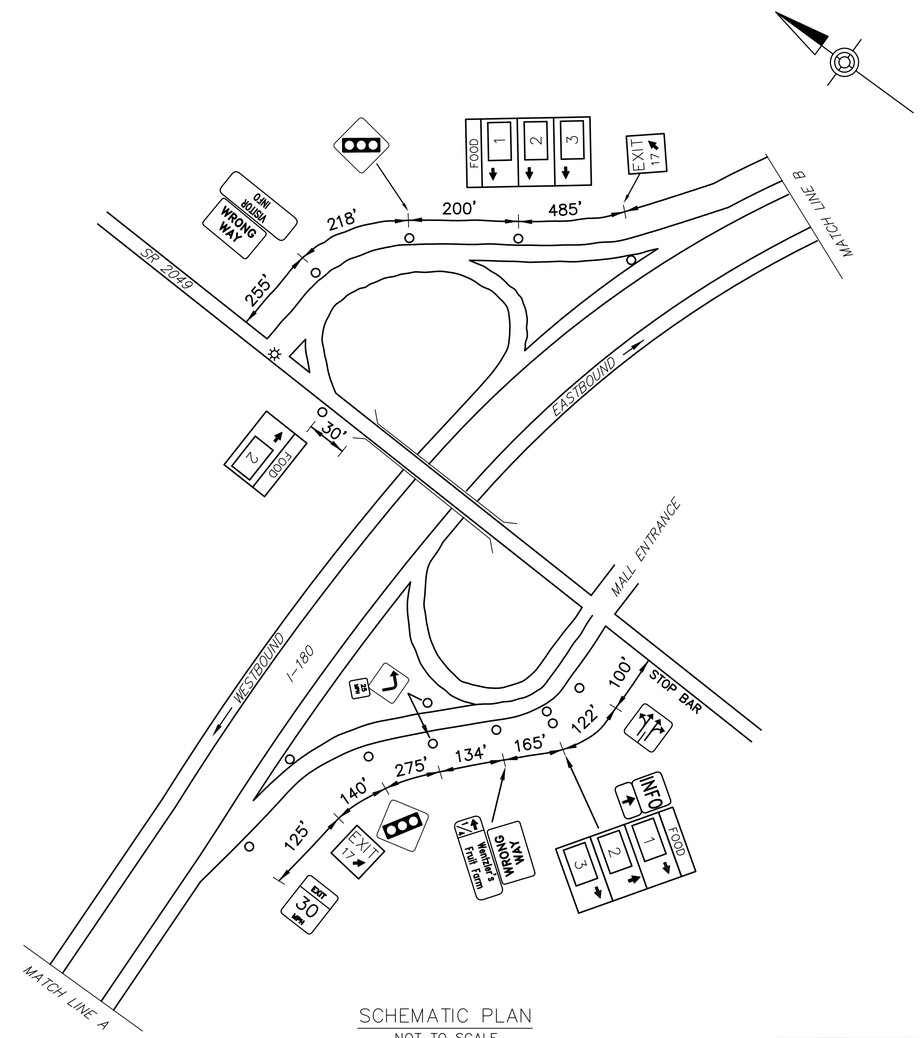

SCHEMATIC PLAN
NOT TO SCALE

LEGEND

2S – GUIDE RAIL

WORK ALONG FREEWAY PERMITTED BETWEEN 9:00 AM AND 2:30 PM, UNLESS OTHERWISE APPROVED BY ENGINEERING DISTRICT. DO NOT WORK DURING HOLIDAY. PERIODS IF APPICABLE, REINSTALL GUIDERAIL AT END OF EACH DAY.

EXIT 17 SPECIFIC INFORMATION PANEL			
LEGEND	DIRECTION	BUSINESS	LOGO NO.
FOOD	EB/WB	CRACKER BARREL	1
		MCDONALD'S	2
		STARBUCKS	3

EB SIGNS

6'Hx19'W
FUTURE 12'H
W10x26 A572
TYPE IX LEGEND
TYPE III BACKGROUND
B650 – #1, #2

WB SIGNS

6'Hx19'W
FUTURE 12'H
W14x30 A572
TYPE IX LEGEND
TYPE III BACKGROUND
B650 – #3, #3

INTERSTATE 180

SR 2049
LYCOMING MALL ROAD
EXIT 17

D:\2015.JOBS\215076-01\INV\PSE\AS-BUILT DRAWINGS\PENNDOT DISTRICT 03\LYCOMING - 41\10-XX SHTXX-I180_EXIT 17 PLAN
November 7, 2023 12:00 PM