DISTRICT	COUNTY	ROUTE	PROJECT	SHEET
9-0	CAMBRIA	US 219		
ADAMS AND RICHLAND TOWNSHIPS				

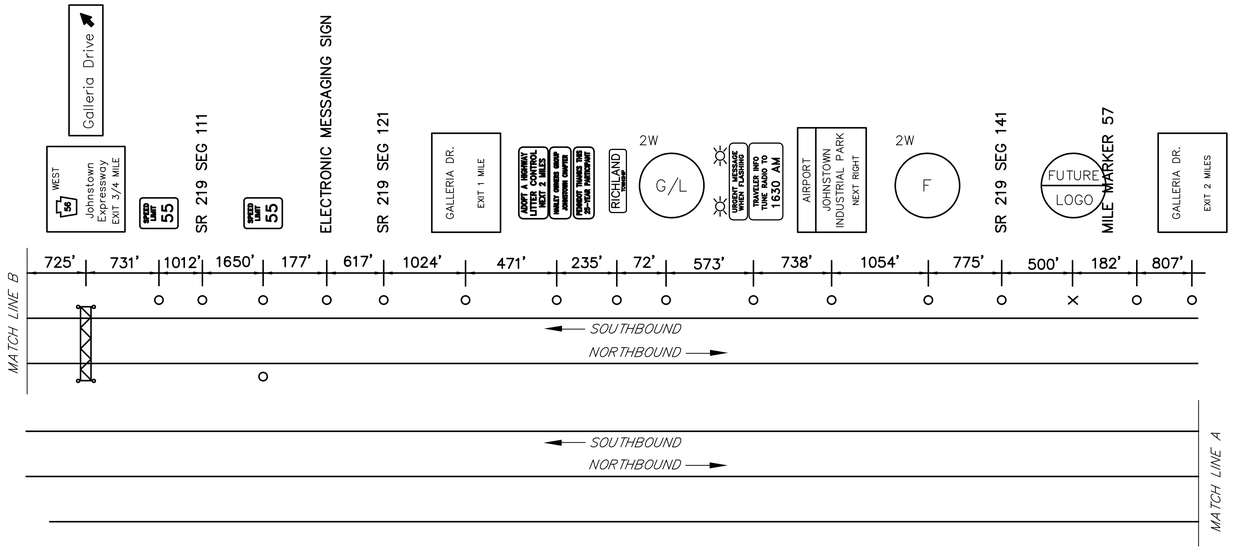

NB NOT ELIGIBLE – INSUFFICIENT SPACE

MAINLINE SCHEMATIC
NOT TO SCALE

TABULATION OF QUANTITIES		
ITEM	UNIT	QUANTITY
* STEEL S OR W BEAM POSTS	LBS.	–
BREAKAWAY SYSTEMS	EACH	–
POST MOUNTED SIGNS, TYPE A, LOGO	SQ.FT.	–
POST MOUNTED SIGNS, TYPE B, LOGO	SQ.FT.	–
POST MOUNTED SIGNS, TYPE C, LOGO	SQ.FT.	–
LOGO SIGN MOUNTING	EACH	–
FLAT SHEET REPLACEMENT PANEL	SQ.FT.	–
EXTRUDED PANEL REPLACEMENT	SQ.FT.	–
REMOVAL OF POST MOUNTED MOTORIST SERVICE SIGNS, TYPES B, C & F	L.S.	–

* APPROXIMATE QUANTITY FOR INFORMATION ONLY

SYMBOLS

- ○ *Existing Sign to Remain*
- △ *Existing Sign to be Removed*
- □ *Existing Sign Reset as Shown*
- ● NEW SIGN
- × FUTURE SIGN
- Ø *Existing Utility Pole*

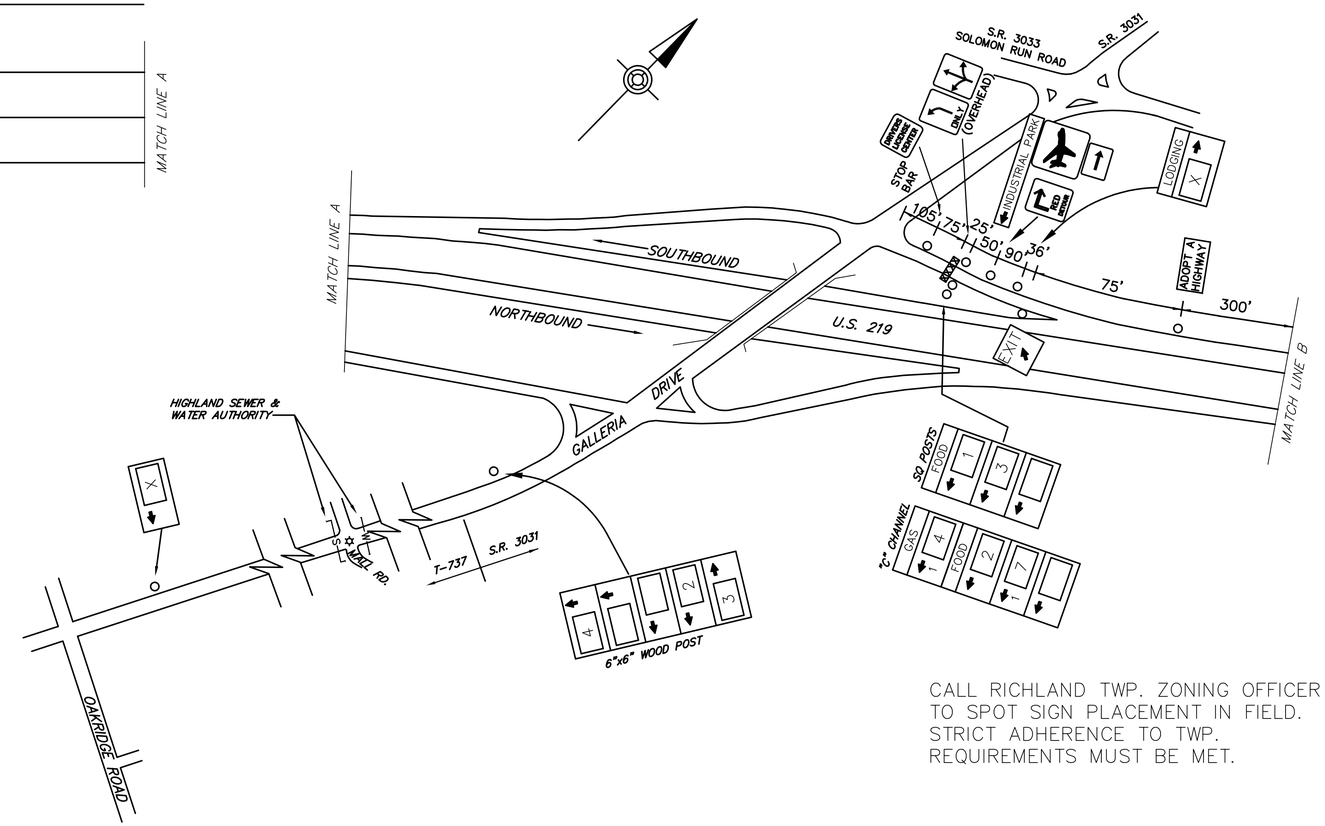

CALL RICHLAND TWP. ZONING OFFICER TO SPOT SIGN PLACEMENT IN FIELD. STRICT ADHERENCE TO TWP. REQUIREMENTS MUST BE MET.

SCHEMATIC PLAN
NOT TO SCALE

LEGEND

2W – GUIDE RAIL

GALLERIA DRIVE SPECIFIC INFORMATION PANEL			
LEGEND	DIRECTION	BUSINESS	LOGO NO.
GAS	SB	SHEETZ (DIESEL)	4
FOOD	SB	McDONALD'S #13007	1
		PERKINS FAMILY RESTAURANT #3894	3
		APPLEBEE'S	7
		PRIMANTI BROS.	2
LODGING	SB		

SB SIGNS

12'HX19'W
W14x30 A572
3M TYPE III
B650 – #2, #2

GAS – NEXT RIGHT		
4		
LODGING – NEXT RIGHT		
X		

10'HX19'W
W12x26 A572
3M TYPE III
B650 – #2, #2

FOOD – NEXT RIGHT		
1	2	3
	7	

219
SR 3031
GALLERIA DRIVE

D:\2015_GEO\-215076-01\Vol\PSE\AS-BUILT DRAWINGS\PENNDOT DISTRICT 9\CAMBRIA - 11\10-XX SHTXX-219_GALLERIA EXIT PLAN
November/20/2023 11:07 AM