DISTRICT	COUNTY	ROUTE	PROJECT	SHEET
6-0	BUCKS	I-295		

MIDDLETOWN TOWNSHIP

REVISIONS

TABULATION OF QUANTITIES		
ITEM	UNIT	QUANTITY
POST MOUNTED SIGNS, TYPE A, LOGO	SQ.FT.	
POST MOUNTED SIGNS, TYPE B, LOGO	SQ.FT.	
POST MOUNTED SIGNS, TYPE C, LOGO	SQ.FT.	
BREAKAWAY SYSTEMS	EACH	
* STEEL S OR W BEAM POSTS	LBS.	
LOGO SIGN MOUNTING	EACH	
FLAT SHEET PANEL REPLACEMENT	SQ.FT.	
EXTRUDED PANEL REPLACEMENT	SQ.FT.	
REMOVAL OF POST MOUNTED MOTORIST SERVICE SIGNS, TYPES B, C & F	L.S.	

* APPROXIMATE QUANTITY FOR INFORMATION ONLY

SYMBOLS

- ○ *Existing Sign to Remain*
- △ *Existing Sign to be Removed*
- □ *Existing Sign Reset as Shown*
- ● NEW SIGN
- × FUTURE SIGN
- Ø *Existing Utility Pole*

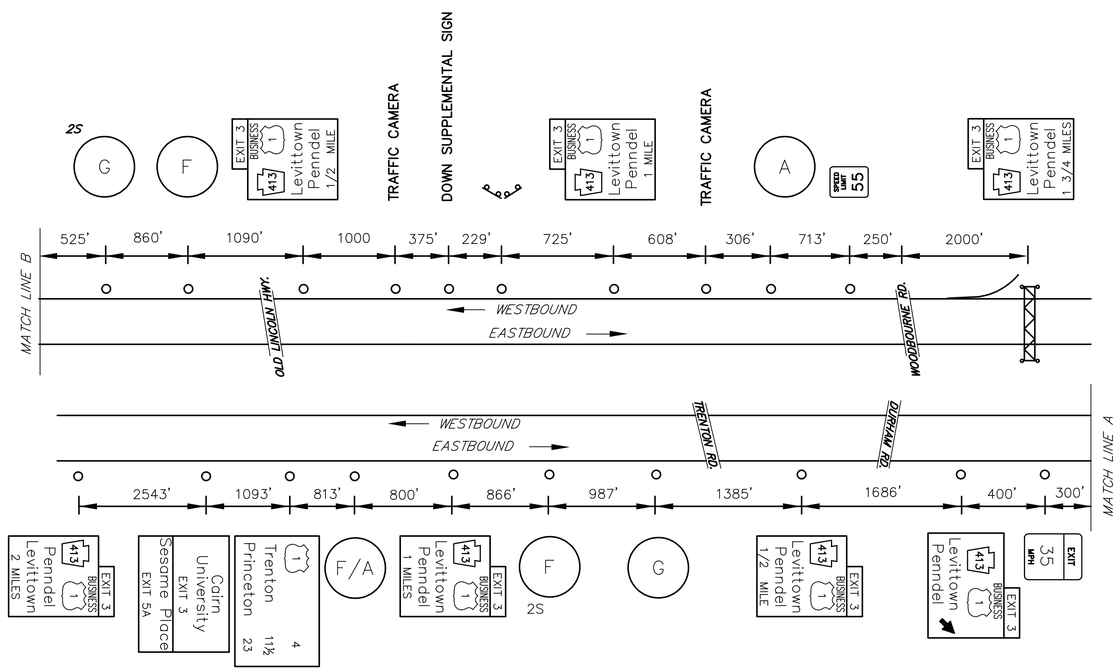

MAINLINE SCHEMATIC
NOT TO SCALE

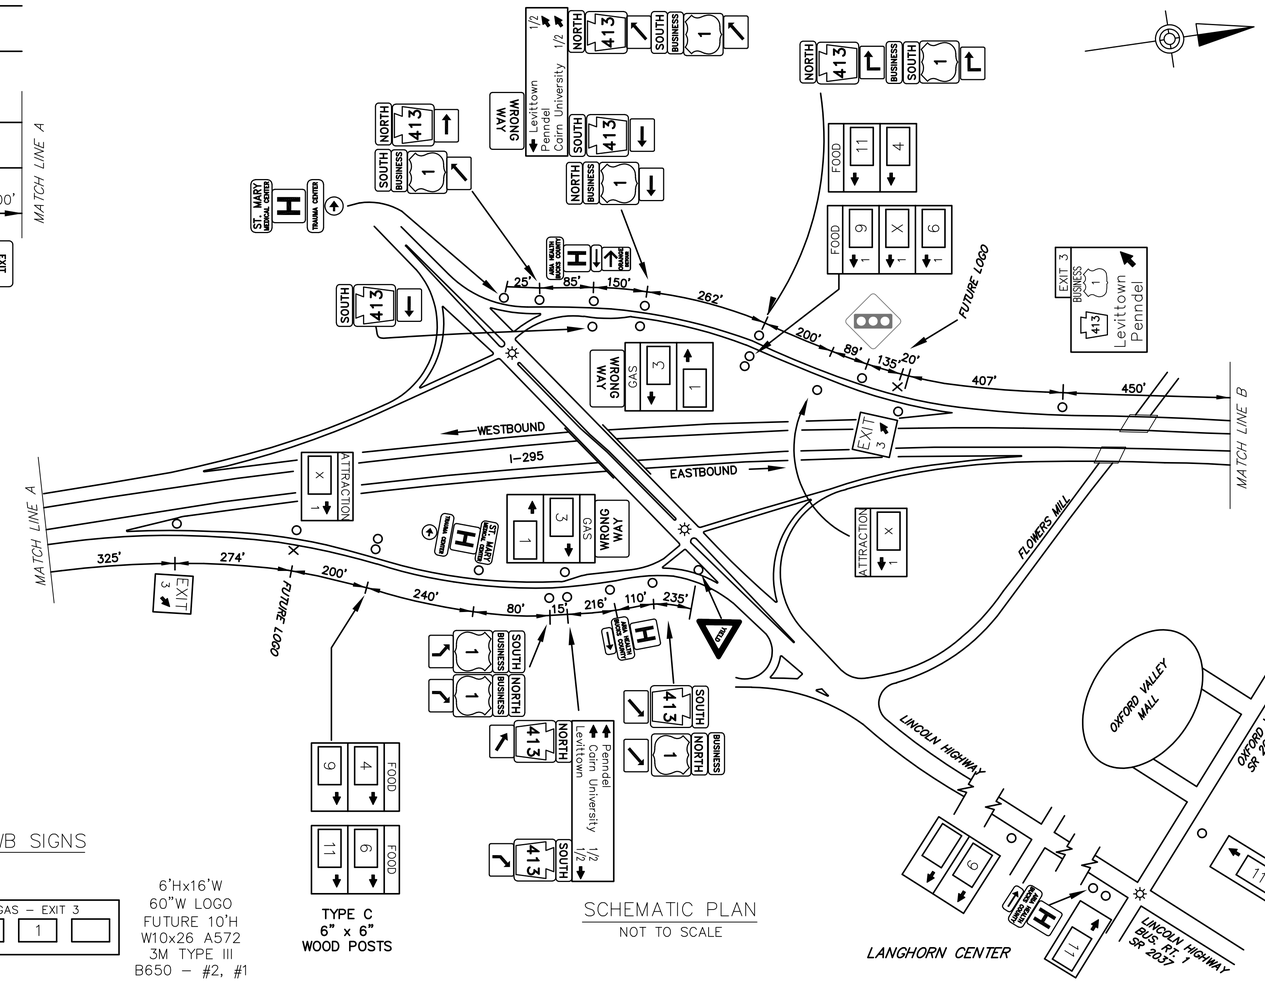

SCHEMATIC PLAN
NOT TO SCALE

LEGEND

2S – GUIDE RAIL

EXIT 3 SPECIFIC INFORMATION PANEL			
LEGEND	DIRECTION	BUSINESS	LOGO NO.
GAS	EB/WB	SHELL (24 HRS/DIESEL)	3
		WAWA (24 HRS/DIESEL)	1
FOOD	EB/WB		
		FRIENDLY'S	6
		PANERA BREAD	9
		WENDY'S	11
		STARBUCKS	4
ATTRACTION	EB/WB		

EB SIGNS

6'Hx16'W
60"W LOGO
FUTURE 12'H
W8x21 A572
3M TYPE III
B525 – #2, #2

GAS – EXIT 3: 3 1

10'Hx19'W
FUTURE 12'H
W8x21 A572
B650 – #1, #2

FOOD – EXIT 3: 4 X 6 / 9 X 11

12'Hx19'W
W12x26 A572
B650 – #2, #2

FOOD – EXIT 3: X
ATTRACTION–EXIT 3: X

WB SIGNS

6'Hx16'W
60"W LOGO
FUTURE 10'H
W10x26 A572
3M TYPE III
B650 – #2, #1

GAS – EXIT 3: 3 1

10'Hx19'W
W8x21 A572
3M TYPE III
B525 – #2, #2

FOOD – EXIT 3: X 4 6 / 11 X 9

6'Hx19'W
FUTURE 12'H
W12x26 A572
3M TYPE III
B650 – #2, #2

ATTRACTION–EXIT 3: X

INTERSTATE 295

PA 413 & BUS. RT. 1
PENNDEL LEVITTOWN
OLD I-95 EXIT 44
EXIT 3

D:\2015_ID3\3125076-01\PW\PSE\AS-BUILT DRAWINGS\PENNDOT DISTRICT 06\BUCKS - 09\10-XX SHTXX-I295_EXIT 3 PLAN
September/13/2023 8:12 AM