DISTRICT	COUNTY	ROUTE	PROJECT	SHEET
2-0	CENTRE	US 322		
COLLEGE TOWNSHIP & BORO OF STATE COLLEGE				
REVISIONS				

TABULATION OF QUANTITIES		
ITEM	UNIT	QUANTITY
POST MOUNTED SIGNS, TYPE A, LOGO	SQ.FT.	
POST MOUNTED SIGNS, TYPE B, LOGO	SQ.FT.	
POST MOUNTED SIGNS, TYPE C, LOGO	SQ.FT.	
BREAKAWAY SYSTEMS	EACH	
* STEEL S OR W BEAM POSTS	LBS.	
LOGO SIGN MOUNTING	EACH	
REMOVAL OF POST MOUNTED MOTORIST SERVICE SIGNS, TYPES A, B, C, E & F	L.S.	–

* APPROXIMATE QUANTITY FOR INFORMATION ONLY

SYMBOLS

- ○ *Existing Sign to Remain*
- △ *Existing Sign to be Removed*
- □ *Existing Sign Reset as Shown*
- ● NEW SIGN
- × FUTURE SIGN
- Ø *Existing Utility Pole*

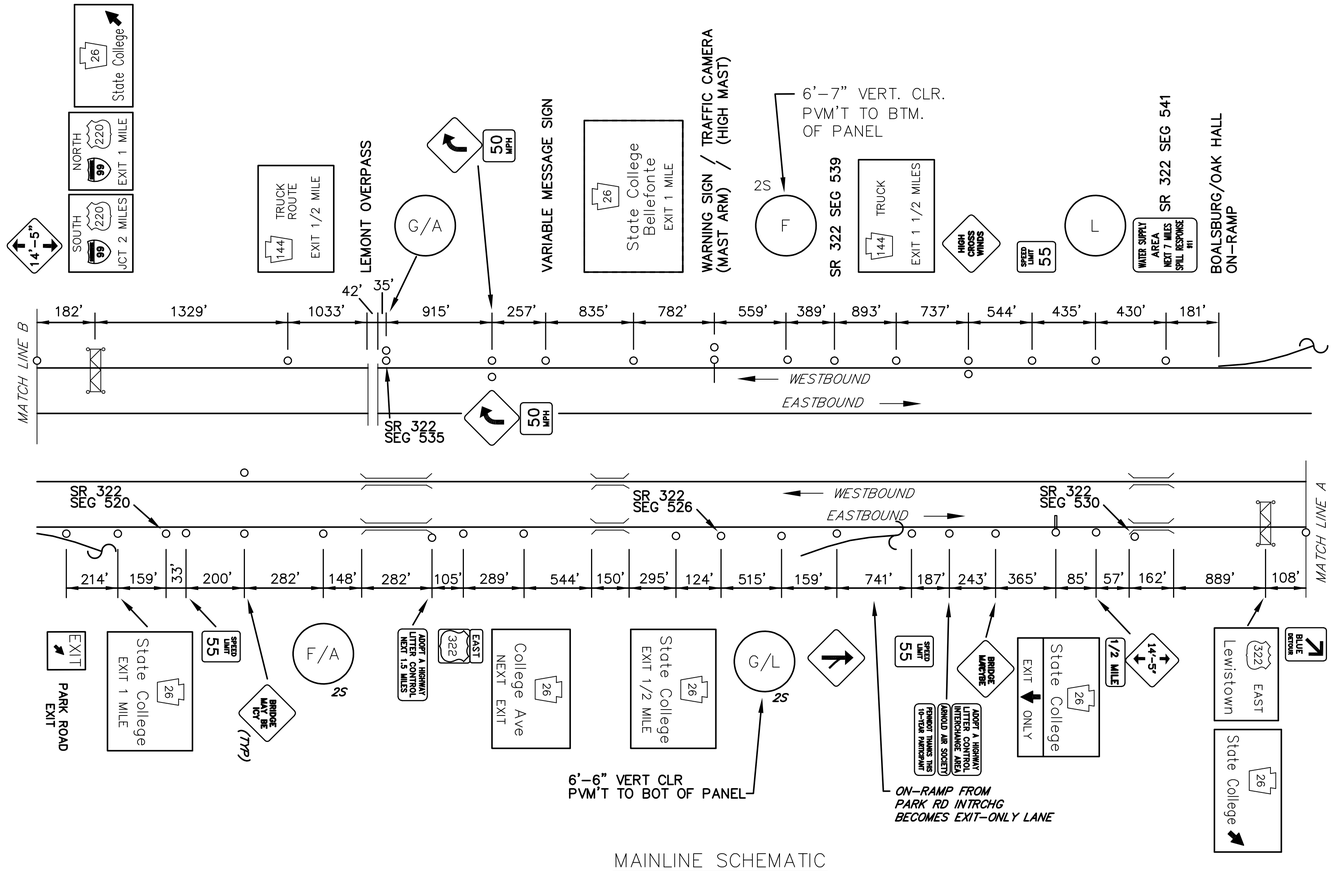

MAINLINE SCHEMATIC
NOT TO SCALE

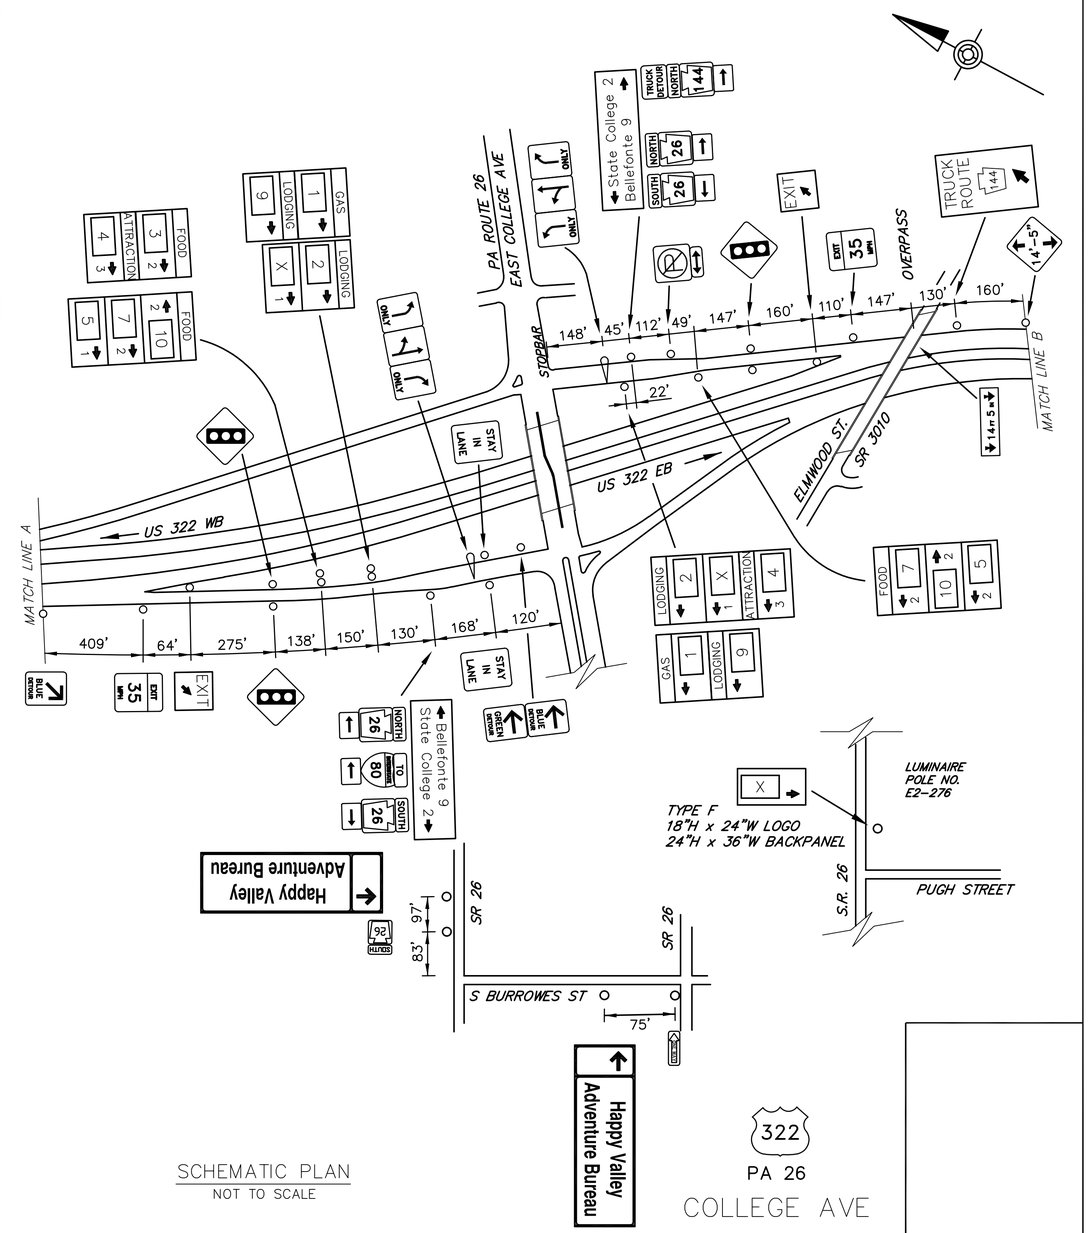

SCHEMATIC PLAN
NOT TO SCALE

LEGEND

2S – GUIDE RAIL

COLLEGE AVENUE SPECIFIC INFORMATION PANEL			
LEGEND	DIRECTION	BUSINESS	LOGO NO.
GAS	EB/WB	EXXON (24 HRS)	1
FOOD	EB/WB	DUNKIN' DONUTS	5
		McDONALD'S (24 HRS)	7
		BURGER KING	10
	EB	RAISING CANE'S CHICKEN FINGERS	3
LODGING	EB/WB	HILTON GARDEN INN	2
		COUNTRY INN & SUITES	9
ATTRACTION	EB/WB	HAPPY VALLEY ADVENTURE BUREAU	4

EB SIGNS

16'Hx13'W
W14x30 A572
3M TYPE III
B650-#2, #1

GAS – NEXT RIGHT: 1 X
LODGING–NEXT RIGHT: 2 X; X 9

16'Hx13'W
FUTURE 16'H
W14x30 A572
3M TYPE III
B650-#2, #2

FOOD–NEXT RIGHT: 5 10; 7 3
ATTRACTION – NEXT RIGHT: 4

WB SIGNS

GAS – NEXT RIGHT: 1 X
ATTRACTION – NEXT RIGHT: 4

12'Hx13'W
16' TOP SECTION
W14x30 A572
3M TYPE III
B650 – #2, #2

FOOD – NEXT RIGHT: 5 10; 7

14'Hx13'W
FUTURE 16'H
W14x30 A572
3M TYPE III
B650-#2, #1

LODGING–NEXT RIGHT: 2 X; X 9

14'Hx13'W
FUTURE 18'H
W18x40 A572
3M TYPE III
B650 – #2, #2

D:\2015\2283\215076-01\MVP\FEA\AS-BUILT DRAWINGS\PENNDOT DISTRICT 02\CENTRE - 14\10-XX SHTXX-322_E COLLEGE AVE EXIT PLAN
November 17/2023 11:36 AM