DISTRICT	COUNTY	ROUTE	PROJECT	SHEET
10-0	BUTLER	US 422		
BUTLER TOWNSHIP				
REVISIONS				

TABULATION OF QUANTITIES		
ITEM	UNIT	QUANTITY
POST MOUNTED SIGNS, TYPE A, LOGO	SQ.FT.	
POST MOUNTED SIGNS, TYPE B, LOGO	SQ.FT.	
POST MOUNTED SIGNS, TYPE C, LOGO	SQ.FT.	
POST MOUNTED SIGNS, TYPE F, LOGO	EACH	
BREAKAWAY SYSTEMS	EACH	
* STEEL S OR W BEAM POSTS	LBS.	
LOGO SIGN MOUNTING	EACH	
REMOVAL OF POST MOUNTED MOTORIST SERVICE SIGNS, TYPES A & E	EACH	
REMOVAL OF POST MOUNTED MOTORIST SERVICE SIGNS, TYPES B, C & F	L.S.	–

* APPROXIMATE QUANTITY FOR INFORMATION ONLY

SYMBOLS

- ○ *Existing Sign to Remain*
- △ *Existing Sign to be Removed*
- □ *Existing Sign Reset as Shown*
- ● NEW SIGN
- × FUTURE SIGN
- Ø *Existing Utility Pole*

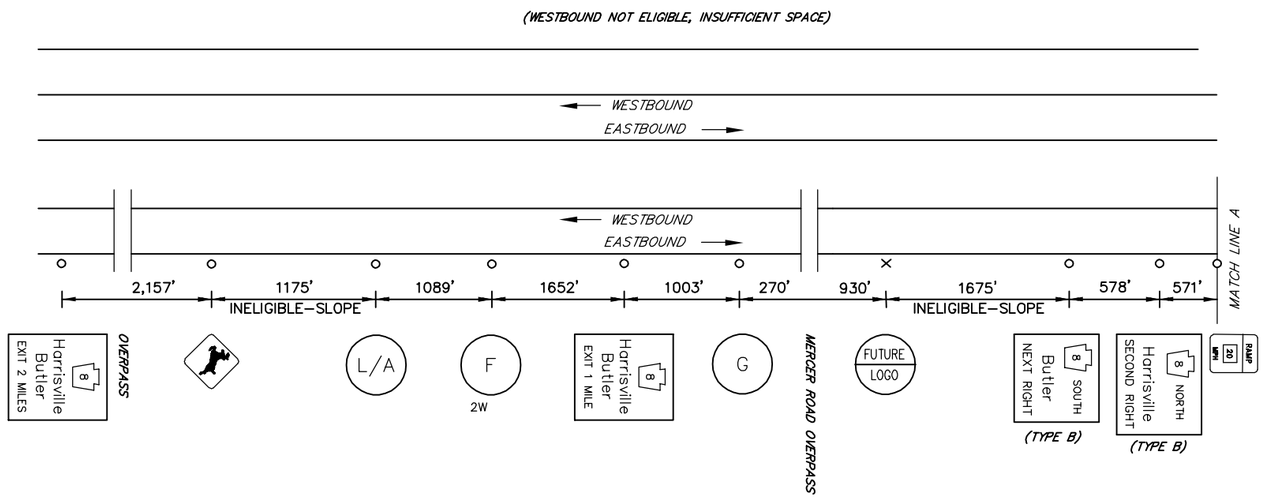

MAINLINE SCHEMATIC
NOT TO SCALE

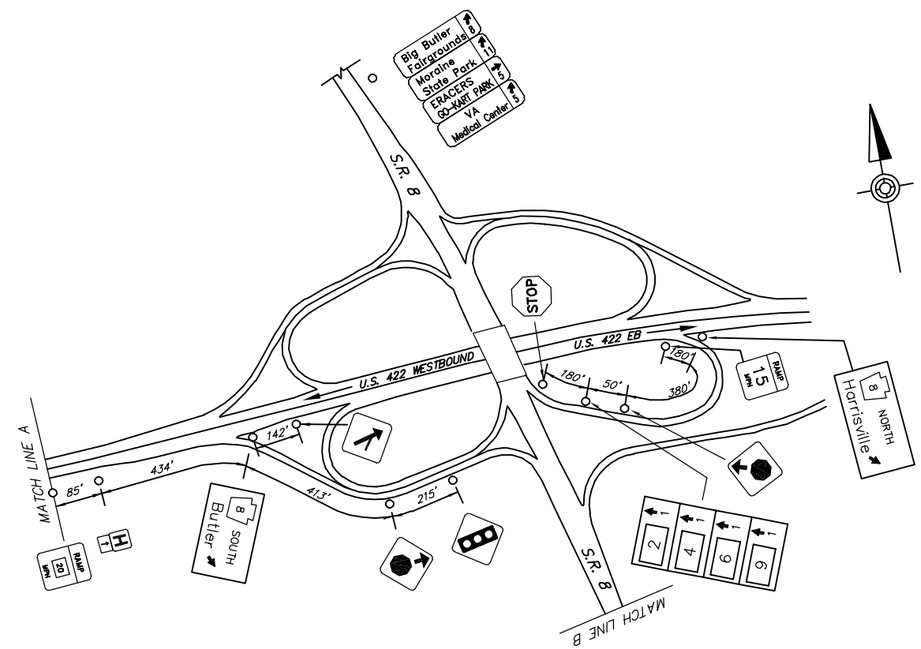

BUTLER EXIT SPECIFIC INFORMATION PANEL			
LEGEND	DIRECTION	BUSINESS	LOGO NO.
GAS	EB	GETGO (24 HOURS/DIESEL)	3
		UNIVERSITY KORNER	10
FOOD	EB	RACHEL'S ROADHOUSE	8
		McDONALD'S	2
		EAT'N PARK (24 HOURS)	4
		WENDY'S	6
		SHEETZ	9
LODGING	EB		
		SPRINGHILL SUITES	1
ATTRACTION	EB		

EB SIGNS

12'Hx16'W
48"W LOGO
W12x26 A572
3M TYPE III
B650 – #1, #1

GAS – NEXT RIGHT		
3		
GAS – SECOND RIGHT		
10		

16'Hx13'W
W12x26 A572
3M TYPE III
B650 – #1, #1

FOOD–NEXT RIGHT	
8	
FOOD–SECOND RIGHT	
2	9
4	6

12'Hx13'W
FUTURE 16'H
W12x26 A572
3M TYPE III
B650 – #2, #2

LODGING–NEXT RIGHT	
X	1
ATTRACTION–SECOND RIGHT	
X	

SCHEMATIC PLAN
NOT TO SCALE

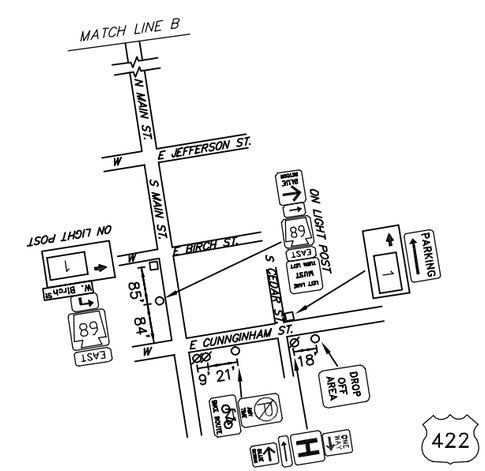

PA ROUTE 008
HARRISVILLE/BUTLER

D:\2015\2085\215076-01\PA\PSE\AS-BUILT DRAWINGS\PENDOT DISTRICT 10\BUTLER - 10\10-XX SHT0X-422_ HARRISVILLE_PA008 PLAN
November/13/2023 3:59 PM