DISTRICT	COUNTY	ROUTE	PROJECT	SHEET
12-0	FAYETTE	PA-43		

GEORGES TOWNSHIP

REVISIONS

SOUTHBOUND NOT ELIGIBLE – INSUFFICIENT SPACE

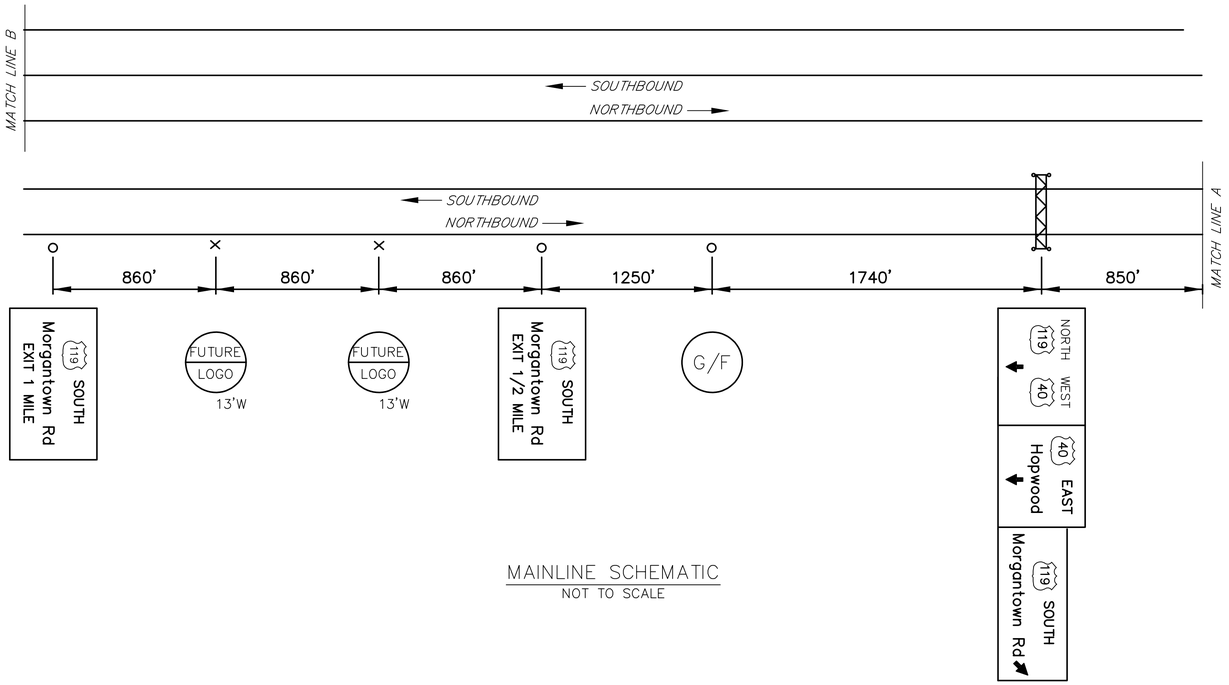

MAINLINE SCHEMATIC
NOT TO SCALE

TABULATION OF QUANTITIES		
ITEM	UNIT	QUANTITY
POST MOUNTED SIGNS, TYPE A, LOGO	SQ.FT.	
POST MOUNTED SIGNS, TYPE B, LOGO	SQ.FT.	
POST MOUNTED SIGNS, TYPE C, LOGO	SQ.FT.	
BREAKAWAY SYSTEMS	EACH	
* STEEL S OR W BEAM POSTS	LBS.	
LOGO SIGN MOUNTING	EACH	
REMOVAL OF POST MOUNTED MOTORIST SERVICE SIGNS, TYPES A & E	EACH	
REMOVAL OF POST MOUNTED MOTORIST SERVICE SIGNS, TYPES B, C & F	L.S.	

* APPROXIMATE QUANTITY FOR INFORMATION ONLY

SYMBOLS

- ○ *Existing Sign to Remain*
- △ *Existing Sign to be Removed*
- □ *Existing Sign Reset as Shown*
- ● NEW SIGN
- × FUTURE SIGN
- Ø *Existing Utility Pole*

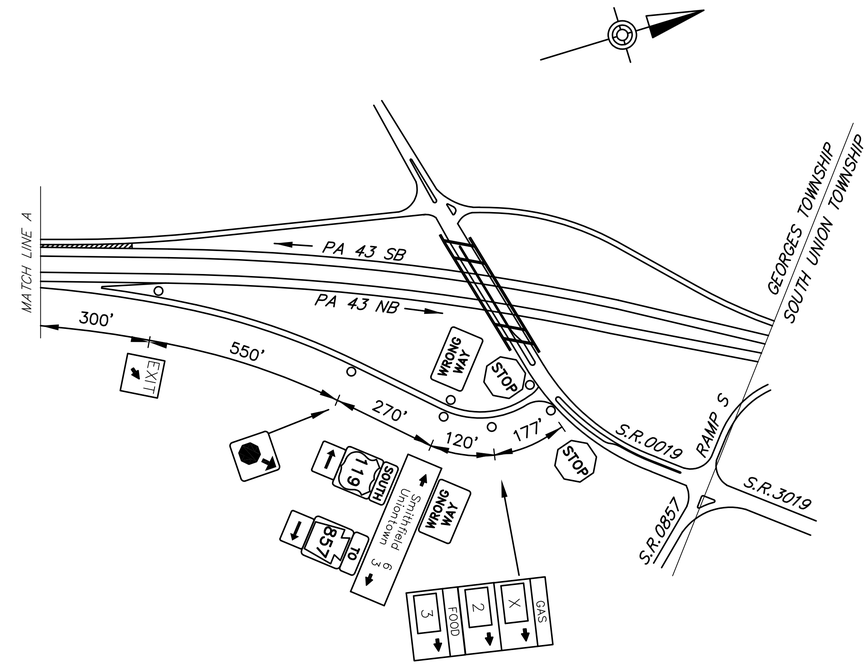

SCHEMATIC PLAN
NOT TO SCALE

MORGANTOWN ROAD EXIT SPECIFIC INFORMATION PANEL			
LEGEND	DIRECTION	BUSINESS	LOGO NO.
GAS	NB		
		SUNOCO	2
FOOD	NB	ARBY'S	3

NB SIGNS

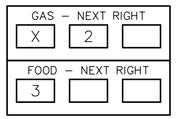

12'H x 19'W
FUTURE 14'H
W12x26 A572
3M TYPE III
B650– #2, #2

43

U.S. 119 SOUTH

MORGANTOWN ROAD

D:\2015_JOBS\215076-01\WK\PSE_AS-BUILT DRAWINGS\PENNDOT DISTRICT 12\FAYETTE - PA\10-XX SHTXX_43_MORGANTOWN EXIT PLAN
November/13/2023 11:46 AM