DISTRICT	COUNTY	ROUTE	PROJECT	SHEET
12-0	WESTMORELAND	I-70	XXX-XX	X OF X
ROSTRAVER TOWNSHIP				
REVISIONS				

TABULATION OF QUANTITIES		
ITEM	UNIT	QUANTITY
POST MOUNTED SIGNS, TYPE A, LOGO	SQ.FT.	–
POST MOUNTED SIGNS, TYPE A, LOGO (MODIFIED)	SQ.FT.	–
POST MOUNTED SIGNS, TYPE C, LOGO	SQ.FT.	
BREAKAWAY SYSTEMS	EACH	–
* STEEL S OR W BEAM POSTS	LBS.	–
LOGO SIGN MOUNTING	EACH	–
LOGO SIGN MOUNTING, RESET	EACH	–
REMOVE POST MOUNTED SIGNS, TYPE A LOGO (MODIFIED)	EACH	–
REMOVE POST MOUNTED SIGNS, TYPE A, LOGO	EACH	

* APPROXIMATE QUANTITY FOR INFORMATION ONLY

SYMBOLS

- *Existing Sign to Remain*
- *Existing Sign to be Removed*
- *Existing Sign Reset as Shown*
- NEW SIGN
- FUTURE SIGN
- *Existing Utility Pole*

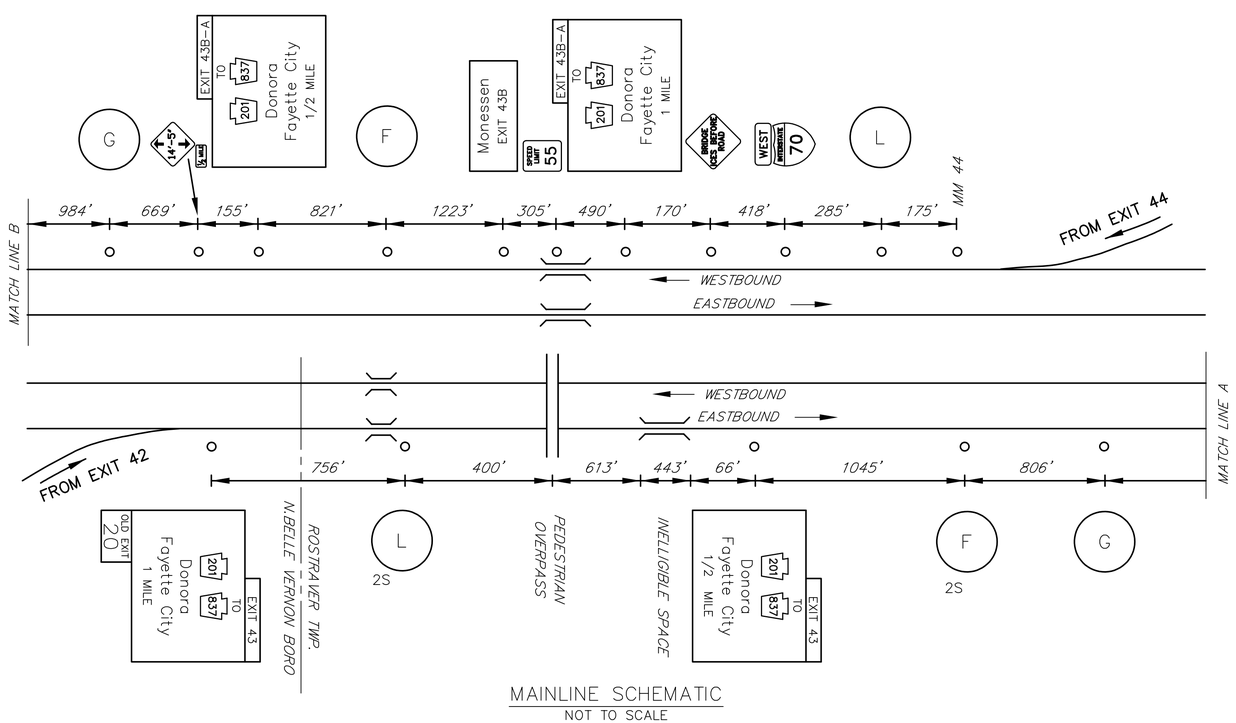

MAINLINE SCHEMATIC
NOT TO SCALE

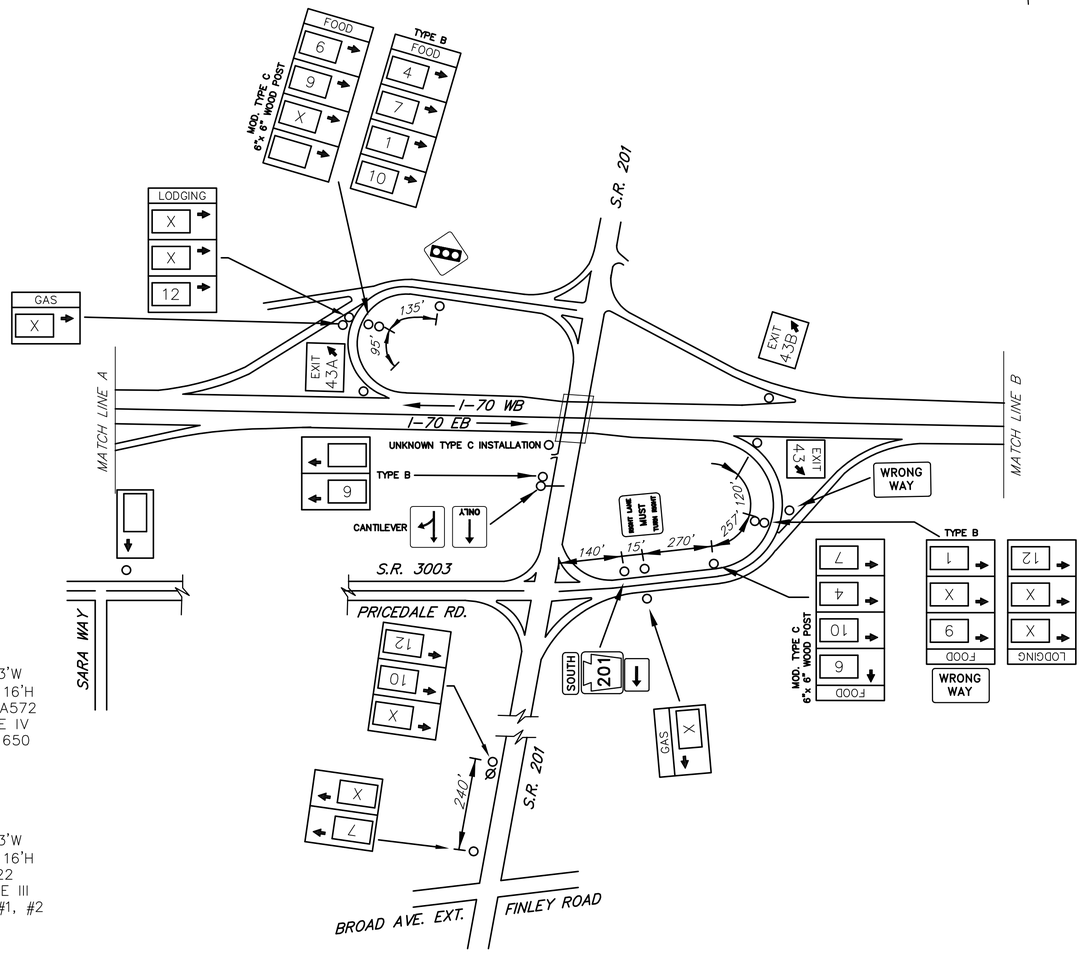

SCHEMATIC PLAN
NOT TO SCALE

LEGEND

2S – GUIDE RAIL

FREEWAY LANE CLOSURES & RESTRICTIONS ONLY PERMITTED BETWEEN 9:00 PM AND 6:00 AM MONDAY THRU FRIDAY. WORK ALONG FREEWAY PERMITTED BETWEEN 9:00 AM AND 2:30 PM, UNLESS OTHERWISE APPROVED BY ENGINEERING DISTRICT. DO NOT WORK DURING HOLIDAY PERIODS. IF APPLICABLE, REINSTALL GUIDERAIL AT END OF EACH DAY.

EXIT 43/43A SPECIFIC INFORMATION PANEL			
LEGEND	DIRECTION	BUSINESS	LOGO NO.
GAS	EB/WB		
FOOD	EB/WB	BURGER KING	1
		WENDY'S	4
		EAT'N PARK (24 HRS)	7
		SUBWAY	9
		HOSS'S FAMILY STEAK & SEA	10
		STARBUCKS COFFEE	6
LODGING	EB/WB	HAMPTON INN	5
		FAIRFIELD BY MARRIOTT	12

	EB SIGNS	WB SIGNS	
12'Hx13'W FUTURE 16'H W10x26 A572 XX TYPE IV SBM – 650	GAS – EXIT 43 X	GAS – EXIT 43A X	12'Hx13'W FUTURE 16'H W14x30 A572 XX TYPE IV SBM – 650
14'Hx13'W W12x26 3M TYPE III B650 – #2, #1	FOOD – EXIT 43 6 9 10 4 7 1	FOOD – EXIT 43A 1 6 10 7 4 9	14'Hx13'W FUTURE 16'H W10x22 3M TYPE III B650 – #1, #2
10'Hx13'W 14' TOP SECTION W8x21 3M TYPE IX LEGEND TYPE III BACKGROUND B525 – #2, #2	LODGING – EXIT 43 12 X 5	LODGING – EXIT 43A 12 X 5	10'Hx13'W FUTURE 15'H W14x30 3M TYPE IX LEGEND TYPE III BACKGROUND B650 – #2, #1

INTERSTATE 70

FAYETTE CITY

EXIT 43/43A

D:\2015_JOBS\215074-01\WAPSE\AS-BUILT DRAWINGS\PENNDOT DISTRICT 12\WESTMORELAND - 64\I-XX SHTXX-170_EXIT 43 PLAN
September/13/2023 8:42 AM