DISTRICT	COUNTY	ROUTE	PROJECT	SHEET
5-0	LEHIGH	I-78		

UPPER MACUNGIE & LOWER MACUNGIE TWP'S

REVISIONS

TABULATION OF QUANTITIES		
ITEM	UNIT	QUANTITY
POST MOUNTED SIGNS, TYPE A, LOGO	SQ.FT.	–
POST MOUNTED SIGNS, TYPE B, LOGO	SQ.FT.	–
POST MOUNTED SIGNS, TYPE C, LOGO	SQ.FT.	–
BREAKAWAY SYSTEMS	EACH	–
* STEEL S OR W BEAM POSTS	LBS.	–
LOGO SIGN MOUNTING	EACH	–
EXTRUDED PANEL REPLACEMENT	SQ.FT.	–
REMOVAL OF POST MOUNTED MOTORIST SERVICE SIGNS, TYPES B, C & F	L.S.	–

* APPROXIMATE QUANTITY FOR INFORMATION ONLY

SYMBOLS

- ○ *Existing Sign to Remain*
- △ *Existing Sign to be Removed*
- □ *Existing Sign Reset as Shown*
- ● NEW SIGN
- × FUTURE SIGN
- Ø *Existing Utility Pole*

WB NOT ELIGIBLE – INSUFFICIENT SPACE

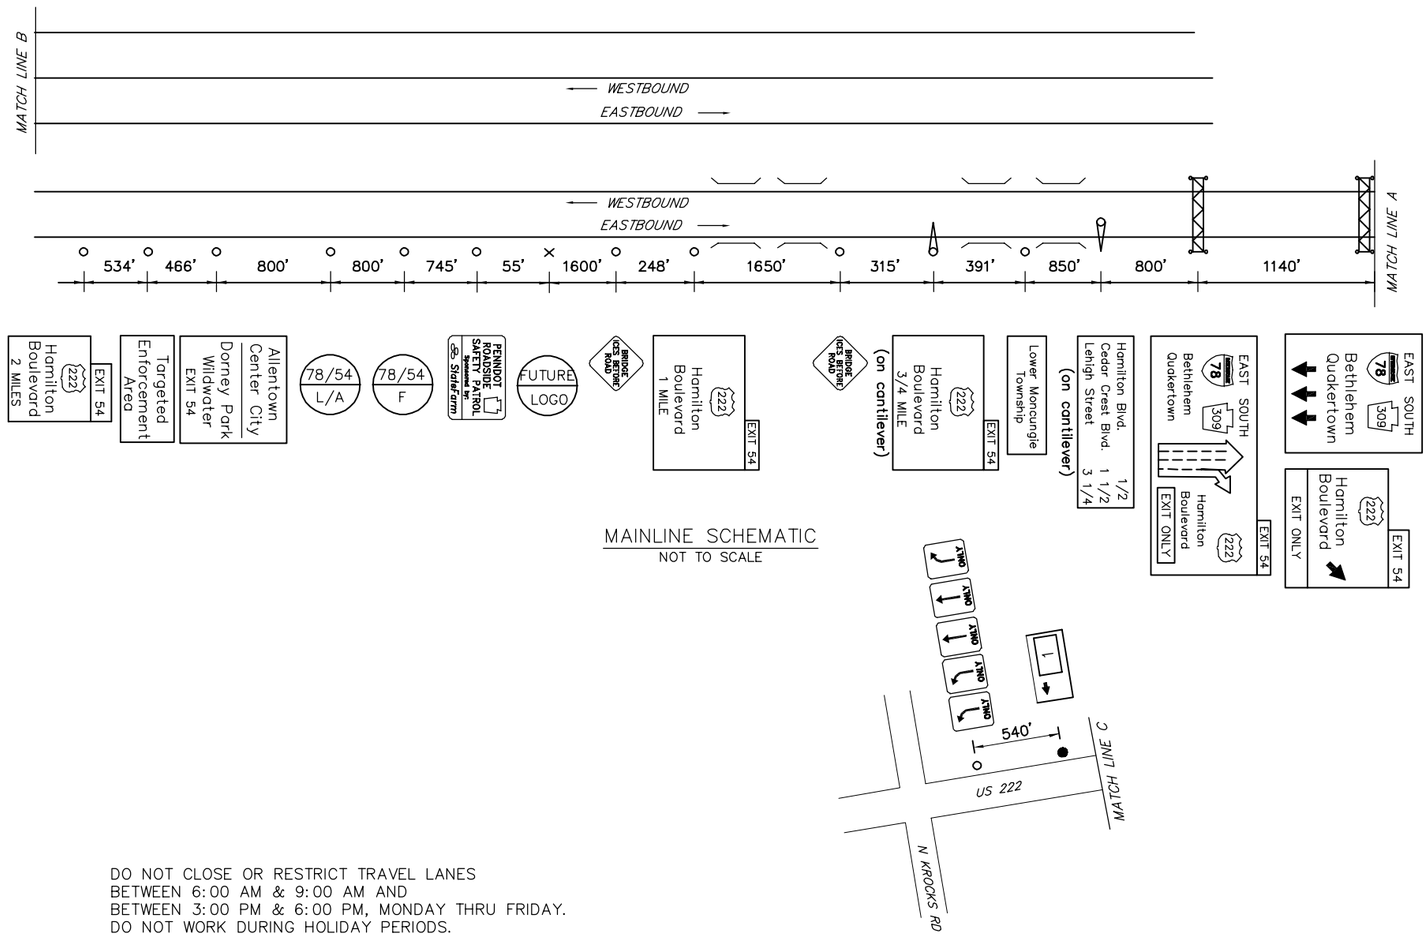

MAINLINE SCHEMATIC
NOT TO SCALE

DO NOT CLOSE OR RESTRICT TRAVEL LANES
BETWEEN 6:00 AM & 9:00 AM AND
BETWEEN 3:00 PM & 6:00 PM, MONDAY THRU FRIDAY.
DO NOT WORK DURING HOLIDAY PERIODS.

EXIT 54 SPECIFIC INFORMATION PANEL			
LEGEND	DIRECTION	BUSINESS	LOGO NO.
FOOD	EB	WENDY'S	3
		PERKINS	6
		McDONALD'S	8
		PIZZA HUT	10
		GOURMET BUFFET & GRILL	12
		STARBUCKS	1
LODGING	EB	FOUR POINTS SHERATON	2
		HOLIDAY INN EXPRESS & SUITES	4
		HOLIDAY INN	13
ATTRACTION	EB		

EB SIGNS

16'Hx13'W
W10x26 A572
3M TYPE III
B650 – #2, #2

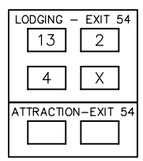

14'Hx13'W
FUTURE 16'H
W12x26 A572
STIM. TYPE III
B650 – #2, #2

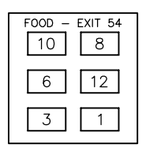

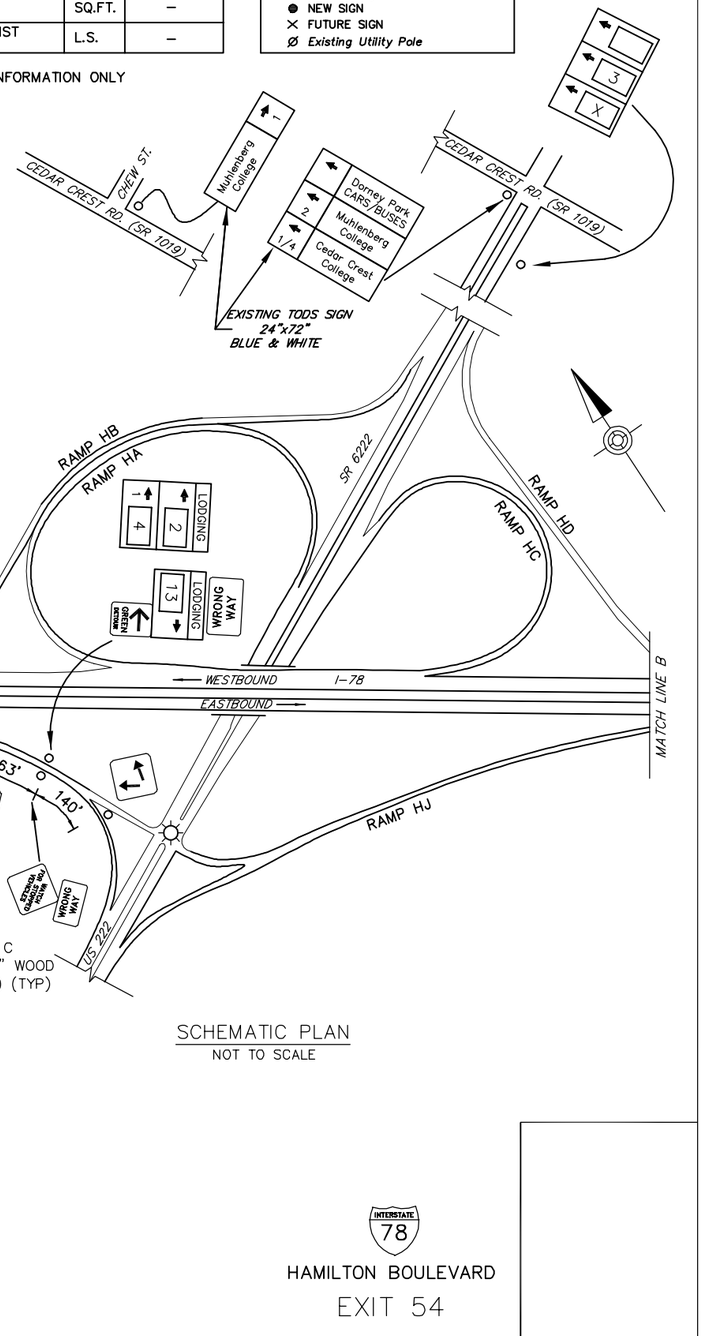

SCHEMATIC PLAN
NOT TO SCALE

INTERSTATE 78

HAMILTON BOULEVARD

EXIT 54

D:\2015\2015\215976-01\MKV\PSE\AS-BUILT DRAWINGS\PENNDOT DISTRICT 05\LEHIGH - 13\10-XX_SHTXX 178_EXIT 54 PLAN
November/13/2023 4:09 PM