DISTRICT	COUNTY	ROUTE	PROJECT	SHEET
5-0	SCHUYLKILL	I-81		
PINE GROVE TOWNSHIP				
REVISIONS				

TABULATION OF QUANTITIES		
ITEM	UNIT	QUANTITY
POST MOUNTED SIGNS, TYPE A, LOGO	SQ.FT.	–
POST MOUNTED SIGNS, TYPE A, LOGO (MODIFIED)	SQ.FT.	–
POST MOUNTED SIGNS, TYPE C, LOGO	SQ.FT.	
BREAKAWAY SYSTEMS	EACH	–
* STEEL S OR W BEAM POSTS	LBS.	–
LOGO SIGN MOUNTING	EACH	–
LOGO SIGN MOUNTING, RESET	EACH	–
REMOVAL OF POST MOUNTED MOTORIST SERVICE SIGNS, TYPES A & E	EACH	–
REMOVAL OF POST MOUNTED MOTORIST SERVICE SIGNS, TYPES B, C & F	L.S.	

* APPROXIMATE QUANTITY FOR INFORMATION ONLY

SYMBOLS

- ○ *Existing Sign to Remain*
- △ *Existing Sign to be Removed*
- □ *Existing Sign Reset as Shown*
- ◪ *Existing Sign Foundation*
- ● NEW SIGN
- × FUTURE SIGN
- Ø *Existing Utility Pole*

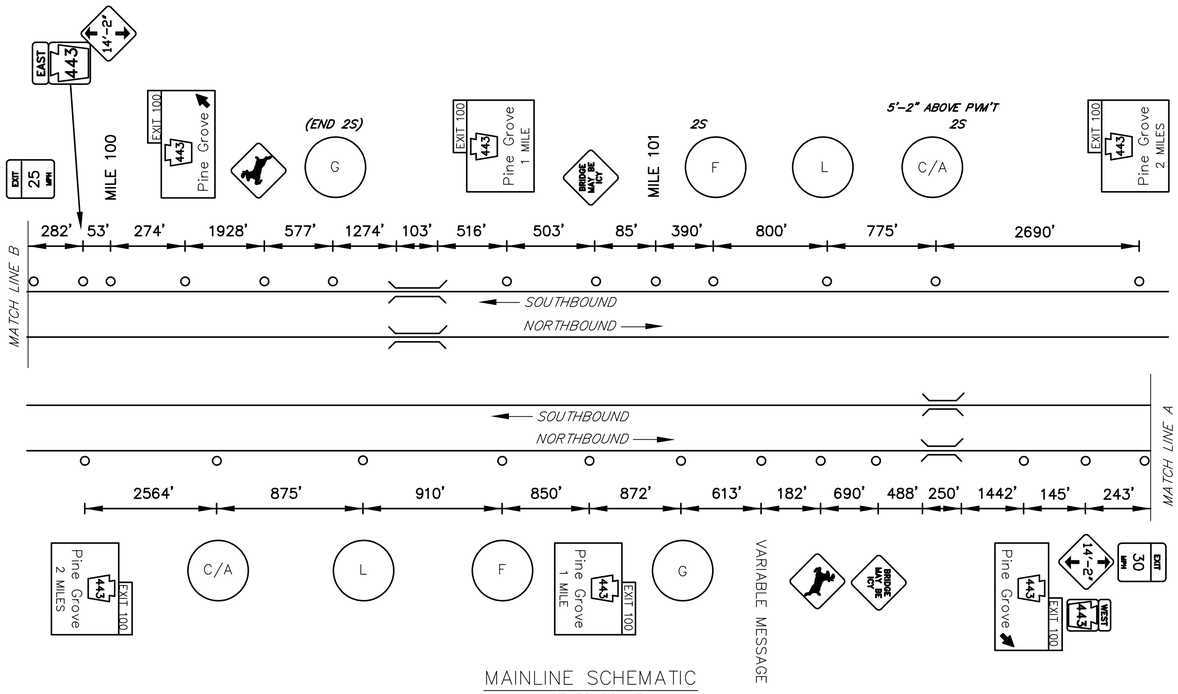

MAINLINE SCHEMATIC
NOT TO SCALE

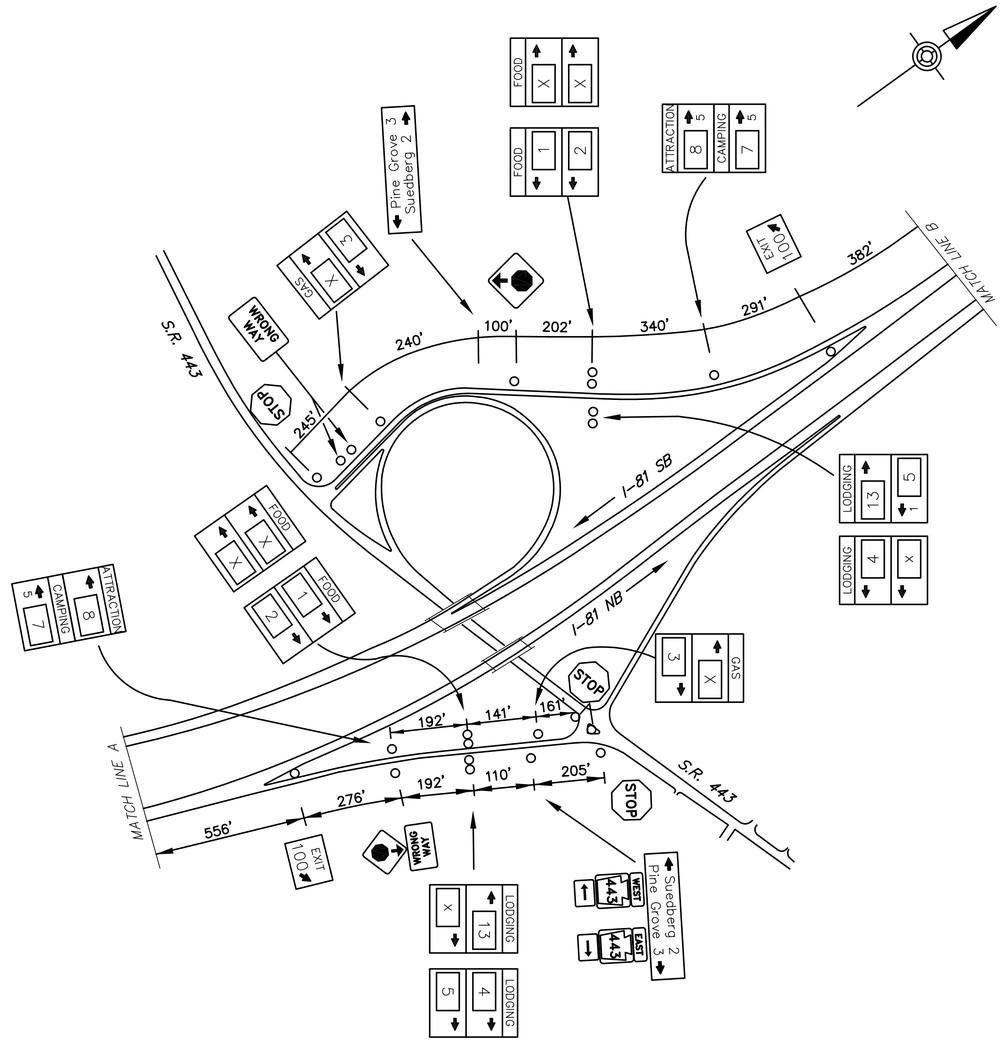

SCHEMATIC PLAN
NOT TO SCALE

INTERSTATE 81

PINE GROVE

EXIT 100

LEGEND

2S – GUIDE RAIL

FREEWAY LANE CLOSURES & RESTRICTIONS ONLY PERMITTED BETWEEN 9:00 PM AND 6:00 AM MONDAY THRU FRIDAY. WORK ALONG FREEWAY PERMITTED BETWEEN 9:00 AM AND 2:30 PM, UNLESS OTHERWISE APPROVED BY ENGINEERING DISTRICT. DO NOT WORK DURING HOLIDAY PERIODS. IF APPLICABLE, REINSTALL GUIDERAIL AT END OF EACH DAY.

EXIT 100 SPECIFIC INFORMATION PANEL			
LEGEND	DIRECTION	BUSINESS	LOGO NO.
GAS	NB/SB		
		SUNOCO (DIESEL)	3
FOOD	NB/SB	McDONALD'S	1
		ARBY'S	2
LODGING	NB/SB	KNIGHTS INN	5
		ECONO LODGE	4
		HAMPTON INN	13
CAMPING	NB/SB	TWIN GROVE RV & COTTAGES	7
ATTRACTION	NB/SB	TWIN GROVE PARK	8

	NB SIGNS		SB SIGNS	
10'Hx13'W FUTURE 16'H W10x26 AVERY TYPE IV B650 – #4, #4	GAS – EXIT 100: 3 X		GAS – EXIT 100: X 3	10'Hx13'W FUTURE 12'H W6x15 3M TYPE III B525 – #4, #4
10'Hx13'W 2' EXPOSED TOP SECTION FUTURE 12'H W8x18 3M TYPE III B525 – ??, ??	FOOD – EXIT 100: 1 2 / X		FOOD – EXIT 100: 2 1 / X	10'Hx13'W FUTURE 12'H W6x15 3M TYPE III B525 – #4, #4
10'Hx13'W FUTURE 16'H W14x30 AVERY TYPE IV B650 – #2, #2	LODGING – EXIT 100: 4 13 / 5		LODGING – EXIT 100: 13 X / 4 5	10'Hx13'W FUTURE 16'H W14x30 3M TYPE III B650 – #1, #2
12'Hx13'W FUTURE 16'H W14x30 B650 – #1, #3	CAMPING–EXIT 100: 7 / ATTRACTION–EXIT 100: 8		CAMPING–EXIT 100: 7 / ATTRACTION–EXIT 100: 8	12'Hx13'W FUTURE 14'H W10x26 B650 – #4, #4

D:\2015_GRS\215076-01\PW\PSE\AS-BUILT DRAWINGS\PENNDOT DISTRICT 05\SCHUYLKILL - 53\10-XX_SHTXX IBL_EXIT 100 PLAN
November/02/2023 12:01 pm