DISTRICT	COUNTY	ROUTE	PROJECT	SHEET
4-0	LUZERNE	I-81		

CITY OF WILKES-BARRE
PLAINS & WILKES-BARRE TOWNSHIPS

REVISIONS

TABULATION OF QUANTITIES		
ITEM	UNIT	QUANTITY
POST MOUNTED SIGNS, TYPE A, LOGO	SQ.FT.	
POST MOUNTED SIGNS, TYPE A, LOGO (MODIFIED)	SQ.FT.	
POST MOUNTED SIGNS, TYPE C, LOGO	SQ.FT.	
BREAKAWAY SYSTEMS	EACH	–
* STEEL S OR W BEAM POSTS	LBS.	–
LOGO SIGN MOUNTING	EACH	
LOGO SIGN MOUNTING, RESET	EACH	
REMOVAL OF POST MOUNTED MOTORIST SERVICE SIGNS, TYPES A & E	EACH	–
REMOVAL OF POST MOUNTED MOTORIST SERVICE SIGNS, TYPES B, C & F	L.S.	

* APPROXIMATE QUANTITY FOR INFORMATION ONLY

SYMBOLS
- Existing Sign to Remain
- Existing Sign to be Removed
- Existing Sign Reset as Shown
- Existing Sign Foundation
- NEW SIGN
- FUTURE SIGN
- Existing Utility Pole

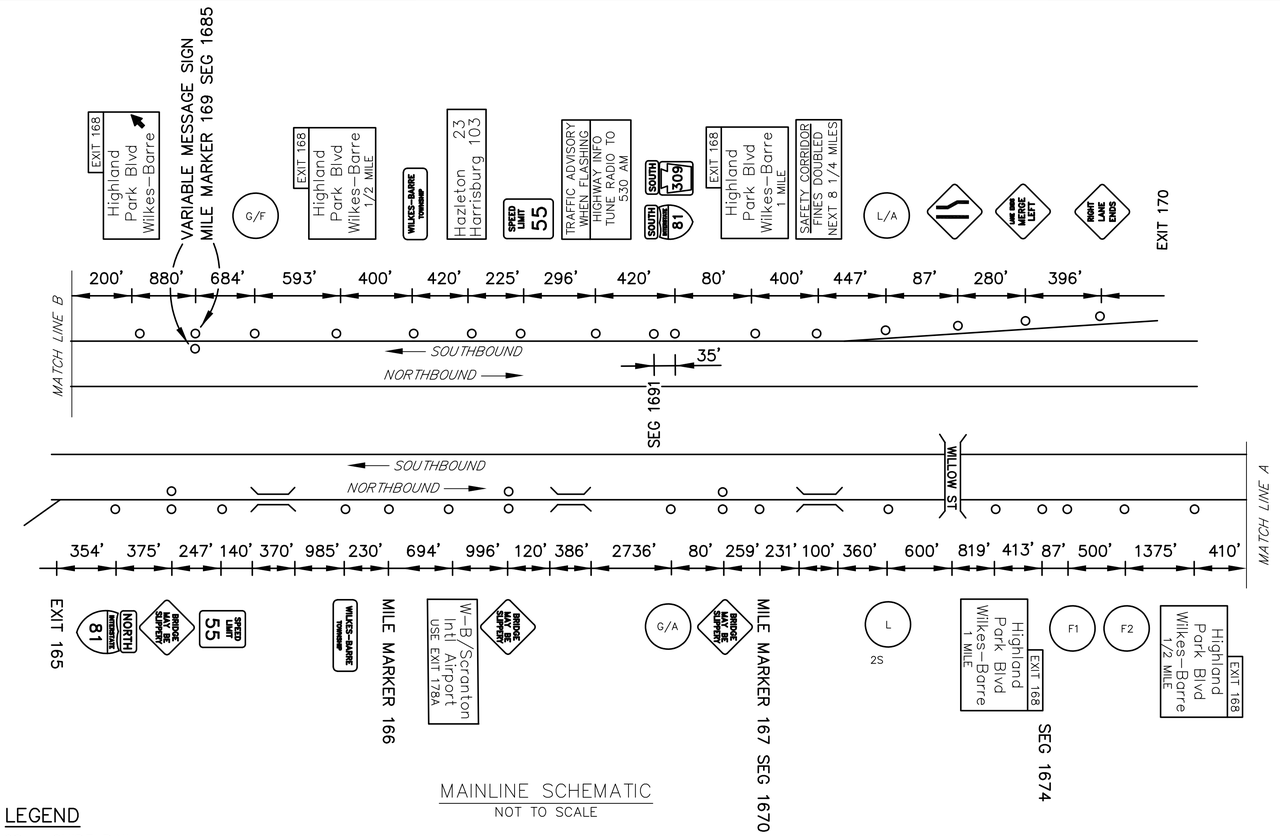

MAINLINE SCHEMATIC
NOT TO SCALE

LEGEND

2S – GUIDE RAIL

FREEWAY LANE CLOSURES & RESTRICTIONS ONLY PERMITTED BETWEEN 9:00 PM AND 6:00 AM MONDAY THRU FRIDAY. WORK ALONG FREEWAY PERMITTED BETWEEN 9:00 AM AND 2:30 PM, UNLESS OTHERWISE APPROVED BY ENGINEERING DISTRICT. DO NOT WORK DURING HOLIDAY PERIODS. IF APPLICABLE, REINSTALL GUIDERAIL AT END OF EACH DAY.

EXIT 168 SPECIFIC INFORMATION PANEL			
LEGEND	DIRECTION	BUSINESS	LOGO NO.
GAS	NB/SB	SHEETZ	1
FOOD	NB	GROTTO PIZZA	4
		WENDY'S	17
		STARBUCKS	5
	NB/SB	CHICK-FIL-A (CLOSED SUNDAYS)	14
		WEGMAN'S MARKET CAFE	2
		RED ROBIN	15
		CRACKER BARREL	18
		APPLEBEE'S	20
LODGING	NB		
		HOME 2 SUITES	12
	NB/SB	COURTYARD – MARRIOTT	6
		MOTEL 6	7
		HAMPTON INN & SUITES	19
		RESIDENCE INN & SUITES	9
ATTRACTION	NB		
		ARENA HUB PLAZA	11
	NB/SB	MOHEGAN SUN ARENA	
			16

NB SIGNS

F2
10'Hx13'W
TOP SECTION 12'H
FUTURE 16'H
W12x26 A572
3M TYPE III
B650 – #1, #1

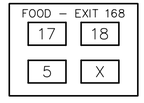

F1
14'Hx13'W
FUTURE 16'H
W12x26 A572
3M TYPE III
B650 –#1, #1

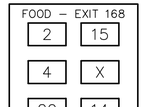

14'Hx13'W
W14x30 A572
3M TYPE III
B650 – #2, #1

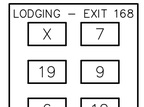

16'Hx13'W
W16x31 A572
B650 – #1, #1

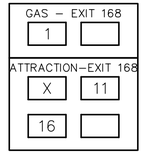

SB SIGNS

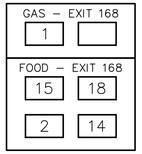

16'Hx13'W
W12x26 A572
AVERY TYPE IV
B650 – #1, #1

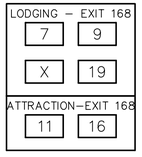

16'Hx13'W
W12x26 A572
3M TYPE III
B650 – #1, #1

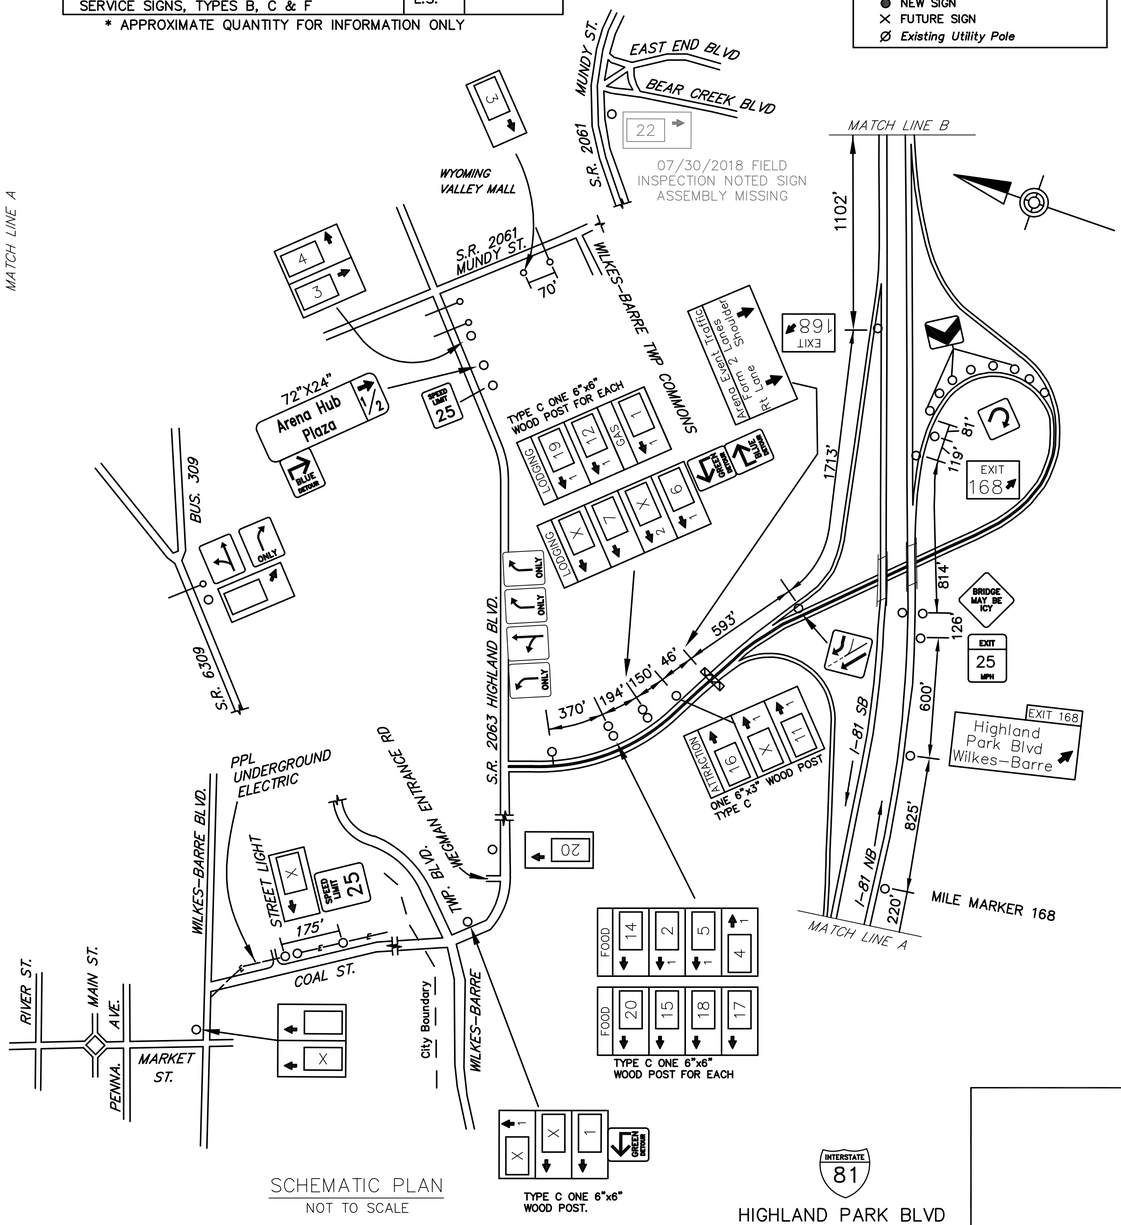

SCHEMATIC PLAN
NOT TO SCALE

INTERSTATE 81

HIGHLAND PARK BLVD
EXIT 168

D:\2015_ADB\215076-01\WW\PSE\AS-BUILT DRAWINGS\PENNDOT DISTRICT 04\LUZERNE - 4010-XX SHTXX-I81_EXIT 168 PLAN
November/7/2023 12:44 PM