DISTRICT	COUNTY	ROUTE	PROJECT	SHEET
4-0	LACKAWANNA	SR 81		
S. ABINGTON TOWNSHIP				
REVISIONS				

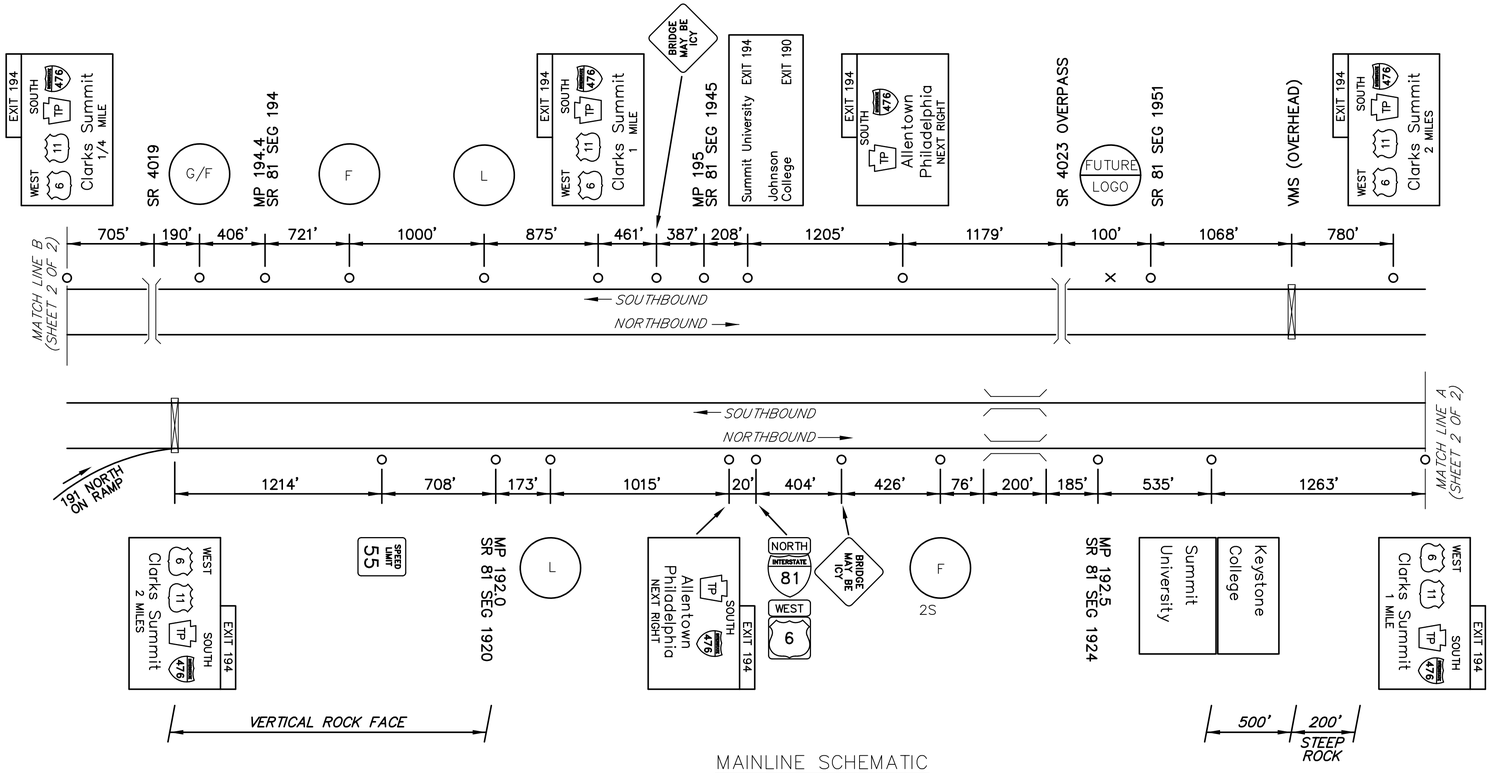

MAINLINE SCHEMATIC
NOT TO SCALE

TABULATION OF QUANTITIES		
ITEM	UNIT	QUANTITY
POST MOUNTED SIGNS, TYPE A, LOGO	SQ.FT.	
POST MOUNTED SIGNS, TYPE A, LOGO (MODIFIED)	SQ.FT.	
POST MOUNTED SIGNS, TYPE C, LOGO	SQ.FT.	
BREAKAWAY SYSTEMS	EACH	–
* STEEL S OR W BEAM POSTS	LBS.	–
LOGO SIGN MOUNTING	EACH	
LOGO SIGN MOUNTING, RESET	EACH	
REMOVAL OF POST MOUNTED MOTORIST SERVICE SIGNS, TYPES A & E	EACH	–
REMOVAL OF POST MOUNTED MOTORIST SERVICE SIGNS, TYPES B, C & F	L.S.	

* APPROXIMATE QUANTITY FOR INFORMATION ONLY

SYMBOLS

- ○ *Existing Sign to Remain*
- △ *Existing Sign to be Removed*
- □ *Existing Sign Reset as Shown*
- ● NEW SIGN
- × FUTURE SIGN
- Ø *Existing Utility Pole*

LEGEND

2S – GUIDE RAIL

FREEWAY LANE CLOSURES & RESTRICTIONS ONLY PERMITTED BETWEEN 9:00 PM AND 6:00 AM MONDAY THRU FRIDAY. WORK ALONG FREEWAY PERMITTED BETWEEN 9:00 AM AND 2:30 PM, UNLESS OTHERWISE APPROVED BY ENGINEERING DISTRICT. DO NOT WORK DURING HOLIDAY PERIODS. IF APPLICABLE, REINSTALL GUIDERAIL AT END OF EACH DAY.

EXIT 194 SPECIFIC INFORMATION PANEL			
LEGEND	DIRECTION	BUSINESS	LOGO NO.
GAS	NB/SB	SHEETZ (DIESEL)	12
FOOD	NB/SB	McDONALD'S	2
		WAFFLE HOUSE (24 HOURS)	3
		MOE'S SOUTHWEST GRILL	7
		WENDY'S	10
		TACO BELL	11
		STARBUCKS	15
		TULLY'S FAMILY RESTAURANT	16
	NB	SUBWAY	13
LODGING	NB/SB	RAMADA	4
		HAMPTON INN	5
		BEST WESTERN PLUS	6

SEE SHEET 2 OF 2 FOR SIGN LOCATION

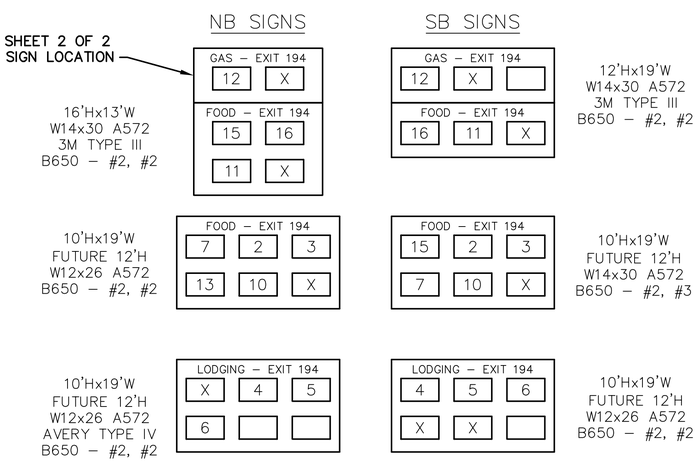

INTERSTATE 81

CLARKS SUMMIT

EXIT 194

SHEET 1 OF 2

O:\2015\085\215076-01\HA\PSE\AS-BUILT DRAWINGS\PENNDOT DISTRICT 04\LACKAWANNA - 35\10-XX SHTOX-I81_EXIT 194 PLAN
November/8/2023 11:41 AM

DISTRICT	COUNTY	ROUTE	PROJECT	SHEET
4-0	LACKAWANNA	SR 81		
S. ABINGTON TOWNSHIP				
REVISIONS				

FREEWAY LANE CLOSURES & RESTRICTIONS ONLY PERMITTED BETWEEN 9:00 PM AND 6:00 AM MONDAY THRU FRIDAY. WORK ALONG FREEWAY PERMITTED BETWEEN 9:00 AM AND 2:30 PM, UNLESS OTHERWISE APPROVED BY ENGINEERING DISTRICT. DO NOT WORK DURING HOLIDAY PERIODS. IF APPLICABLE, REINSTALL GUIDERAIL AT END OF EACH DAY.

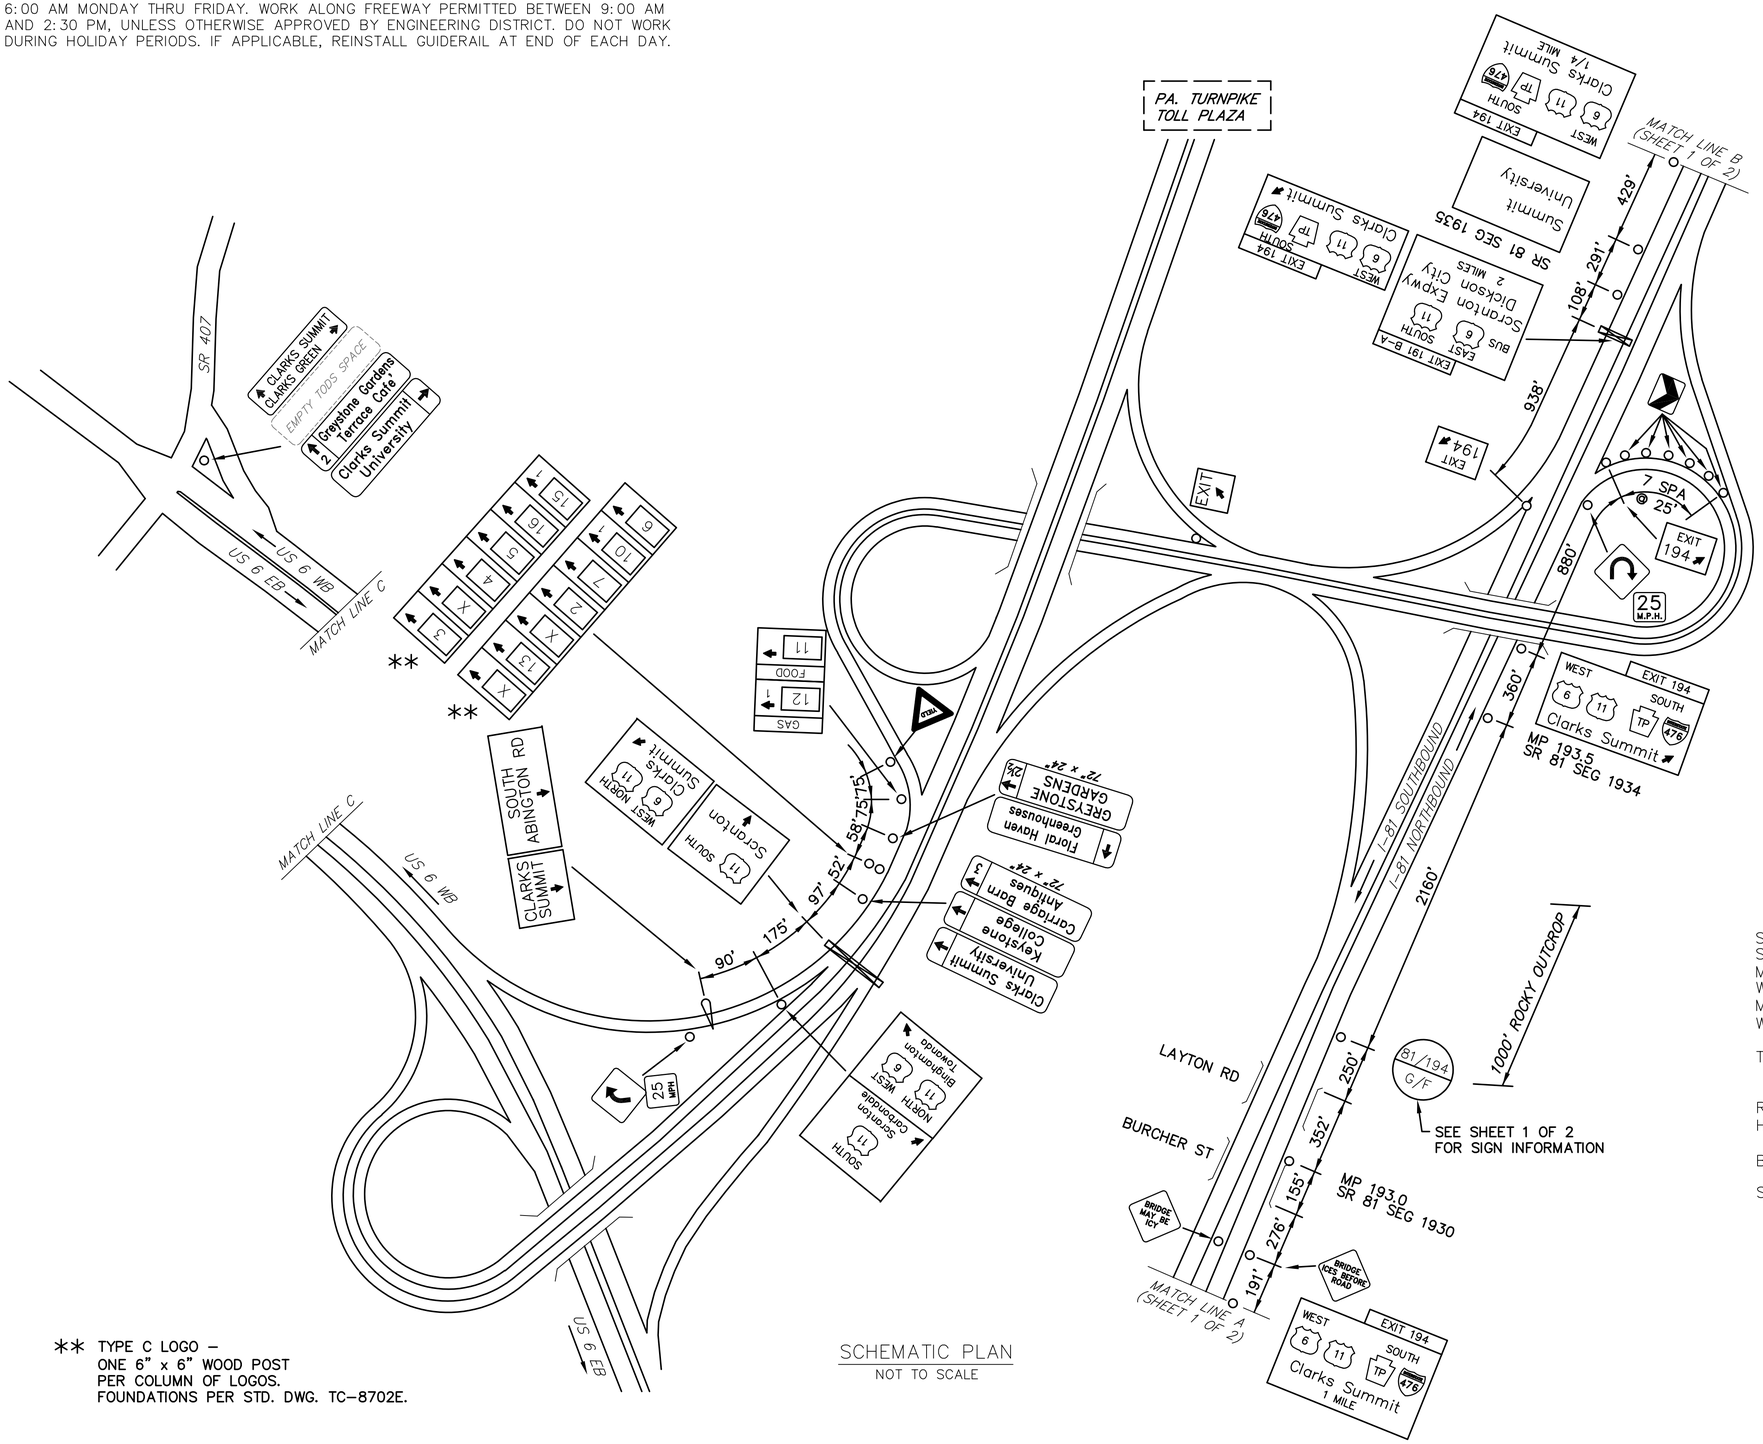

SCHEMATIC PLAN
NOT TO SCALE

** TYPE C LOGO –
ONE 6" x 6" WOOD POST
PER COLUMN OF LOGOS.
FOUNDATIONS PER STD. DWG. TC-8702E.

SYMBOLS

- ○ *Existing Sign to Remain*
- △ *Existing Sign to be Removed*
- □ *Existing Sign Reset as Shown*
- ◪ *Existing Sign Foundation*
- ● NEW SIGN
- × FUTURE SIGN
- Ø *Existing Utility Pole*

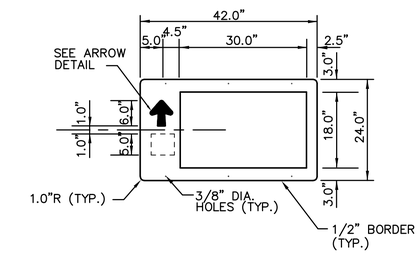

STRAIGHT AHEAD ARROW ON LEFT SIDE DETAIL
NOT TO SCALE

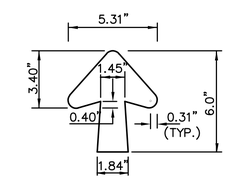

MODIFIED TYPE K ARROW DETAIL
NOT TO SCALE

STARBUCKS	15
SUBWAY	13
McDONALD'S	2
WAFFLE HOUSE	3
MOE'S SW GRILL	7
WENDY'S	10
TULLY'S GOOD TIMES	16
RAMADA	4
HAMPTON INN	5
BEST WESTERN PLUS	6
SHEETZ	12

INTERSTATE 81

CLARKS SUMMIT

EXIT 194

SHEET 2 OF 2

O:\2015\DRS\215076-01\HA\PSE\AS-BUILT DRAWINGS\PENNDOT DISTRICT 04\LACKAWANNA - 35\10-XX SHT0X-I81_EXIT 194 PLAN
November/8/2023 11:46 AM