DISTRICT	COUNTY	ROUTE	PROJECT	SHEET
8-0	DAUPHIN	I-81		
	EAST HANOVER TOWNSHIP			
8-0	LEBANON			
	EAST HANOVER TOWNSHIP			
	REVISIONS			

TABULATION OF QUANTITIES		
ITEM	UNIT	QUANTITY
POST MOUNTED SIGNS, TYPE A, LOGO	SQ.FT.	–
POST MOUNTED SIGNS, TYPE B, LOGO	SQ.FT.	–
POST MOUNTED SIGNS, TYPE C, LOGO	SQ.FT.	–
BREAKAWAY SYSTEMS	EACH	–
* STEEL S OR W BEAM POSTS	LBS.	–
LOGO SIGN MOUNTING	EACH	–
TYPE B SIGNS SUPPLIED BY TRUST	SQ.FT.	–

* APPROXIMATE QUANTITY FOR INFORMATION ONLY

SYMBOLS

- ○ *Existing Sign to Remain*
- △ *Existing Sign to be Removed*
- □ *Existing Sign Reset as Shown*
- ● NEW SIGN
- × FUTURE SIGN
- Ø *Existing Utility Pole*

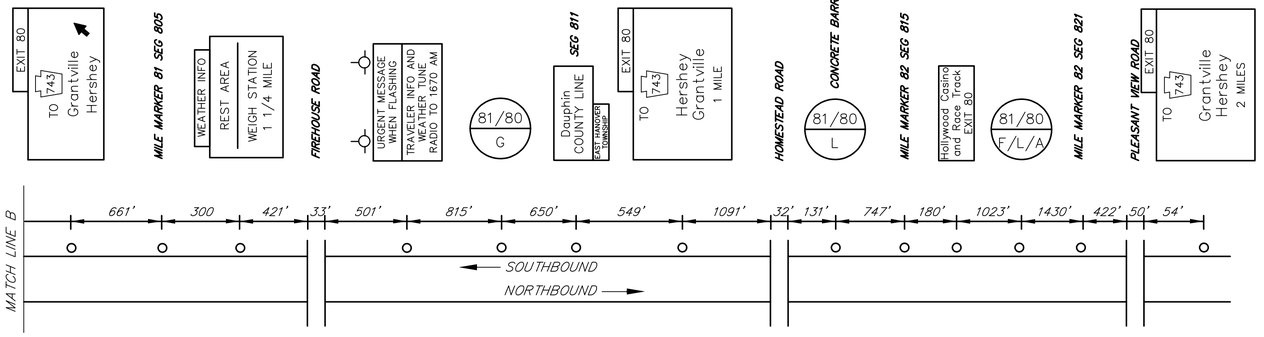

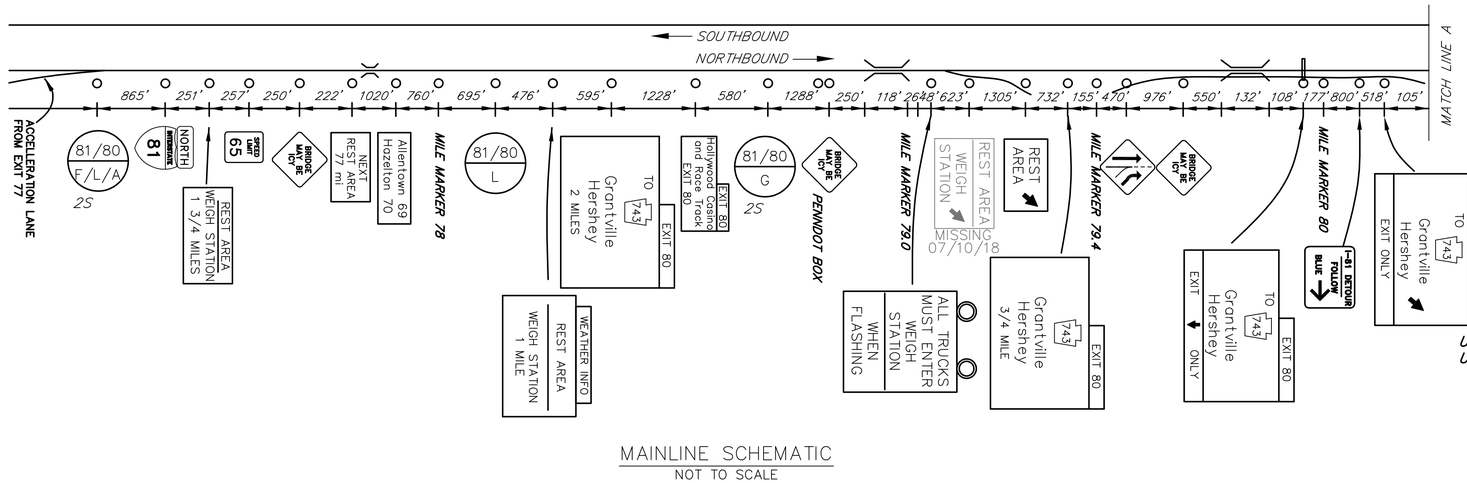

MAINLINE SCHEMATIC
NOT TO SCALE

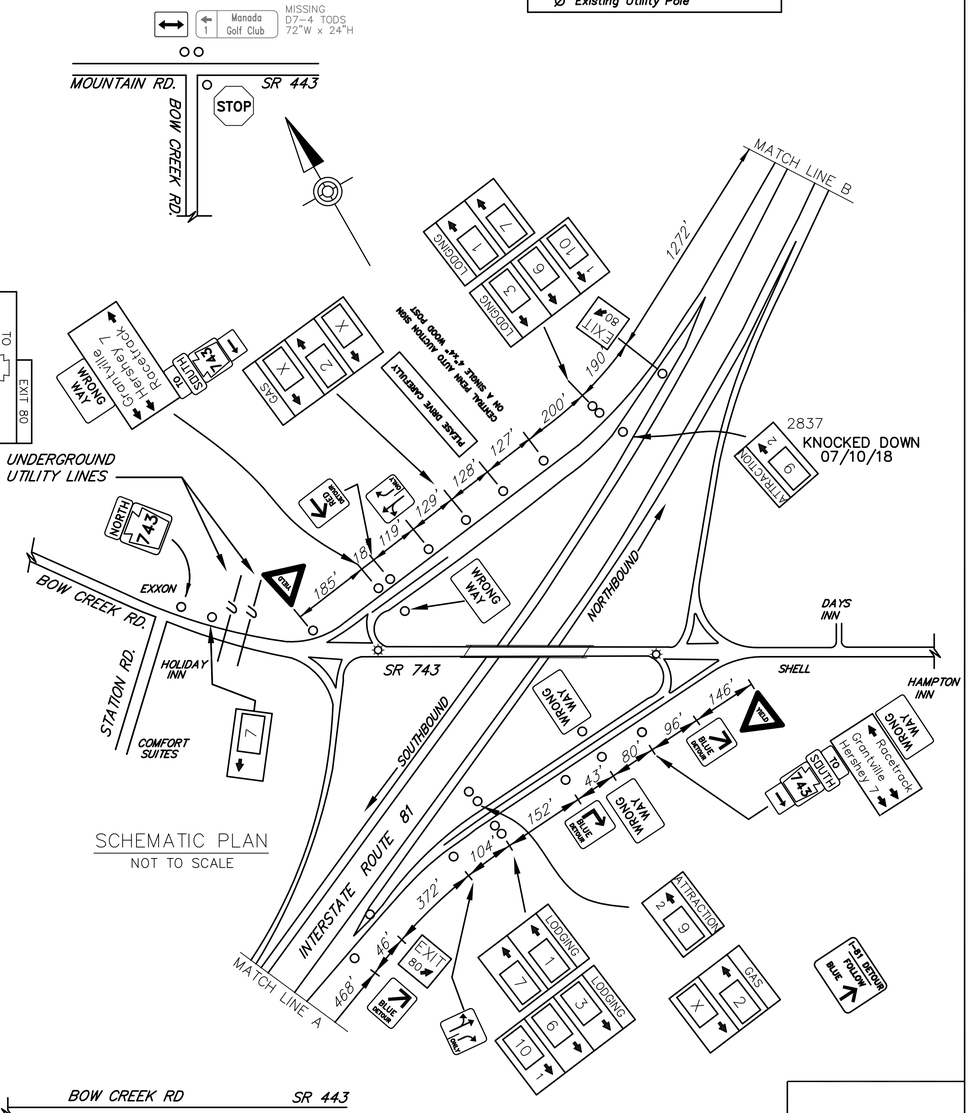

SCHEMATIC PLAN
NOT TO SCALE

FREEWAY LANE CLOSURES & RESTRICTIONS
ONLY PERMITTED BETWEEN 9:00 PM AND
6:00 AM MONDAY THRU FRIDAY.
DO NOT WORK DURING HOLIDAY PERIODS.

EXIT X SPECIFIC INFORMATION PANEL			
LEGEND	DIRECTION	BUSINESS	LOGO NO.
GAS	NB/SB	EXXON (DIESEL/24 HRS)	2
LODGING	NB/SB	HOLIDAY INN	1
		DAYS INN	3
		HAMPTON INN	6
		BEST WESTERN	7
		MAINSTAY SUITES	10
ATTRACTION	NB/SB	MANADA GOLF CLUB	9

NB SIGNS

18'Hx13'W
W18x40 A572
TYPE IX LEGEND
TYPE III
BACKGROUND
B650 – #2, #2

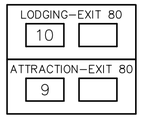

10'Hx13'W
W8x18
3M TYPE III
B525 – #1, #2

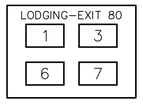

6'Hx16'W
48"W LOGO
FUTURE 10'H
W8x21 A572
3M TYPE III
B525 – #2, #2

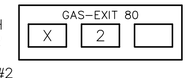

SB SIGNS

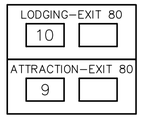

18'Hx13'W
W18x35 A572
TYPE IX LEGEND
TYPE III
BACKGROUND
B650 – #2, #2

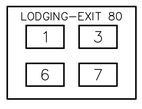

10'Hx13'W
W6x12
FUTURE ?? Lb BURIED
3M TYPE III
B525 – BURIED, #1
2' EXPOSED STEEL
TOP SECTION

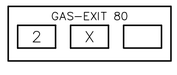

6'Hx16'W
48"W LOGO
FUTURE ?? Lb BURIED
W8x21 A572
3M TYPE III
B525 – BURIED, #2

NB LODGING SIGN RESET BY PENNDOT 1994.

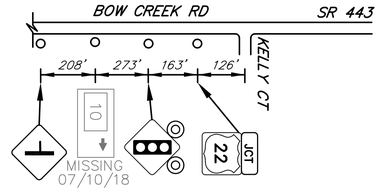

GRANTVILLE
EXIT 80

D:\2015_JOBS\215076-01\HW\PSE\AS-Built DRAWINGS\PENNDOT DISTRICT 08\DAUPHIN - 22\100-DSR SHT10-I81_EXIT 80 PLAN
September/13/2023 1:01 PM