DISTRICT	COUNTY	ROUTE	PROJECT	SHEET
8-0	LEBANON	I-81		
E. HANOVER, S. ANNVILLE AND N. CORNWALL TWPS.				
REVISIONS				

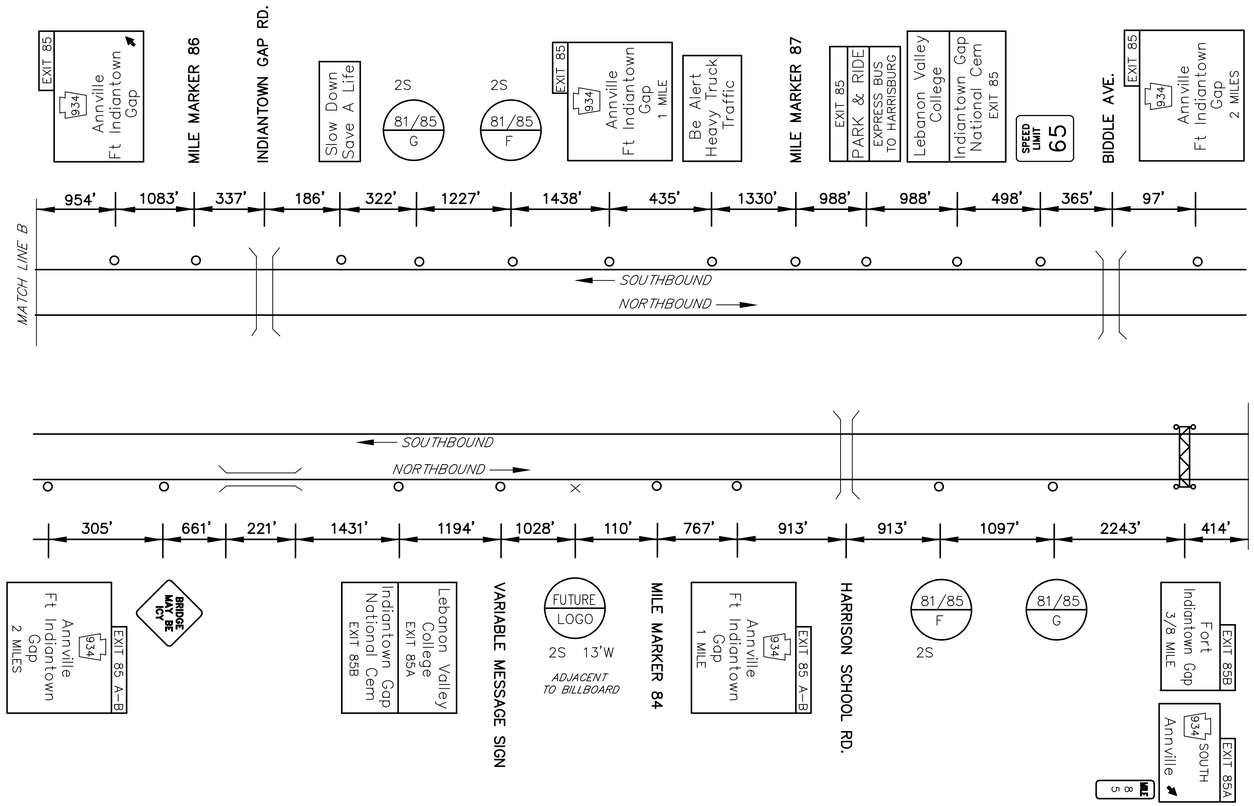

MAINLINE SCHEMATIC
NOT TO SCALE

FREEWAY LANE CLOSURES & RESTRICTIONS
ONLY PERMITTED BETWEEN 9:00 PM AND
6:00 AM MONDAY THRU FRIDAY.
DO NOT WORK DURING HOLIDAY PERIODS.

TABULATION OF QUANTITIES		
ITEM	UNIT	QUANTITY
POST MOUNTED SIGNS, TYPE A, LOGO	SQ.FT.	
POST MOUNTED SIGNS, TYPE B, LOGO	SQ.FT.	
POST MOUNTED SIGNS, TYPE C, LOGO	SQ.FT.	
BREAKAWAY SYSTEMS	EACH	
* STEEL S OR W BEAM POSTS	LBS.	
LOGO SIGN MOUNTING	EACH	
EXTRUDED PANEL REPLACEMENT	SQ.FT.	
REMOVAL OF POST MOUNTED MOTORIST SERVICE SIGNS, TYPES B, C & F	L.S.	

* APPROXIMATE QUANTITY FOR INFORMATION ONLY

SYMBOLS

- ○ *Existing Sign to Remain*
- △ *Existing Sign to be Removed*
- □ *Existing Sign Reset as Shown*
- ● NEW SIGN
- × FUTURE SIGN
- Ø *Existing Utility Pole*

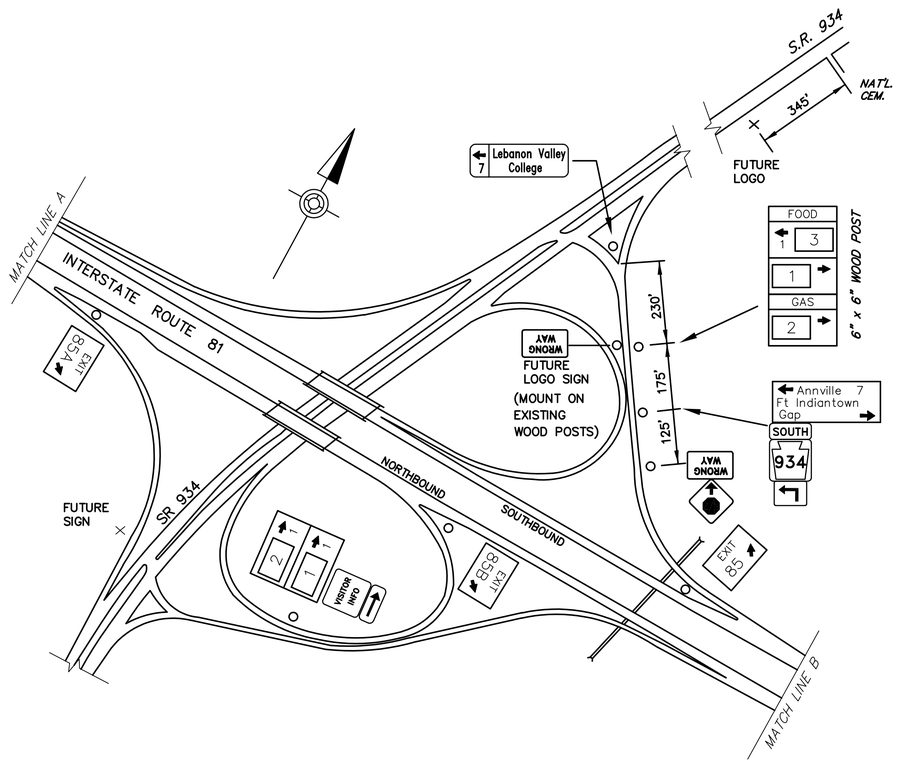

SCHEMATIC PLAN
NOT TO SCALE

EXIT 85 SPECIFIC INFORMATION PANEL			
LEGEND	DIRECTION	BUSINESS	LOGO NO.
GAS	85B NB/SB	FUNCK'S D	2
FOOD	85A NB/SB	HARPER'S TAVERN	3
	85B NB/SB	SNITZ CREEK BREWERY	1

NB SIGNS

12'Hx13'W
W8x21 A572
B525 – #2, #2
✳

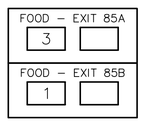

6'Hx16'W
48"W LOGO
FUTURE 12'H
W8x21
B525 – #2, #2

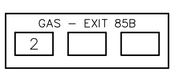

SB SIGNS

6'Hx13'W
FUTURE 10'H
W8x21 A572
B525 – #1, #2
✳

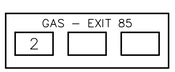

6'Hx16'W
48"W LOGO
FUTURE 10'H
W8x21 A572
BURIED, B525 – #1, #1
✳

✳ NB SIGN RESET BY PENNDOT 1994,
SB SIGNS RESET BY PENNDOT 1995.

INTERSTATE 81
ANNVILLE
EXIT 85

D:\2015\2581\215974-01\MAP\EXIT85-AS-BUILT DRAWINGS-PENNDOT DISTRICT 8\I-81LEBANON - 38\10-XX SHTXX-I81_EXIT 85 PLAN
November/7/2023 3:23 PM