DISTRICT	COUNTY	ROUTE	PROJECT	SHEET
8-0	YORK	I-83		
YORK AND SPRINGFIELD TOWNSHIPS				
REVISIONS				

SOUTHBOUND LOGO SIGNING PERMANENTLY REMOVED SEPT. 2005

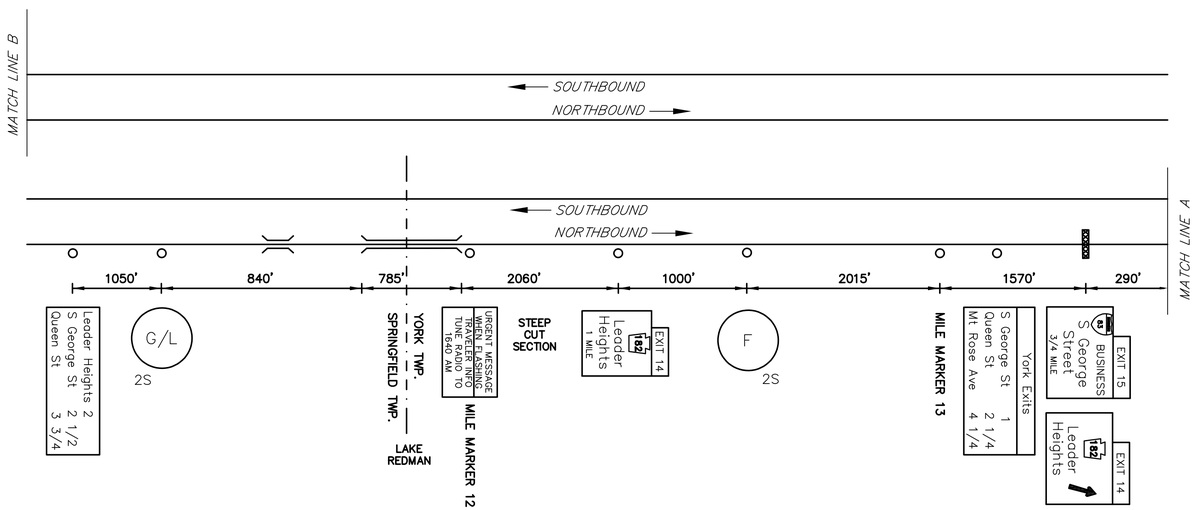

MAINLINE SCHEMATIC
NOT TO SCALE

TABULATION OF QUANTITIES		
ITEM	UNIT	QUANTITY
POST MOUNTED SIGNS, TYPE A, LOGO	SQ.FT.	–
POST MOUNTED SIGNS, TYPE B, LOGO	SQ.FT.	–
POST MOUNTED SIGNS, TYPE C, LOGO	SQ.FT.	–
BREAKAWAY SYSTEMS	EACH	–
* STEEL S OR W BEAM POSTS	LBS.	–
LOGO SIGN MOUNTING	EACH	–
EXTRUDED PANEL REPLACEMENT	SQ.FT.	
REMOVAL OF POST MOUNTED MOTORIST SERVICE SIGNS, TYPES B, C & F	L.S.	

* APPROXIMATE QUANTITY FOR INFORMATION ONLY

SYMBOLS

- ○ *Existing Sign to Remain*
- △ *Existing Sign to be Removed*
- □ *Existing Sign Reset as Shown*
- ● NEW SIGN
- × FUTURE SIGN
- Ø *Existing Utility Pole*

NON-STANDARD BACKPANELS AND HEADERS (EACH SERVICE ONE PANEL INSTEAD OF TWO). TYPE C INSTALLATION.

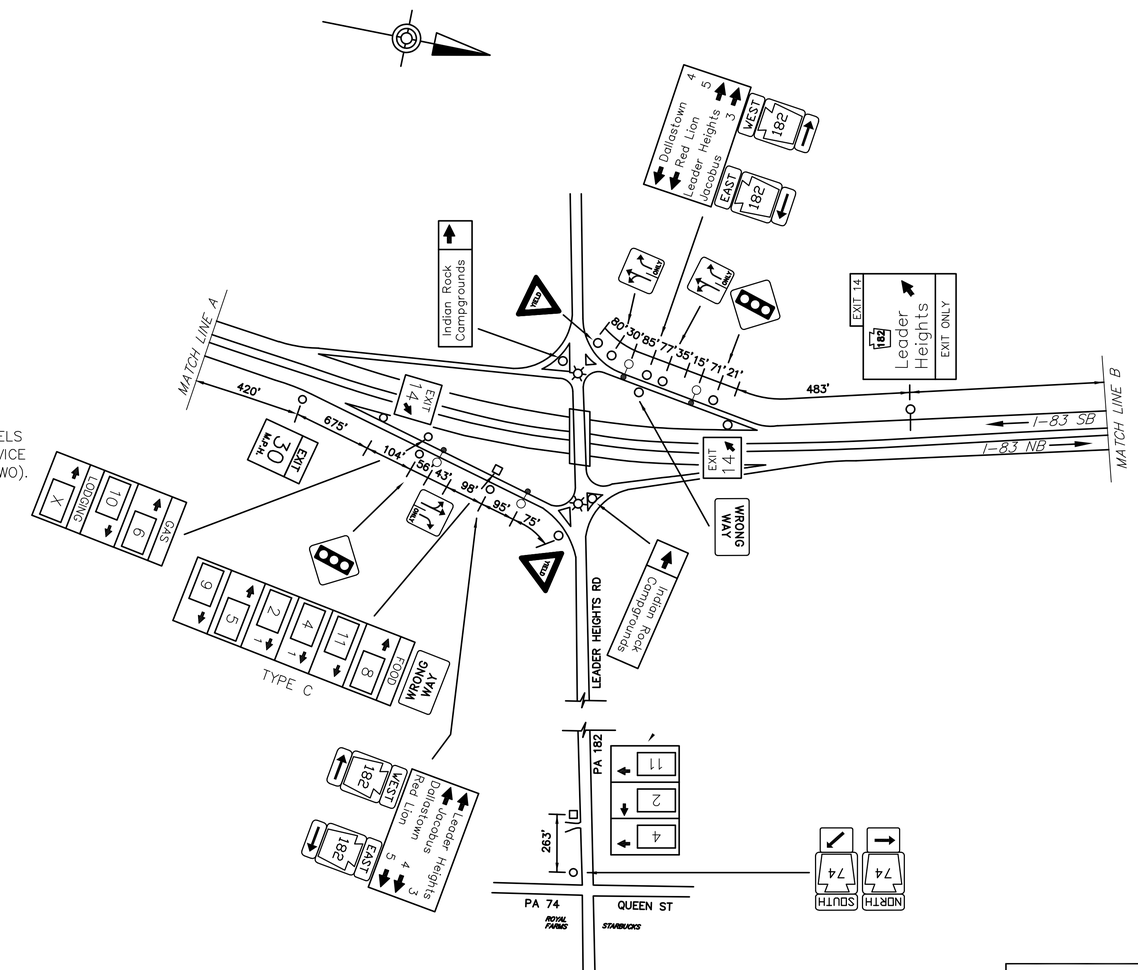

SCHEMATIC PLAN
NOT TO SCALE

FREEWAY LANE CLOSURES & RESTRICTIONS ONLY PERMITTED BETWEEN 9:00 PM AND 6:00 AM MONDAY THRU FRIDAY. DO NOT WORK DURING HOLIDAY PERIODS.

EXIT 14 SPECIFIC INFORMATION PANEL			
LEGEND	DIRECTION	BUSINESS	LOGO NO.
GAS	NB	RUTTER'S (24 HRS/DIESEL)	6
		SHEETZ (DIESEL)	10
FOOD	NB	McDONALD'S	8
		DUNKIN DONUTS	11
		STARBUCKS	4
		ROYAL FARMS (24 HRS)	2
		RUTTER'S	5
		SHEETZ (#615)	9
LODGING	NB		

NB SIGNS

14'Hx13'W
W14x30
3M TYPE III
B650 – #1, #1
RESET 2008/2013

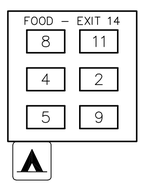

12'Hx13'W
W8x21 A572
3M TYPE III
B525 – #2, #2
RESET 2008/2013

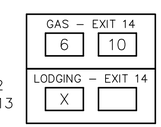

INTERSTATE 83

LEADER HEIGHTS

EXIT 14

D:\2015\JOBS\215076-01\Wx\PSE\AS-BUILT DRAWINGS\PENNDOT DISTRICT 08\YORK - 66\10-XX SHT0X-I83_EXIT 14 PLAN
November/15/2023 9:34 AM