DISTRICT	COUNTY	ROUTE	PROJECT	SHEET
1-0	ERIE	I-90		

SUMMIT TOWNSHIP

REVISIONS

TABULATION OF QUANTITIES		
ITEM	UNIT	QUANTITY
POST MOUNTED SIGNS, TYPE A, LOGO	SQ.FT.	
POST MOUNTED SIGNS, TYPE B, LOGO	SQ.FT.	–
POST MOUNTED SIGNS, TYPE C, LOGO	SQ.FT.	–
BREAKAWAY SYSTEMS	EACH	–
* STEEL S OR W BEAM POSTS	LBS.	–
LOGO SIGN MOUNTING	EACH	–
FLAT SHEET PANEL REPLACEMENT	SQ. FT.	–
EXTRUDED PANEL REPLACEMENT	SQ. FT.	–
REMOVAL OF POST MOUNTED MOTORIST SERVICE SIGNS, TYPES B, C & F	L.S.	–

* APPROXIMATE QUANTITY FOR INFORMATION ONLY

SYMBOLS

- *Existing Sign to Remain*
- *Existing Sign to be Removed*
- *Existing Sign Reset as Shown*
- NEW SIGN
- FUTURE SIGN
- *Existing Utility Pole*

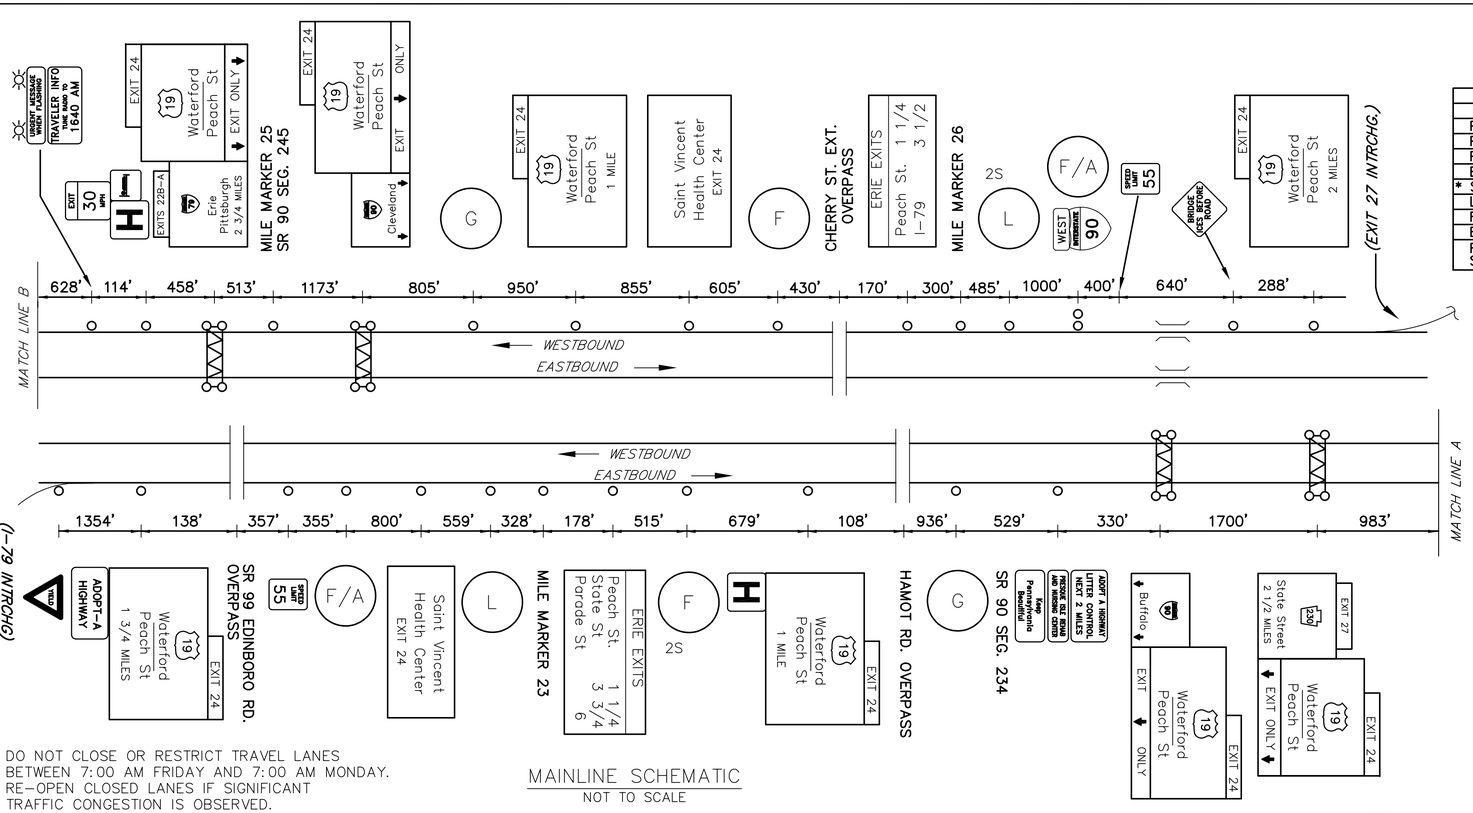

DO NOT CLOSE OR RESTRICT TRAVEL LANES
BETWEEN 7:00 AM FRIDAY AND 7:00 AM MONDAY.
RE-OPEN CLOSED LANES IF SIGNIFICANT
TRAFFIC CONGESTION IS OBSERVED.
DO NOT WORK DURING HOLIDAY PERIODS.

MAINLINE SCHEMATIC
NOT TO SCALE

EXIT 24 SPECIFIC INFORMATION PANEL			
LEGEND	DIRECTION	BUSINESS	LOGO NO.
GAS	EB/WB	GETGO	27
		COUNTRY FAIR GITGO (DIESEL)	10
		SHELL (DIESEL)	15
		DELTA SONIC (CAR WASH)	22
FOOD	EB/WB	EAT'N PARK (24 HRS)	25
		APPLEBEE'S	3
		QUAKER STEAK & LUBE	17
		TGI FRIDAYS	31
		STARBUCKS	30
		BURGER KING	2
		IHOP	29
		CRACKER BARREL	9
	EB	BOB EVANS RESTAURANT	6
		GOLDEN CORRAL	24
	WB	TACO BELL	1
LODGING	EB/WB	COUNTRY INN AND SUITES	8
		HOLIDAY INN EXPRESS	21
	EB	COMFORT INN & SUITES	7
		HAWTHORN SUITES – WYNDHAM	13
	WB	COURTYARD BY MARRIOTT	20
		HILTON GARDEN INN	19
ATTRACTION	EB/WB	MILLCREEK MALL	28
		SPLASH LAGOON	18

EB SIGNS

WB SIGNS

10'Hx19'W
12' TOP SECTION
FUTURE 12'H
W14x30 A572
3M TYPE III
B650 – #2, #2

GAS – EXIT 24: 15 | 10 | 27 / 22

GAS – EXIT 24: 15 | 10 | 27 / 22

10'Hx19'W
12' TOP SECTION
FUTURE 12'H
W12x26 A572
3M TYPE III
B650 – #2, #2

10'Hx19'W
W8x21 A572
B525 – #2, #2

FOOD – EXIT 24: 6 | 17 | 3 / 24 | 9 | 30

FOOD – EXIT 24: 17 | 3 / 2 | 30 / 9 | 31

14'Hx13'W
W10x22
B650 – #1, #1

14'Hx13'W
W12x26
B650 – #2, #2

LODGING – EXIT 24: 8 | X / 13 | 7 / 21 | X

LODGING – EXIT 24: 19 | 8 / X | 20 / 21 | X

14'Hx13'W
W14x30
3M TYPE III
B650 – #1, #1

12'Hx19'W
W12x26 A572
3M TYPE III
B650 – #2, #2

FOOD – EXIT 24: 29 | 25 | 2
ATTRACTION – EXIT 24: 28 | 18 | X

FOOD – EXIT 24: 29 | 25 | 1
ATTRACTION – EXIT 24: 28 | 18 | X

12'Hx19'W
W14x30 A572
3M TYPE III
B650 – #2, #3

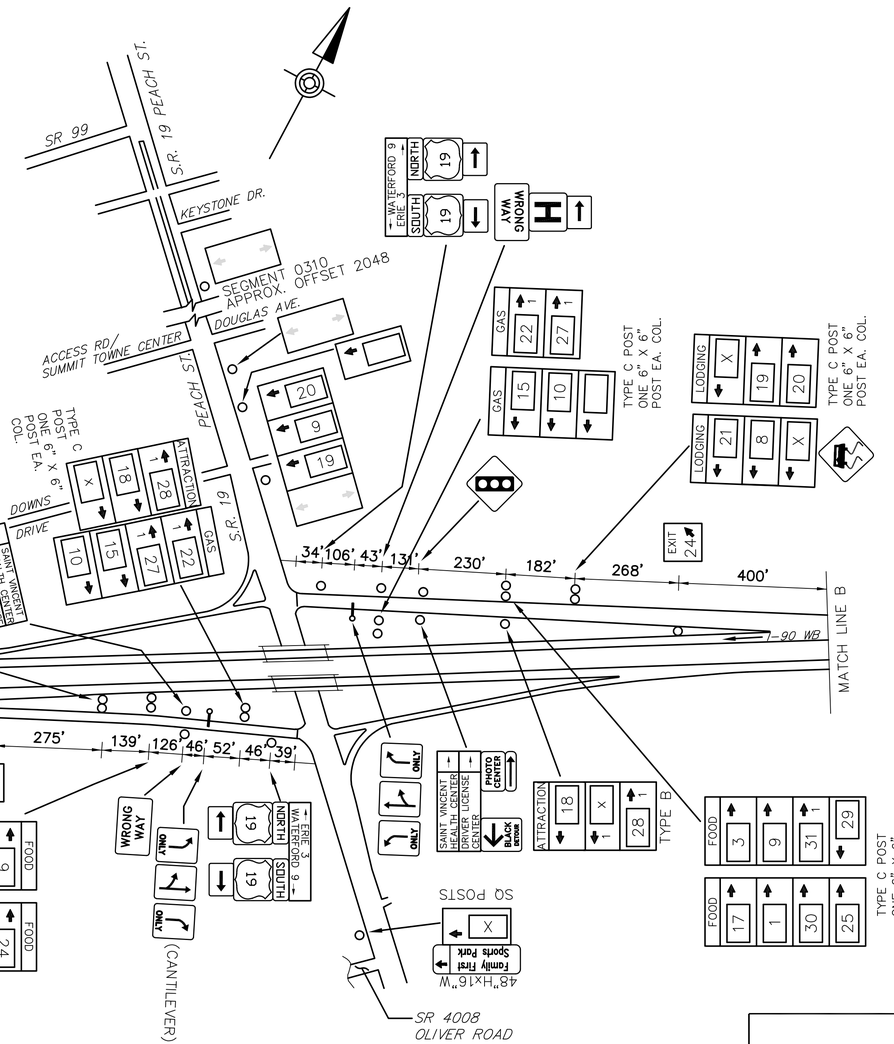

SCHEMATIC PLAN
NOT TO SCALE

INTERSTATE 90

PEACH STREET

EXIT 24

D:\2015\DBS\215276-01\PW\PSE\AS-Built DRAWINGS\PENNDOT DISTRICT 01\ERIE - 25\10-XX SHTXX-190_EXIT 24 PLAN
November/15/2023 9:59 AM