DISTRICT	COUNTY	ROUTE	PROJECT	SHEET
1-0	ERIE	I-90		
GREENE & SUMMIT TOWNSHIPS				
REVISIONS				

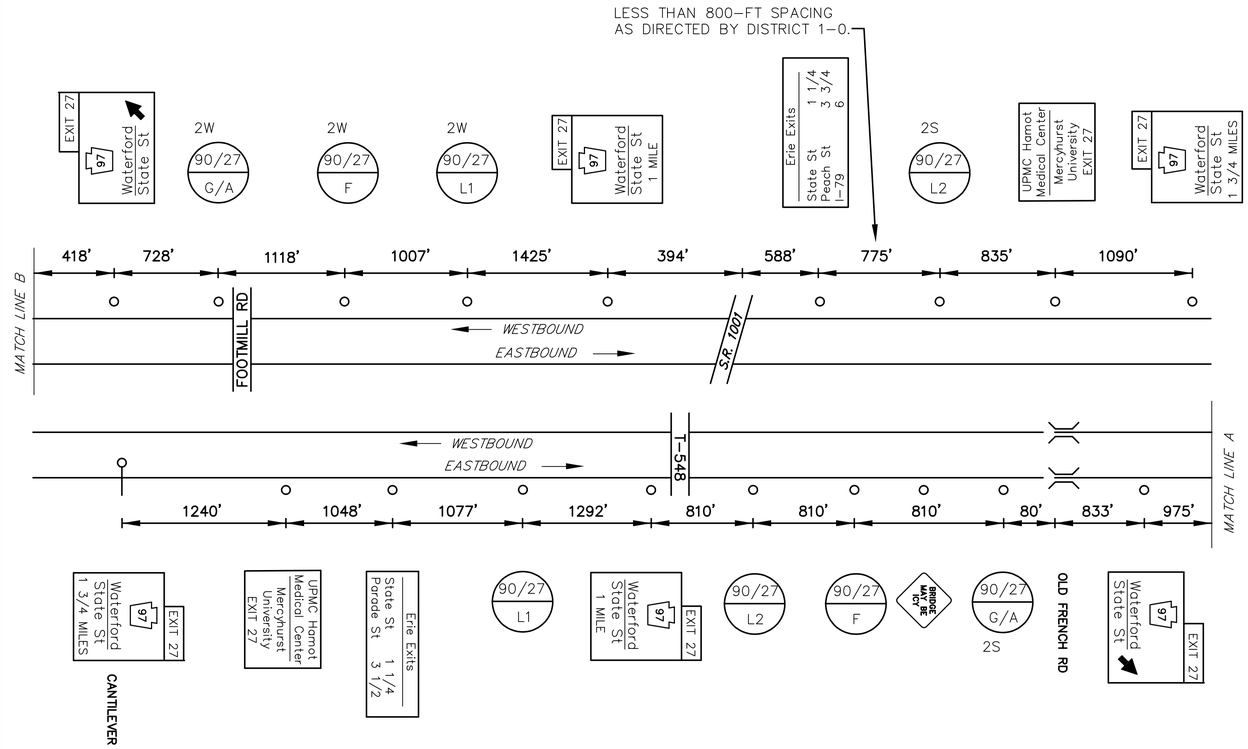

MAINLINE SCHEMATIC
NOT TO SCALE

TABULATION OF QUANTITIES		
ITEM	UNIT	QUANTITY
POST MOUNTED SIGNS, TYPE A, LOGO	SQ.FT.	
POST MOUNTED SIGNS, TYPE B, LOGO	SQ.FT.	
POST MOUNTED SIGNS, TYPE C, LOGO	SQ.FT.	
BREAKAWAY SYSTEMS	EACH	
* STEEL S OR W BEAM POSTS	LBS.	
LOGO SIGN MOUNTING	EACH	
RESET EXISTING POST MOUNTED SIGNS, TYPE A	EACH	

* APPROXIMATE QUANTITY FOR INFORMATION ONLY

SYMBOLS

- ○ *Existing Sign to Remain*
- △ *Existing Sign to be Removed*
- □ *Existing Sign Reset as Shown*
- ● NEW SIGN
- × FUTURE SIGN
- Ø *Existing Utility Pole*

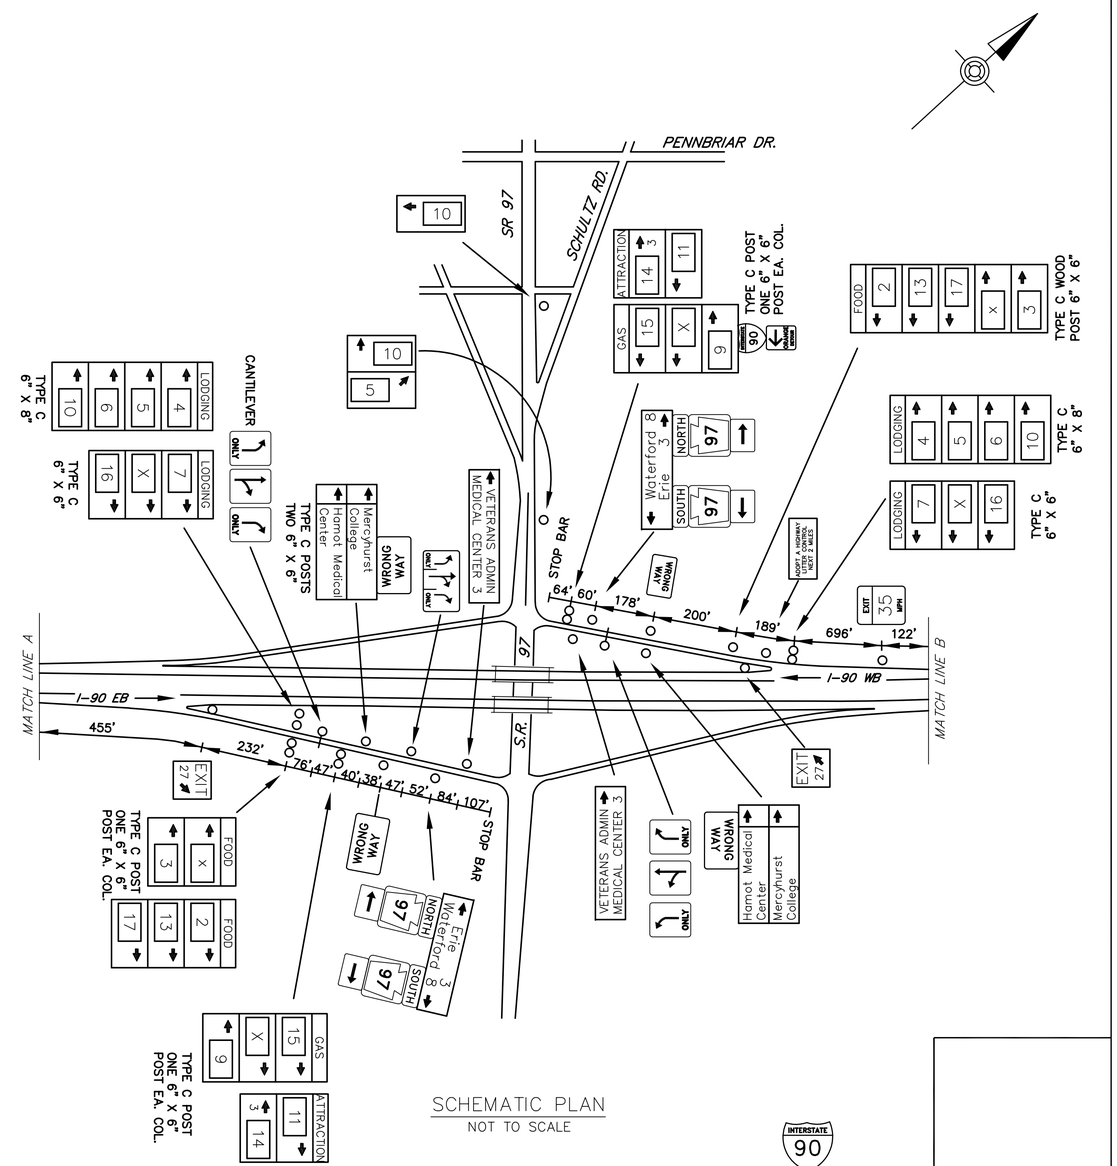

SCHEMATIC PLAN
NOT TO SCALE

DO NOT CLOSE OR RESTRICT TRAVEL LANES
BETWEEN 7:00 AM FRIDAY AND 7:00 AM MONDAY.
RE-OPEN CLOSED LANES IF SIGNIFICANT
TRAFFIC CONGESTION IS OBSERVED.
DO NOT WORK DURING HOLIDAY PERIODS.

EXIT 27 SPECIFIC INFORMATION PANEL			
LEGEND	DIRECTION	BUSINESS	LOGO NO.
GAS	EB/WB	COUNTRY FAIR CITGO (DIESEL)	9
		SHEETZ (DIESEL)	15
FOOD	EB/WB	McDONALD'S (24 HRS)	1
		SUBWAY (24 HRS)	2
		ARBY'S	3
		TIM HORTON'S CAFE & BAKE SHOP	13
		TACO BELL	17
LODGING	EB/WB	BAYMONT INN & SUITES	16
		RED ROOF INN	4
		DAYS INN	6
		QUALITY INN	7
		MOTEL 6	5
		LA QUINTA	10
ATTRACTION	EB/WB	PRESQUE ISLE DOWNS & CASINO	11
		ERIE ZOO	14

EB SIGNS

16'Hx13'W
W10x26
B650 – #1, #1

GAS – EXIT 27: 9, X, 15
ATTRACTION–EXIT 27: 11, 14

14'Hx13'W
FUTURE 16'H
W10x26
B650 – #1, #1

FOOD – EXIT 27: X, 3, 2, 13, 17

L2
6'Hx13'W
FUTURE 16'H
W14x30
TYPE IX LEGEND
TYPE III
BACKGROUND
B650 – #1, #2

LODGING – EXIT 27: 16

L1
14'Hx13'W
FUTURE 16'H
W10x26
B650 – #1, #1

LODGING – EXIT 27: 7, X, 4, 5, 6, 10

WB SIGNS

16'Hx13'W
W14x30
B650 – #2, #2

GAS – EXIT 27: 9, X, 15
ATTRACTION–EXIT 27: 11, 14

14'Hx13'W
FUTURE 14'H
W12x26
B650 – #2, #1

FOOD – EXIT 27: X, 3, 2, 13, 17

L1
14'Hx13'W
W12x26
B650 – #2, #1

LODGING – EXIT 27: 4, 5, 6, 10, 7, X

L2
6'Hx13'W
FUTURE 16'H
W18x40
TYPE IX LEGEND
TYPE III
BACKGROUND
B650 – #3, #3

LODGING – EXIT 27: 16

INTERSTATE 90

STATE STREET
EXIT 27

D:\2015_JOBS\235076-01\WA\PSEL\AS-BUILT DRAWINGS\PENNDOT DISTRICT 01\ERIE - 25\10-XX SHT0X-190_EXIT 27 PLAN
September/12/2023 3:41 PM