DISTRICT	COUNTY	ROUTE	PROJECT	SHEET
6-0	DELAWARE	I-95		
UPPER CHICHESTER TOWNSHIP				
REVISIONS				

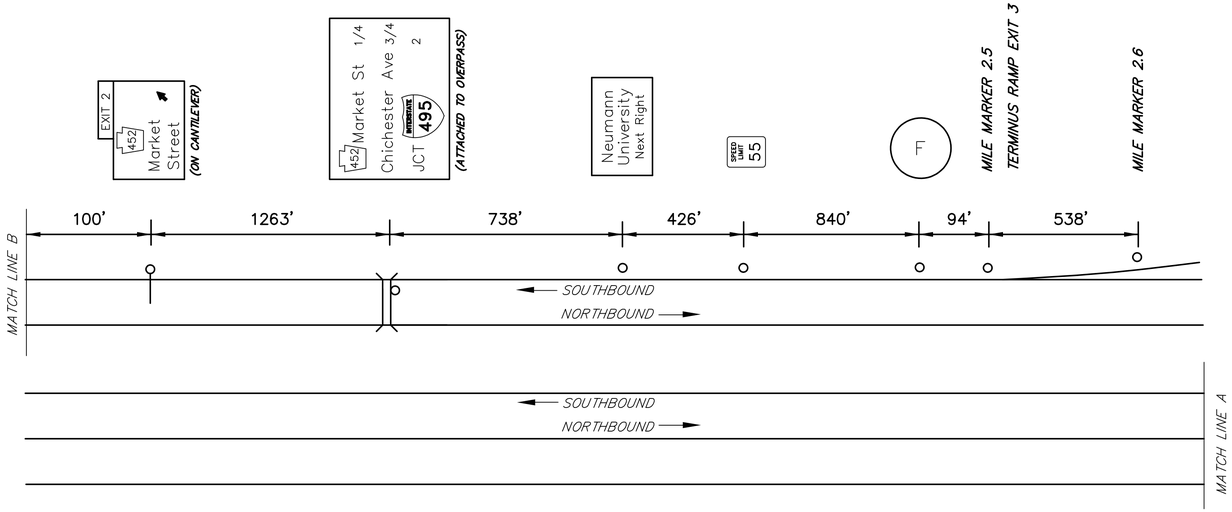

NB NOT ELIGIBLE – INSUFFICIENT SPACE – VERIFIED DEC 2013

MAINLINE SCHEMATIC
NOT TO SCALE

TABULATION OF QUANTITIES		
ITEM	UNIT	QUANTITY
POST MOUNTED SIGNS, TYPE A, LOGO	SQ.FT.	
POST MOUNTED SIGNS, TYPE B, LOGO	SQ.FT.	
POST MOUNTED SIGNS, TYPE C, LOGO	SQ.FT.	
BREAKAWAY SYSTEMS	EACH	
* STEEL S OR W BEAM POSTS	LBS.	
LOGO SIGN MOUNTING	EACH	
REMOVAL OF POST MOUNTED MOTORIST SERVICE SIGNS, TYPES A & E	EACH	
REMOVAL OF POST MOUNTED MOTORIST SERVICE SIGNS, TYPES B, C & F	L.S.	

* APPROXIMATE QUANTITY FOR INFORMATION ONLY

SYMBOLS

- ○ *Existing Sign to Remain*
- △ *Existing Sign to be Removed*
- □ *Existing Sign Reset as Shown*
- ● NEW SIGN
- × FUTURE SIGN
- Ø *Existing Utility Pole*

EXIT 2 SPECIFIC INFORMATION PANEL			
LEGEND	DIRECTION	BUSINESS	LOGO NO.
FOOD	SB	DUNKIN' DONUTS	2
		ROYAL FARMS	3
		MCDONALD'S	1

10'Hx13'W
W6x15 A572
B525 – #1, #1

SB SIGNS

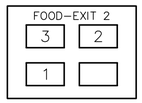

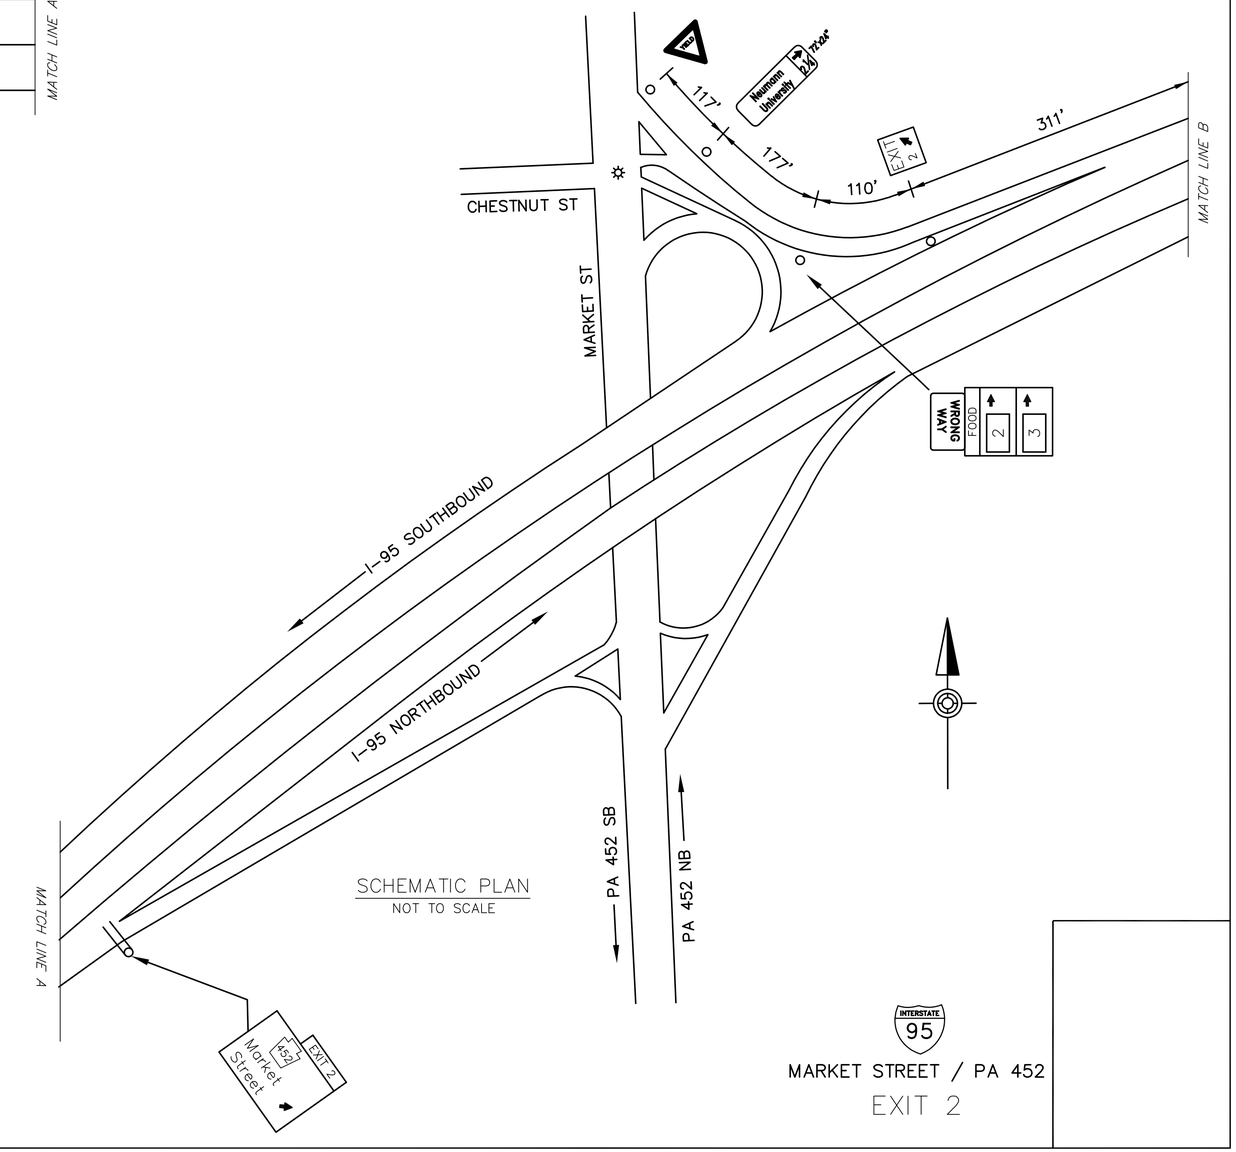

SCHEMATIC PLAN
NOT TO SCALE

INTERSTATE 95

MARKET STREET / PA 452
EXIT 2

D:\2015JB31215276-01\HW\PSE\AS-BUILT DRAWINGS\PENNDOT DISTRICT 06\DELAWARE - 23\10-XX SHTXX-195_EXIT 2 PLAN
June/14/2023 9:38 AM