DISTRICT	COUNTY	ROUTE	PROJECT	SHEET
8-0	CUMBERLAND	US 15		
LOWER ALLEN AND UPPER ALLEN TOWNSHIPS				
REVISIONS				

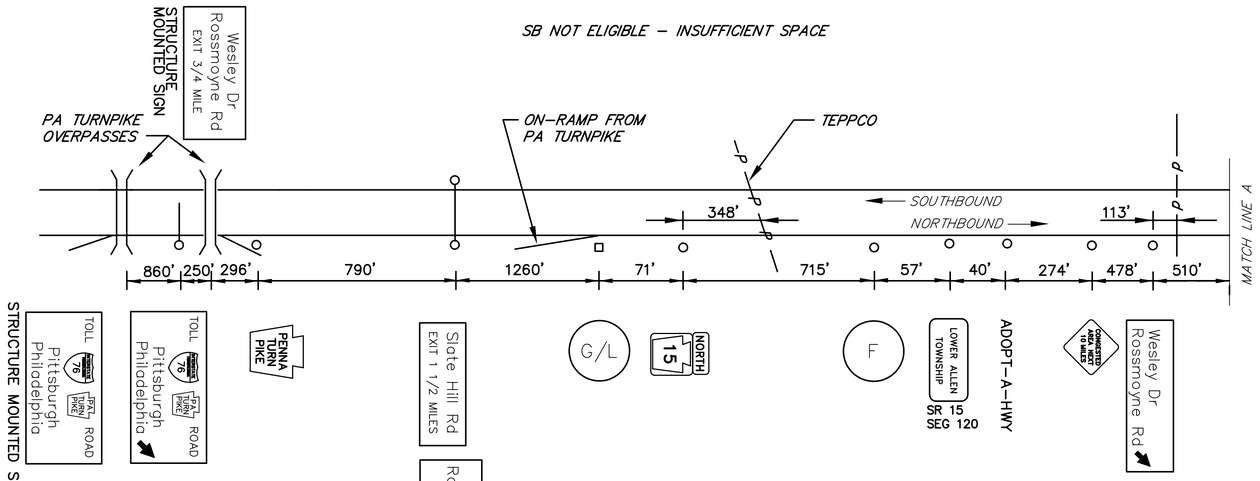

MAINLINE SCHEMATIC
NOT TO SCALE

TABULATION OF QUANTITIES		
ITEM	UNIT	QUANTITY
POST MOUNTED SIGNS, TYPE A, LOGO	SQ.FT.	–
POST MOUNTED SIGNS, TYPE B, LOGO	SQ.FT.	–
POST MOUNTED SIGNS, TYPE C, LOGO	SQ.FT.	–
BREAKAWAY SYSTEMS	EACH	–
* STEEL S OR W BEAM POSTS	LBS.	–
LOGO SIGN MOUNTING	EACH	–
EXTRUDED PANEL REPLACEMENT	SQ.FT.	
REMOVAL OF POST MOUNTED MOTORIST SERVICE SIGNS, TYPES B, C & F	L.S.	

* APPROXIMATE QUANTITY FOR INFORMATION ONLY

SYMBOLS

- ○ *Existing Sign to Remain*
- △ *Existing Sign to be Removed*
- □ *Existing Sign Reset as Shown*
- ● NEW SIGN
- × FUTURE SIGN
- Ø *Existing Utility Pole*

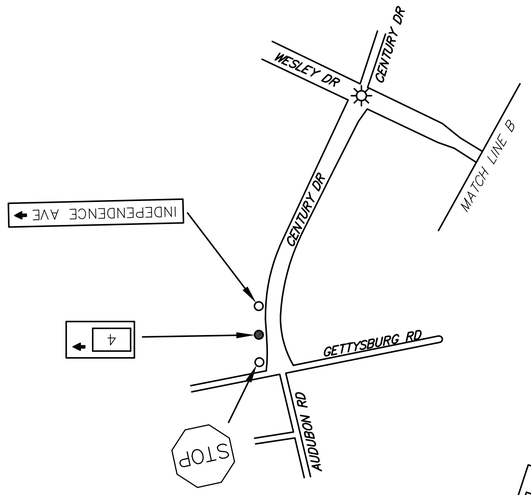

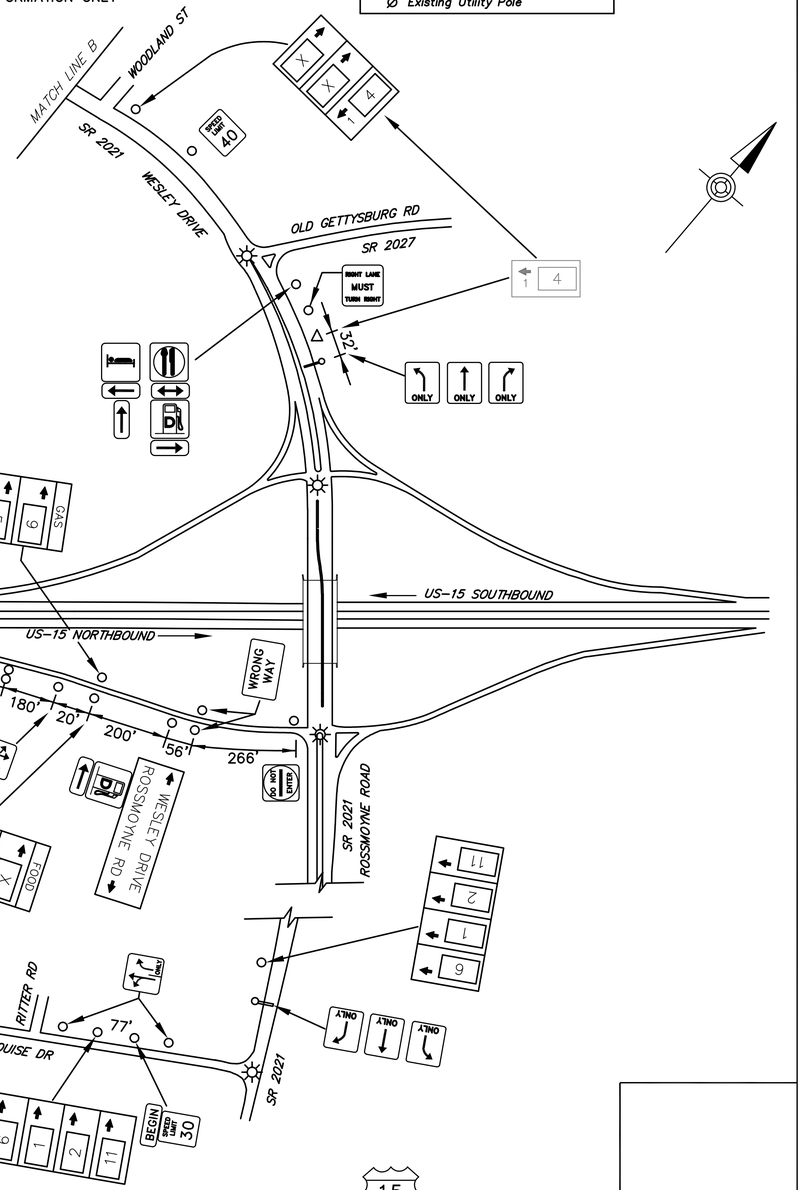

SCHEMATIC PLAN
NOT TO SCALE

FREEWAY LANE CLOSURES & RESTRICTIONS
ONLY PERMITTED BETWEEN 9:00 PM AND
6:00 AM MONDAY THRU FRIDAY.
DO NOT WORK DURING HOLIDAY PERIODS.

ROSSMOYNE SPECIFIC INFORMATION PANEL			
LEGEND	DIRECTION	BUSINESS	LOGO NO.
GAS	NB	EXXON (24 HRS)	5
		GULF (DIESEL)	9
FOOD	NB	ISCAAC'S GRILLED SANDWICHES	6
		MARZONI'S BRICKOVEN	11
LODGING	NB	HAMPTON INN	1
		HOMEWOOD SUITES – HILTON	2
		COURTYARD BY MARRIOTT	4

NB SIGNS

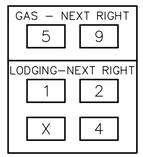

16'Hx13'W
W12x26 A572
3M TYPE III
B650 – #1, #4

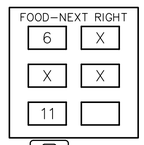

14'Hx13'W
W10x26 A572
3M TYPE III
B650 – #1, #1

15
SR 2021

ROSSMOYNE RD / WESLEY DR

O:\2015\08\3\215078-01\HW\PSE\AS-BUILT DRAWINGS\PENNDOT DISTRICT 08\CUMBERLAND - 21\10-XX_SHTXX US15_ROSSMOYNE EXT PLAN
September/12/2023 3:56 PM