| DISTRICT | COUNTY | ROUTE | PROJECT | SHEET |
|---|---|---|---|---|
| 6-0 | MONTGOMERY | US 422 | | |
| LIMERICK TOWNSHIP | | | | |
| REVISIONS | | | | |

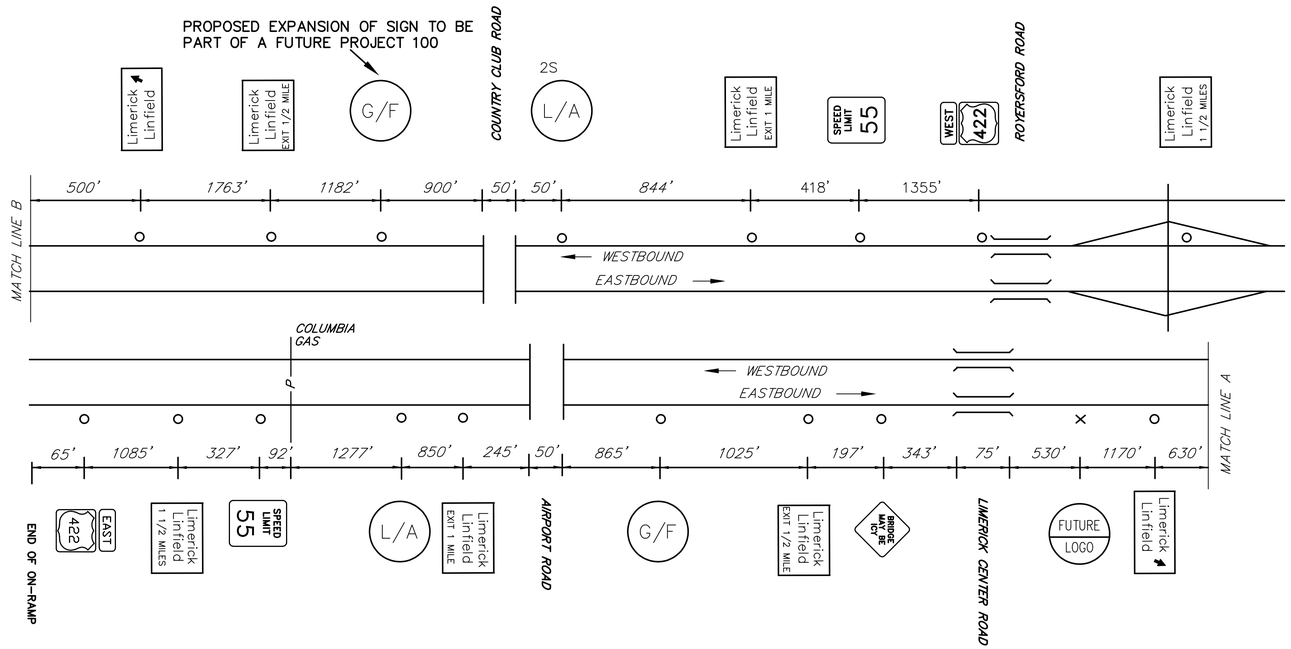


MAINLINE SCHEMATIC
NOT TO SCALE

| TABULATION OF QUANTITIES | | |
|---|---|---|
| ITEM | UNIT | QUANTITY |
| * STEEL S OR W BEAM POSTS | LBS. | – |
| BREAKAWAY SYSTEMS | EACH | – |
| POST MOUNTED SIGNS, TYPE A, LOGO | SQ.FT. | – |
| POST MOUNTED SIGNS, TYPE B, LOGO | SQ.FT. | – |
| POST MOUNTED SIGNS, TYPE C, LOGO | SQ.FT. | – |
| LOGO SIGN MOUNTING | EACH | – |

* APPROXIMATE QUANTITY FOR INFORMATION ONLY

SYMBOLS

- ○ *Existing Sign to Remain*
- △ *Existing Sign to be Removed*
- □ *Existing Sign Reset as Shown*
- ● NEW SIGN
- × FUTURE SIGN
- Ø *Existing Utility Pole*

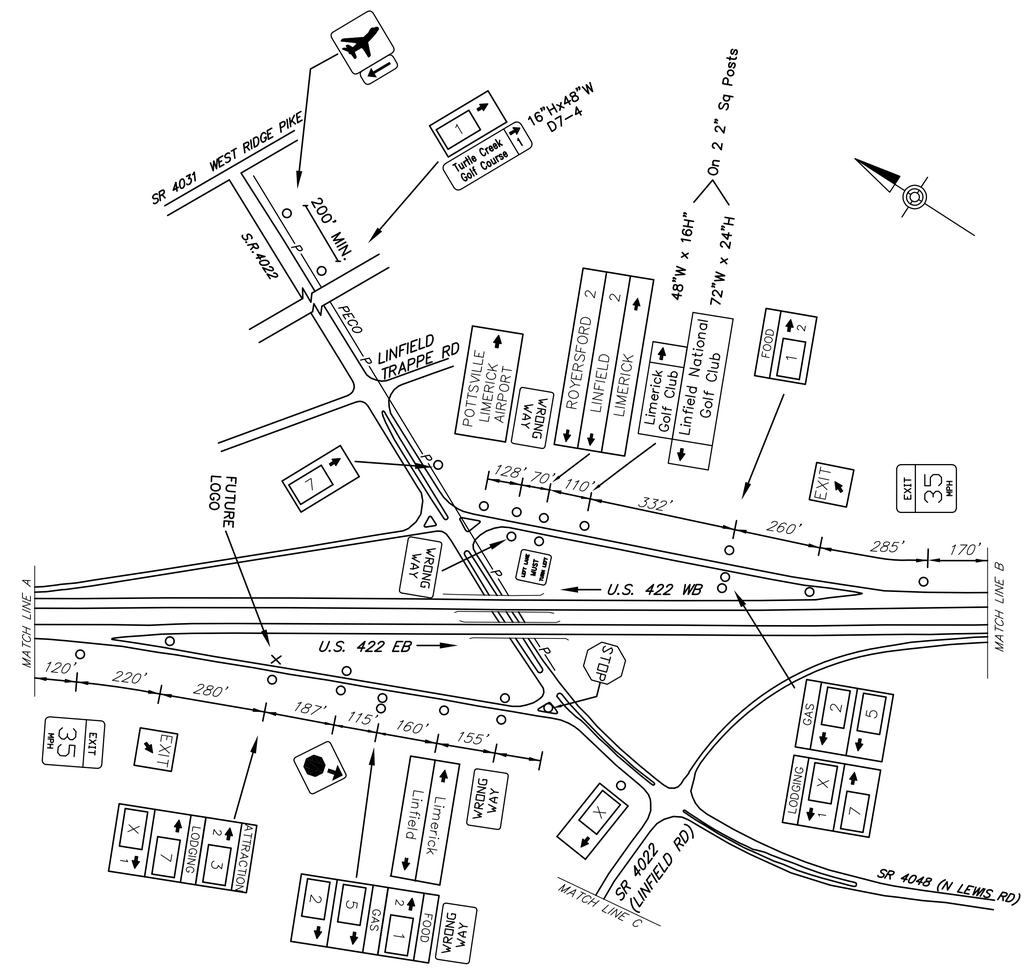


LANE RESTRICTIONS:

LANE MAY BE RESTRICTED WEEKDAYS
9:00 AM TO 3:00 PM.

## LEGEND

2S – GUIDE RAIL

| LIMERICK SPECIFIC INFORMATION PANEL | | | |
|---|---|---|---|
| LEGEND | DIRECTION | BUSINESS | LOGO NO. |
| GAS | EB/WB | SNK (DIESEL) | 2 |
| | | WAWA (24 HRS/DIESEL) | 5 |
| FOOD | EB/WB | LIMERICK DINER | 1 |
| | | | |
| LODGING | EB/WB | HAMPTON INN | 7 |
| | | | |
| | | | |
| ATTRACTION | EB | TURTLE CREEK GOLF COURSE | 3 |
| | | | |
| | | | |

EB SIGNS

12'Hx13'W
W14x30 A572
STIM. TYPE IV
B650 – #2, #2

| GAS – NEXT RIGHT | |
|---|---|
| 2 | 5 |
| FOOD – NEXT RIGHT | |
| 1 | X |

13.5'Hx13'W
FUTURE 12'H
W8x21 A572
B525 – #1, #1

| LODGING–NEXT RIGHT | |
|---|---|
| X | 7 |
| ATTRACTION NEXT RIGHT | |
| 3 | |

WB SIGNS

| GAS – NEXT RIGHT | |
|---|---|
| 2 | 5 |
| FOOD – NEXT RIGHT | |
| 1 | X |

12'Hx13'W
W8x21 A572
STIM. TYPE IV
B525 – #1, #1

| LODGING – NEXT RIGHT | | |
|---|---|---|
| X | 7 | |
| ATTRACTION – NEXT RIGHT | | |
| | | |

12'Hx19'W
W12x26 A572
3M TYPE III
B650 – #2, #2

SCHEMATIC PLAN
NOT TO SCALE

422
SR 4022

LIMERICK LINFIELD

D:\2015_GDB\121507A-01\WA\PSEL\AS-BUILT DRAWINGS\PENNDOT DISTRICT 06\MONTGOMERY - 46\10-XX_SHTXX US422_LIMERICK PLAN
September 13, 2023 9:57 AM