DISTRICT	COUNTY	ROUTE	PROJECT	SHEET
5-0	MONROE	I-380		
BORO OF MOUNT POCONO				
COOLBAUGH & TOBYHANNA TOWNSHIPS				
REVISIONS				

TABULATION OF QUANTITIES		
ITEM	UNIT	QUANTITY
POST MOUNTED SIGNS, TYPE A, LOGO	SQ.FT.	
POST MOUNTED SIGNS, TYPE B, LOGO	SQ.FT.	
POST MOUNTED SIGNS, TYPE C, LOGO	SQ.FT.	
BREAKAWAY SYSTEMS	EACH	
* STEEL S OR W BEAM POSTS	LBS.	
LOGO SIGN MOUNTING	EACH	
FLAT SHEET PANEL REPLACEMENT	SQ.FT.	
EXTRUDED PANEL REPLACEMENT	SQ.FT.	
REMOVAL OF POST MOUNTED MOTORIST SERVICE SIGNS, TYPES B, C & F	L.S.	

* APPROXIMATE QUANTITY FOR INFORMATION ONLY

SYMBOLS

- ○ *Existing Sign to Remain*
- △ *Existing Sign to be Removed*
- □ *Existing Sign Reset as Shown*
- ● NEW SIGN
- × FUTURE SIGN
- Ø *Existing Utility Pole*

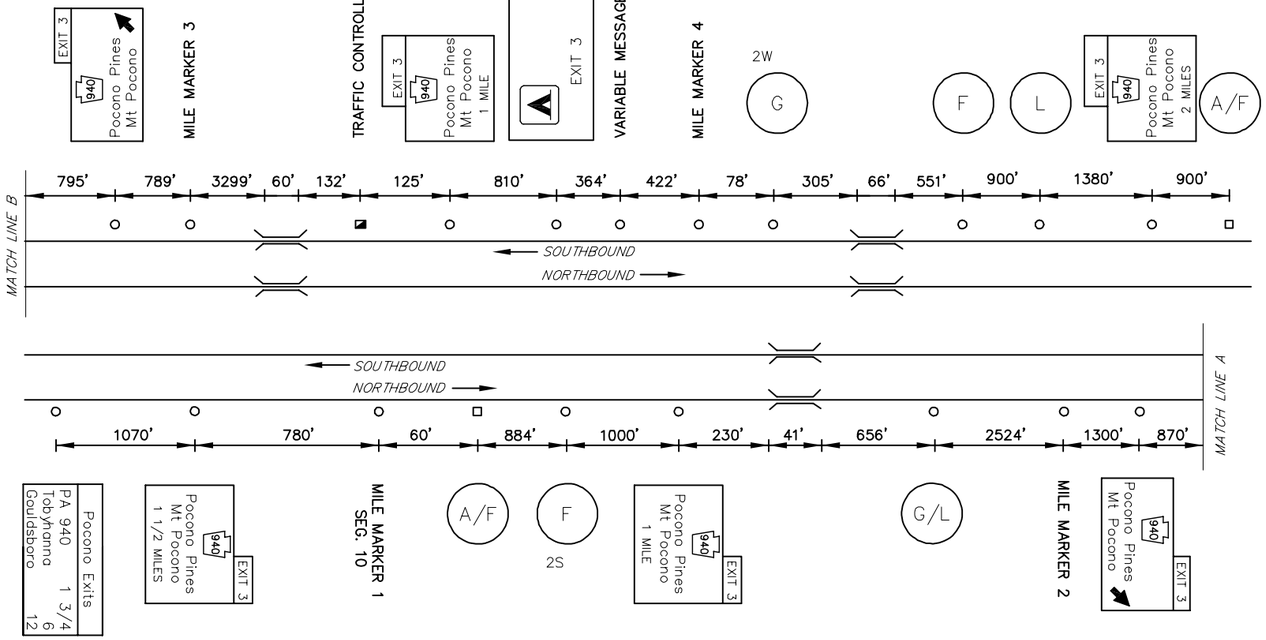

MAINLINE SCHEMATIC
NOT TO SCALE

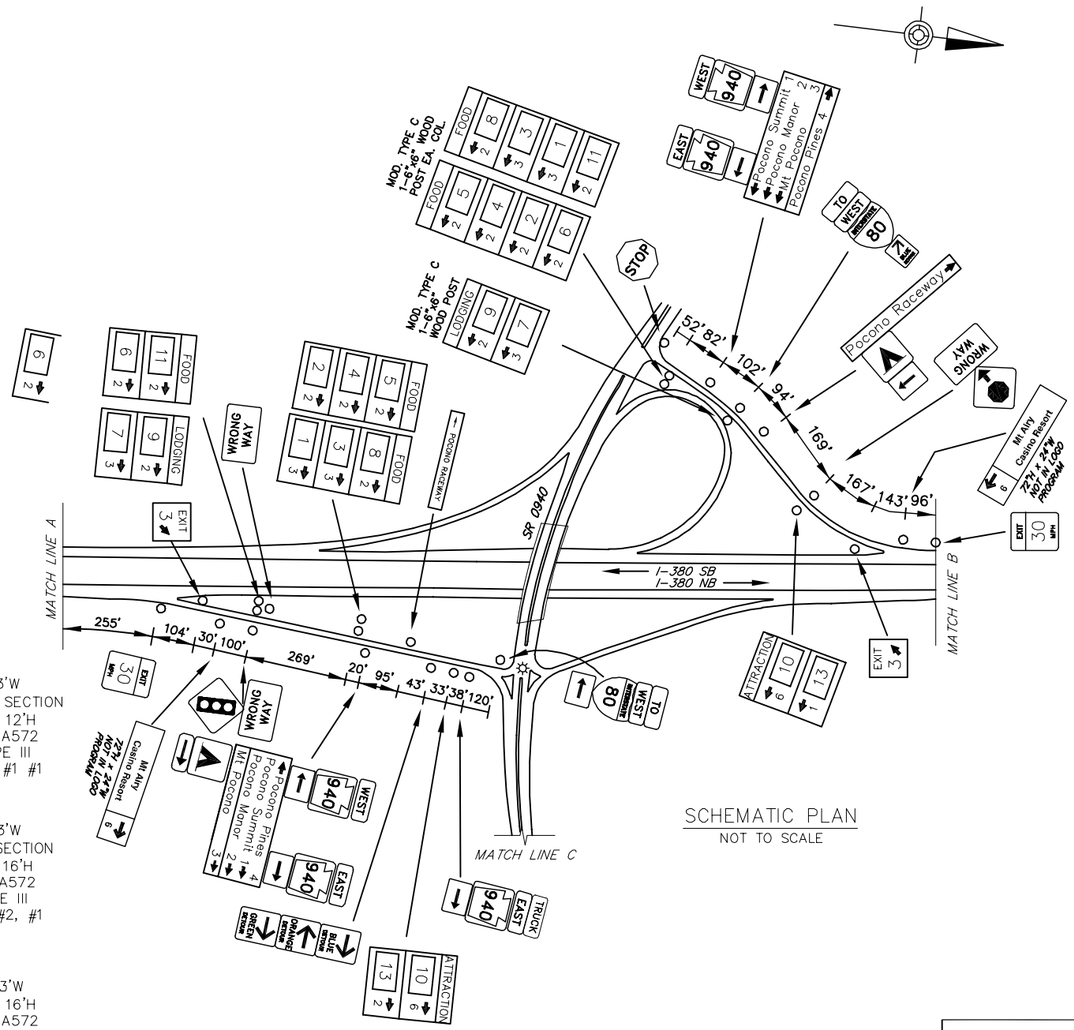

SCHEMATIC PLAN
NOT TO SCALE

LEGEND

2S/2W – GUIDE RAIL

DO NOT CLOSE OR RESTRICT TRAVEL LANES
BETWEEN 6:00 AM & 9:00 AM, AND
BETWEEN 3:00 PM & 6:00 PM MONDAY THRU FRIDAY.

NO WORK PERMITTED ON POCONO RACEWAY EVENT DATES.

DO NOT WORK DURING HOLIDAY PERIODS.

EXIT 3 SPECIFIC INFORMATION PANEL			
LEGEND	DIRECTION	BUSINESS	LOGO NO.
GAS	NB/SB		
FOOD	NB/SB	BURGER KING	3
		KFC	2
		McDONALD'S (24 HRS)	5
		WENDY'S	1
		PERKINS FAMILY RESTAURANT–BAKERY	8
		SUBWAY	4
		STARBUCKS	6
		TACO BELL	11
LODGING	NB/SB	HOTEL MOUNT POCONO	7
		COMFORT INN & SUITES	9
ATTRACTION	NB/SB	MOUNT AIRY CASINO – RESORT	10
		KALAHARI RESORTS	13

1–MILE EXTENSION OF DISTANCE CRITERIA APPLIES PER PUB. 46 SEC. 1.22.4.2(b)

NB SIGNS

12'Hx19'W
FUTURE 14'H
W12x26 A572
3M TYPE III
B650 – #2, #2

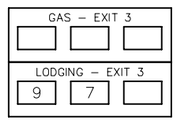

14'Hx13'W
W10x26 A572
3M TYPE III
B650 – #2, #1
08/8/2019 FIELD INSPECTION NOTED EXPOSED REBAR ON BOTH FOUNDATIONS

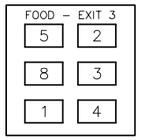

12'Hx13'W
FUTURE 16'H
W10x26 A572
TYPE IX LEGEND
TYPE III BACKGROUND
B650 – #1, #2

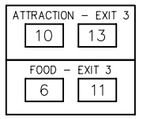

SB SIGNS

6'Hx13'W
13.5'H TOP SECTION
FUTURE 12'H
W12x26 A572
3M TYPE III
B650 – #1 #1

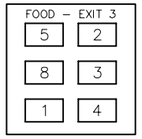

14'Hx13'W
16'H TOP SECTION
FUTURE 16'H
W14x30 A572
3M TYPE III
B650 – #2, #1

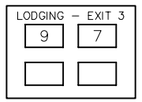

10'Hx13'W
FUTURE 16'H
W18x40 A572
3M TYPE III
B650 – #2, #2

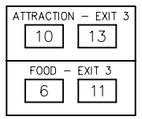

12'H x 13'W
FUTURE 16'H
W14x30 A572
TYPE IX LEGEND
TYPE III BACKGROUND
B650 – #1 #1

INTERSTATE 380

SR 0940 (MT POCONO)
EXIT 3
SHEET 1 OF 2 THIS EXIT

D:\2015_JOBS\121976-01\PW\PSE\AS-BUILT DRAWINGS\PENNDOT DISTRICT 05\MONROE - 45\10-XX SHTXX-I380_EXIT 3 PLAN
September/12/2023 1:39 PM

DISTRICT	COUNTY	ROUTE	PROJECT	SHEET
5-0	MONROE	I-380		
BORO OF MOUNT POCONO				
COOLBAUGH & TOBYHANNA TOWNSHIPS				
REVISIONS				

SYMBOLS

- ○ *Existing Sign to Remain*
- △ *Existing Sign to be Removed*
- □ *Existing Sign Reset as Shown*
- ● NEW SIGN
- × FUTURE SIGN
- Ø *Existing Utility Pole*

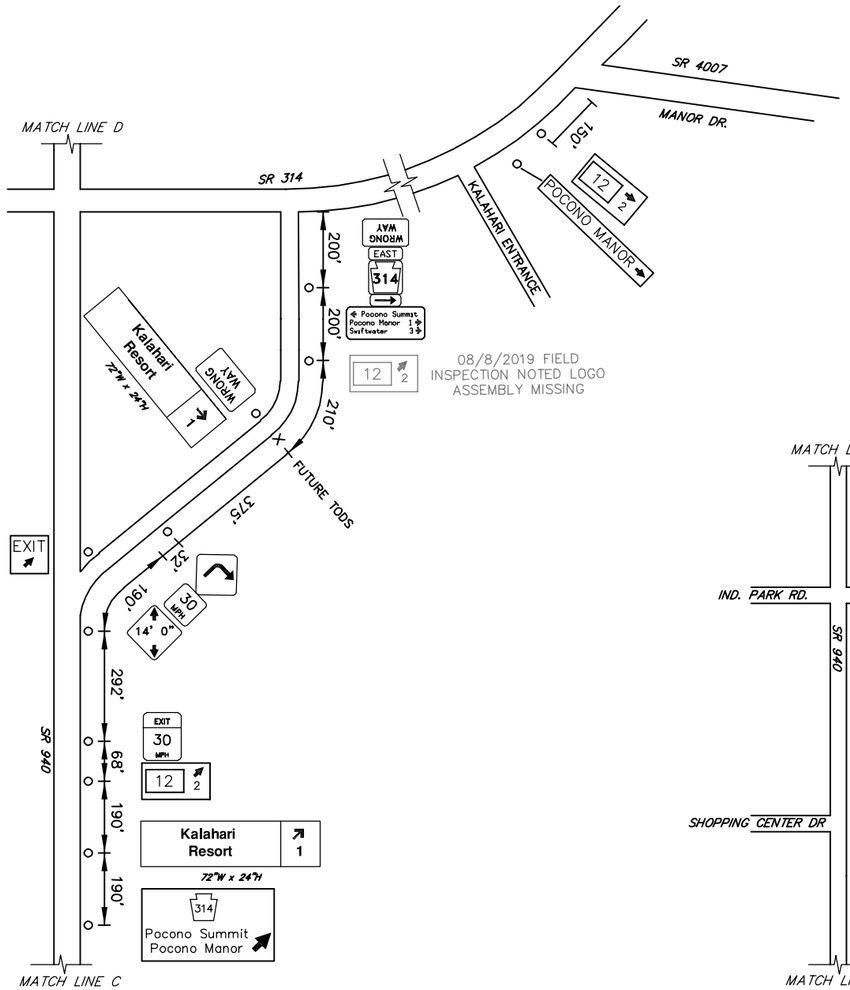

TOBYHANNA TOWNSHIP

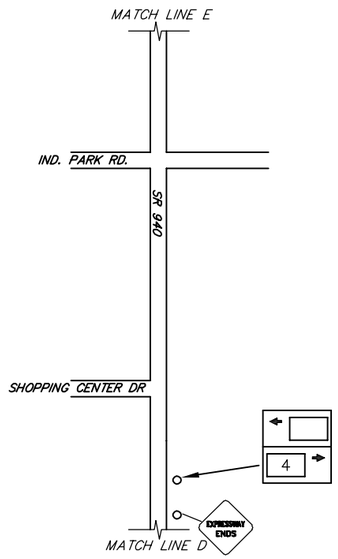

BOROUGH OF MOUNT POCONO

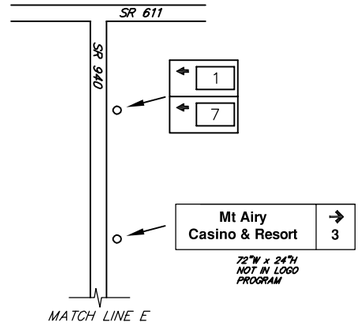

BOROUGH OF MOUNT POCONO

FOOD	BURGER KING	3
	KFC	2
	McDONALD'S (24 Hours)	5
	WENDY'S	1
	PERKINS FAMILY RESTAURANT-BAKERY	8
	SUBWAY	4
	STARBUCKS	6
LODGING	HOTEL MOUNT POCONO	7
	COMFORT INN & SUITES	9
	THE INN AT POCONO MANOR	12
ATTRACTION	MOUNT AIRY CASINO - RESORT	10
	KALAHARI RESORTS	13

SCHEMATIC PLAN
NOT TO SCALE

INTERSTATE 380

MT POCONO
EXIT 3

SHEET 2 OF 2 THIS EXIT

D:\2015\08515\215076-01\MVP\SE\AS-BUILT DRAWINGS\PENNDOT DISTRICT ESIGN\MGE - 45\10-XX SHTXX-I380_EXIT 3 PLAN
November/13/2023 1:49 PM