| DISTRICT | COUNTY | ROUTE | PROJECT | SHEET |
|---|---|---|---|---|
| 3-0 | LYCOMING | I-180 | | |

LOYALSOCK TOWNSHIP & MOUNTORSVILLE BOROUGH

REVISIONS

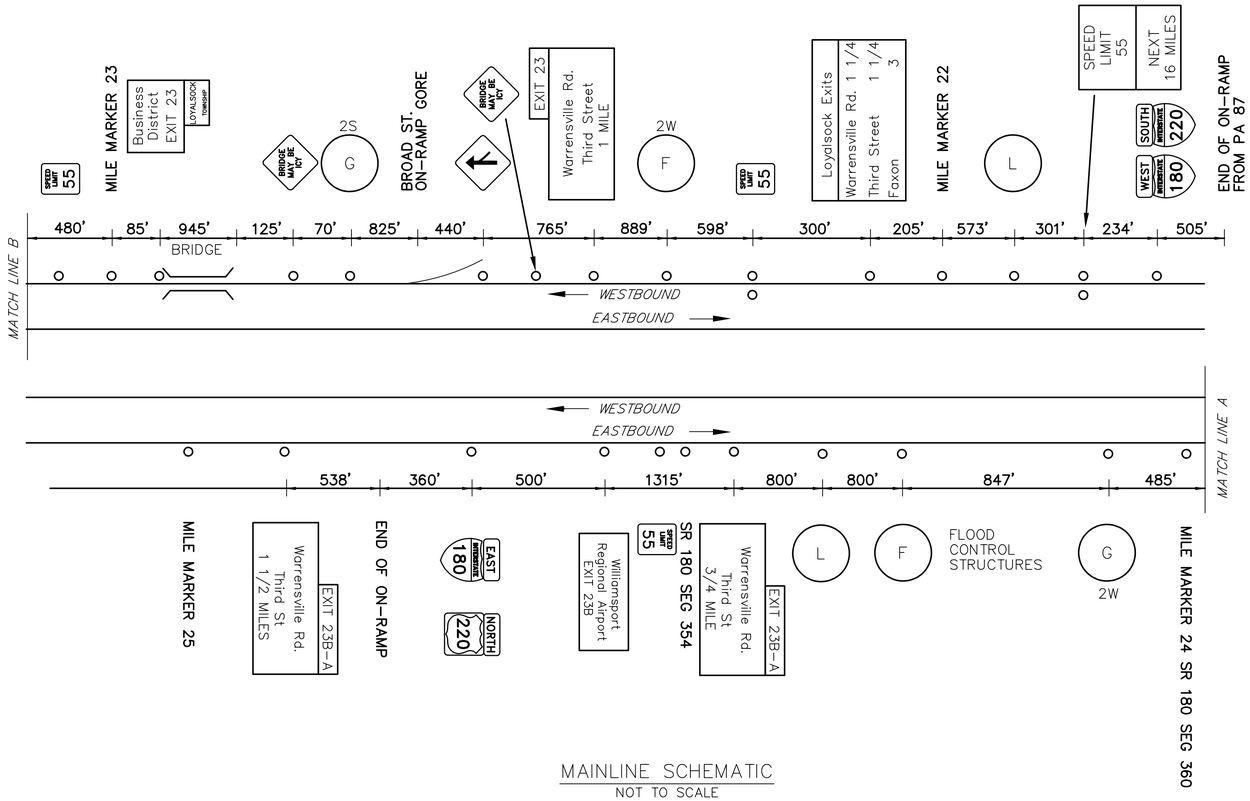


MAINLINE SCHEMATIC
NOT TO SCALE

| TABULATION OF QUANTITIES | | |
|---|---|---|
| ITEM | UNIT | QUANTITY |
| POST MOUNTED SIGNS, TYPE A, LOGO | SQ.FT. | – |
| POST MOUNTED SIGNS, TYPE B, LOGO | SQ.FT. | – |
| POST MOUNTED SIGNS, TYPE C, LOGO | SQ.FT. | – |
| BREAKAWAY SYSTEMS | EACH | – |
| * STEEL S OR W BEAM POSTS | LBS. | – |
| LOGO SIGN MOUNTING | EACH | – |
| EXTRUDED PANEL REPLACEMENT | SQ.FT. | |
| REMOVAL OF POST MOUNTED MOTORIST SERVICE SIGNS, TYPES B, C & F | L.S. | |

* APPROXIMATE QUANTITY FOR INFORMATION ONLY

SYMBOLS

- ○ *Existing Sign to Remain*
- △ *Existing Sign to be Removed*
- □ *Existing Sign Reset as Shown*
- ● NEW SIGN
- × FUTURE SIGN
- Ø *Existing Utility Pole*

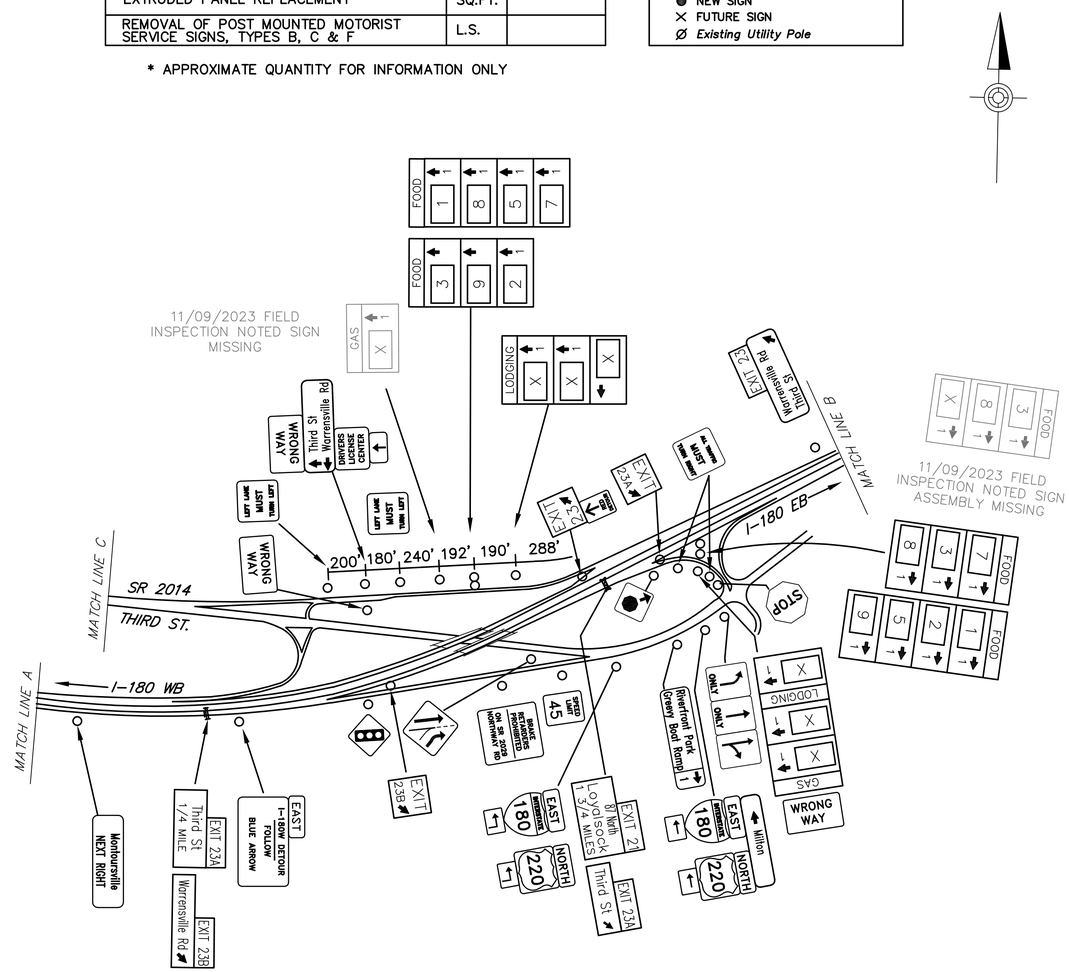


LEGEND

2S/2W – GUIDE RAIL

| EXIT 23 SPECIFIC INFORMATION PANEL | | | |
|---|---|---|---|
| LEGEND | DIRECTION | BUSINESS | LOGO NO. |
| GAS | 23A EB/WB | SHEETZ | 4 |
| | 23A EB | TURKEY HILL | 6 |
| FOOD | 23A EB/WB | KFC | 1 |
| | | DUNKIN' DONUTS (24 HRS) | 2 |
| | | HOSS'S FAMILY STEAK & SEA | 3 |
| | | RED LOBSTER | 5 |
| | | TGI FRIDAY'S | 8 |
| | | SHEETZ | 9 |
| | | QDOBA | 7 |
| LODGING | 23A EB/WB | | |
| | WB | | |

EB SIGNS

12'Hx13'W FUTURE 14'H W14x30 3M TYPE III B650 – #1, #1

| GAS – EXIT 23B | |
|---|---|
| 6 | X |
| GAS – EXIT 23A | |
| 4 | X |

14'Hx13'W W12x26 3M TYPE III B650 – #1, #1

| FOOD – EXIT 23A | |
|---|---|
| 2 | 1 |
| 3 | 5 |
| 9 | 8 |

12'Hx13'W FUTURE 14'H W12x26 A572 3M TYPE III B650 – #1, #1

| FOOD – EXIT 23A | |
|---|---|
| 7 | |
| LODGING – EXIT 23A | |
| X | |

WB SIGNS

12'Hx13'W FUTURE 14'H W12x26 A36 3M TYPE III B650 – #1, #1

| GAS – EXIT 23 | |
|---|---|
| 4 | X |
| FOOD – EXIT 23 | |
| 7 | |

14'Hx13'W W12x26 A572 3M TYPE III B650 – #1, #1

| FOOD – EXIT 23 | |
|---|---|
| 2 | 1 |
| 3 | 5 |
| 9 | 8 |

10'Hx13'W W8x21 3M TYPE III B525 – #1, #1

| LODGING – EXIT 23 | |
|---|---|
| X | X |
| X | |

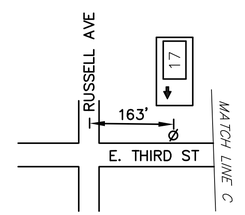


SCHEMATIC PLAN
NOT TO SCALE

INTERSTATE 180

SR 2014 / THIRD ST

EXIT 23

D:\2015_ADBS\215076-01\HW\PSE\AS-BUILT DRAWINGS\PENNDOT DISTRICT 03\LYCOMING - 41\10-XX SHTXX-I180_EXIT 23 PLAN
November/15/2023 12:26 PM