DISTRICT	COUNTY	ROUTE	PROJECT	SHEET
5-0	BERKS	US-222		
BRECKNOCK & SPRING TWPS.				
8-0	LANCASTER			
BORO OF ADAMSTOWN & BRECKNOCK TWP.				
REVISIONS				

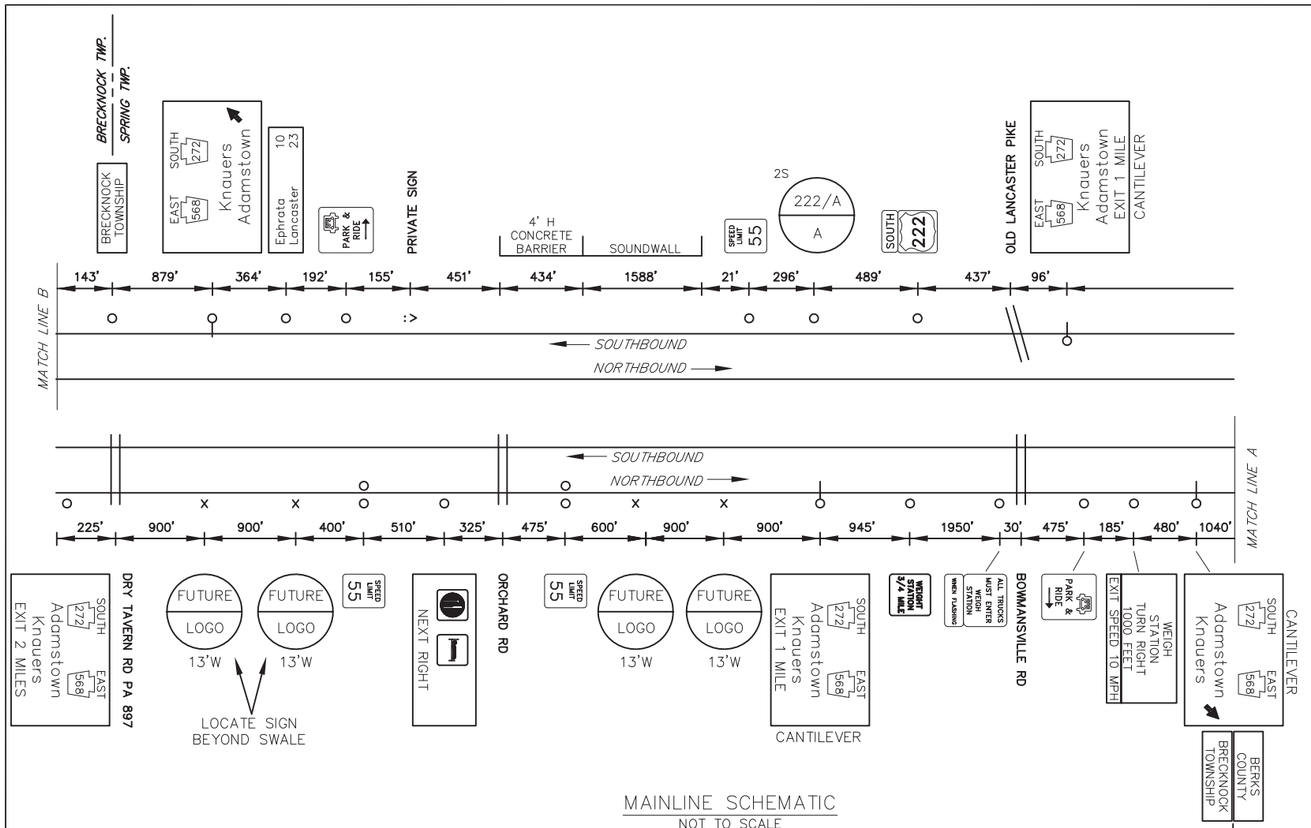

MAINLINE SCHEMATIC
NOT TO SCALE

DO NOT CLOSE OR RESTRICT TRAVEL LANES BETWEEN 6:00 AM AND 9:00 AM, AND BETWEEN 3:00 PM AND 6:00 PM, MONDAY THRU FRIDAY. DO NOT WORK DURING HOLIDAY PERIODS.

TABULATION OF QUANTITIES		
ITEM	UNIT	QUANTITY
POST MOUNTED SIGNS, TYPE A, LOGO	SQ.FT.	
POST MOUNTED SIGNS, TYPE B, LOGO	SQ.FT.	
POST MOUNTED SIGNS, TYPE C, LOGO	SQ.FT.	–
BREAKAWAY SYSTEMS	EACH	
* STEEL S OR W BEAM POSTS	LBS.	
LOGO SIGN MOUNTING	EACH	
TYPE B SIGNS SUPPLIED BY TRUST	SQ.FT.	

* APPROXIMATE QUANTITY FOR INFORMATION ONLY

SYMBOLS

- ○ *Existing Sign to Remain*
- △ *Existing Sign to be Removed*
- □ *Existing Sign Reset as Shown*
- ● NEW SIGN
- × FUTURE SIGN
- Ø *Existing Utility Pole*

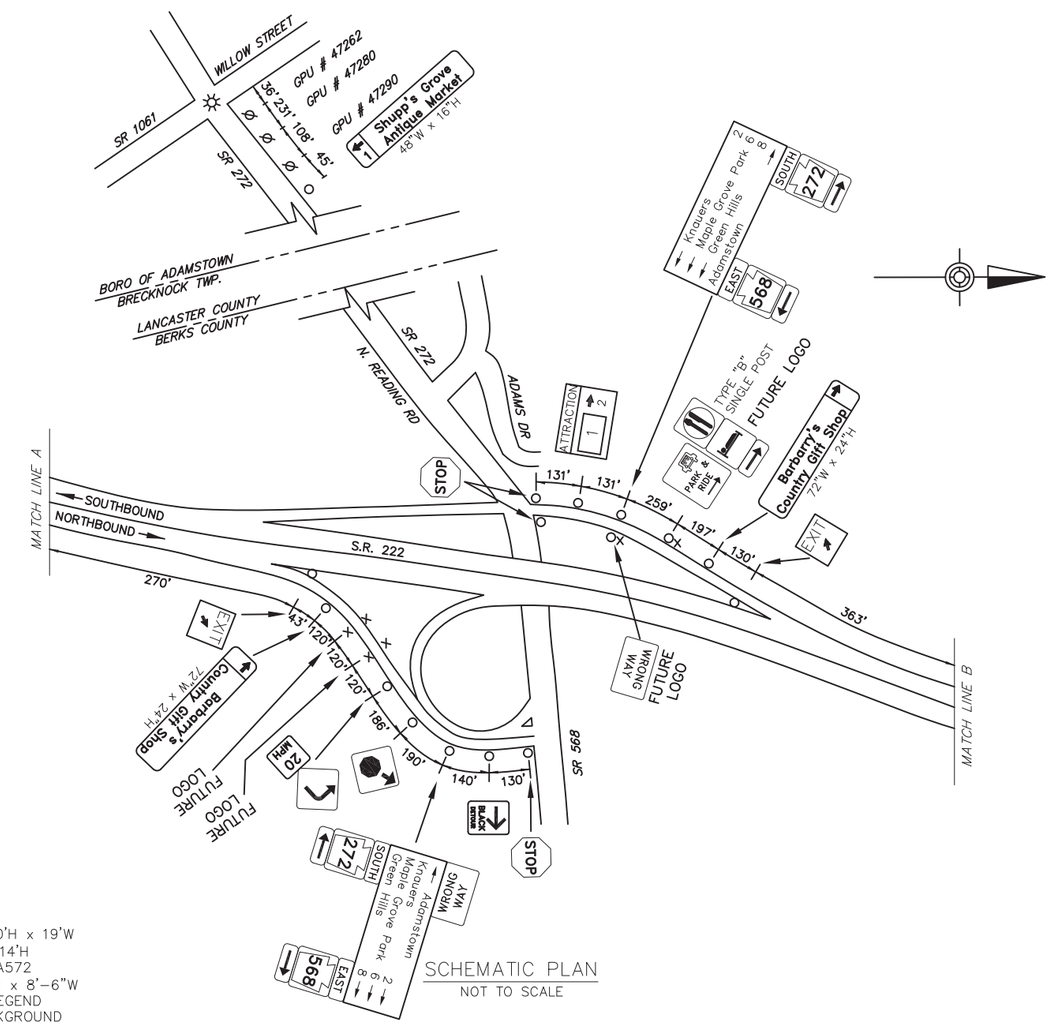

SCHEMATIC PLAN
NOT TO SCALE

NB SIGNS

SB SIGNS

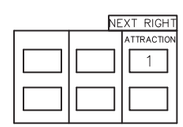

MAIN PANEL 10'H x 19'W
FUTURE 14'H
W18x40 A572
EXIT PANEL 2'H x 8'-6"W
TYPE IX LEGEND
TYPE III BACKGROUND
B650 – #2, #2

ADAMSTOWN SPECIFIC INFORMATION PANEL			
SIGN NUMBER	LEGEND	BUSINESS	LOGO. NO.
222/A A SB	ATTRACTION	SHUPP'S GROVE ANTIQUE MARKET	1

222

PA 272

ADAMSTOWN

D:\2015_JOBS\215076-01\WV\PSE\AS-BUILT DRAWINGS\PENNDOT DISTRICT 05\BERKS - 06\10-XX SHTXX-222_ EXIT ADAMSTOWN PLAN
July/23/2018 9:32 AM