DISTRICT	COUNTY	ROUTE	PROJECT	SHEET
5-0	BERKS	I-176		
CAERNARVON TOWNSHIP				
REVISIONS				

TABULATION OF QUANTITIES		
ITEM	UNIT	QUANTITY
POST MOUNTED SIGNS, TYPE A, LOGO	SQ.FT.	
POST MOUNTED SIGNS, TYPE B, LOGO	SQ.FT.	
POST MOUNTED SIGNS, TYPE C, LOGO	SQ.FT.	
BREAKAWAY SYSTEMS	EACH	
* STEEL S OR W BEAM POSTS	LBS.	
LOGO SIGN MOUNTING	EACH	
REMOVAL OF POST MOUNTED MOTORIST SERVICE SIGNS, TYPES A & E	EACH	–
REMOVAL OF POST MOUNTED MOTORIST SERVICE SIGNS, TYPES B, C & F	L.S.	

* APPROXIMATE QUANTITY FOR INFORMATION ONLY

SYMBOLS

- ○ *Existing Sign to Remain*
- △ *Existing Sign to be Removed*
- □ *Existing Sign Reset as Shown*
- ● NEW SIGN
- × FUTURE SIGN
- Ø *Existing Utility Pole*

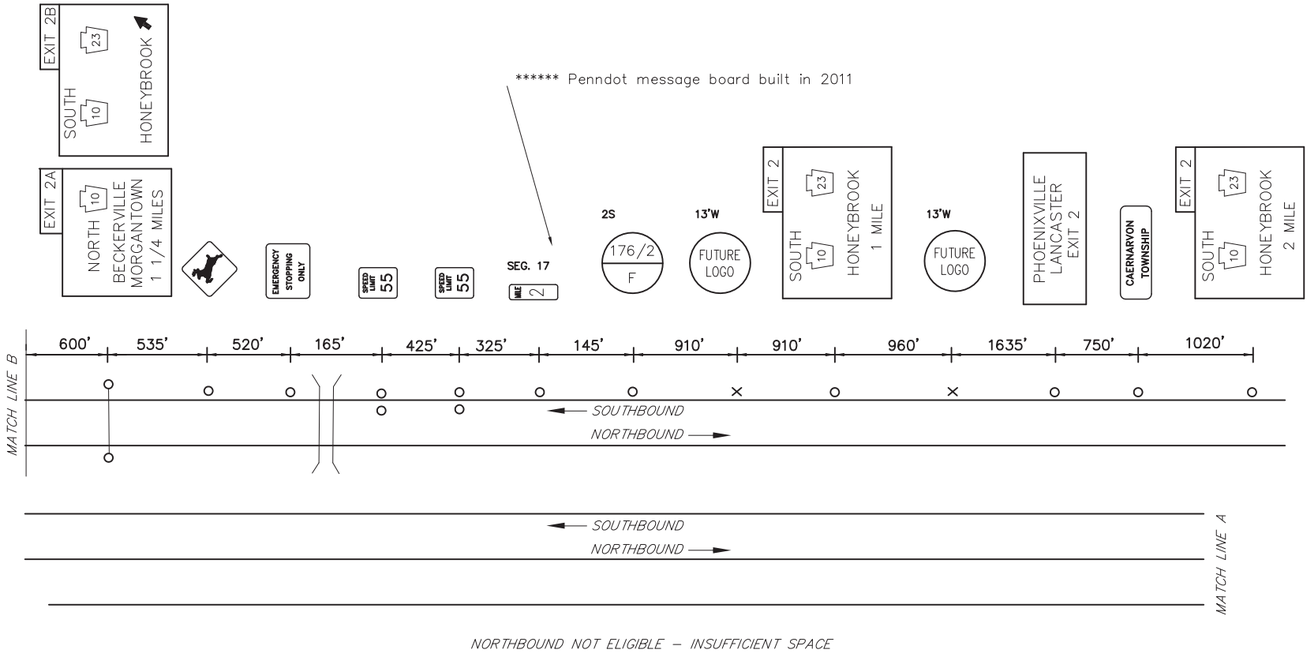

MAINLINE SCHEMATIC
NOT TO SCALE

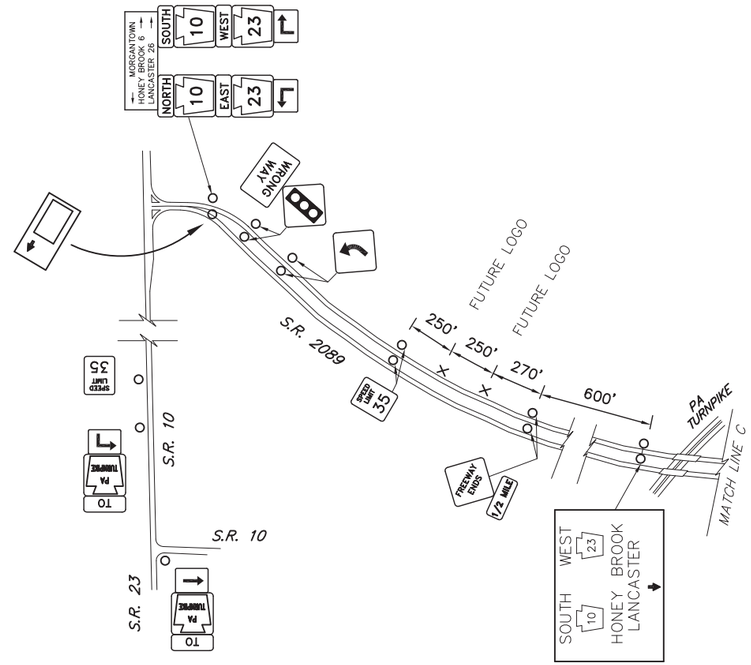

SCHEMATIC PLAN
NOT TO SCALE

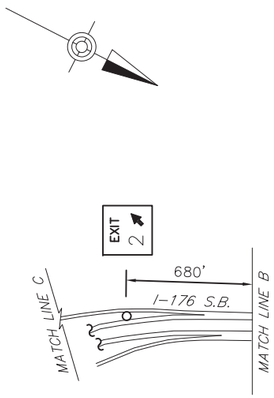

EXIT 2 SPECIFIC INFORMATION PANEL			
SIGN NUMBER	LEGEND	BUSINESS	LOGO. NO.
176/2 F SB	FOOD		

SB SIGNS

6'Hx13'W
FUTURE 14'H
W12x26 A572
STIM. III
B650 – #1, #1

INTERSTATE 176
HONEYBROOK
EXIT 2

D:\2015_JOBS\215076-01\WW\PSE\AS-BUILT DRAWINGS\PENNDOT DISTRICT 05\BERKS - 0A10-XX SHTXX-176_EXIT 2 PLAN
July/27/2018 11:29 AM