DISTRICT	COUNTY	ROUTE	PROJECT	SHEET
5-0	BERKS	I-78		

TULPEHOCHEN TOWNSHIP

REVISIONS

TABULATION OF QUANTITIES		
ITEM	UNIT	QUANTITY
POST MOUNTED SIGNS, TYPE A, LOGO	SQ. FT.	
POST MOUNTED SIGNS, TYPE B, LOGO	SQ.FT.	
POST MOUNTED SIGNS, TYPE C, LOGO	SQ.FT.	
BREAKAWAY SYSTEMS	EACH	
STEEL S OR W BEAM POSTS	LBS.	
LOGO SIGN MOUNTING	EACH	
REMOVAL OF POST MOUNTED MOTORIST SERVICE SIGNS, TYPES A & F	EACH	
REMOVAL OF POST MOUNTED MOTORIST SERVICE SIGNS, TYPES B, C & F	L.S.	

* APPROXIMATE QUANTITY FOR INFORMATION ONLY

SYMBOLS

- ○ *Existing Sign to Remain*
- △ *Existing Sign to be Removed*
- □ *Existing Sign Reset as Shown*
- ● NEW SIGN
- × FUTURE SIGN
- Ø *Existing Utility Pole*

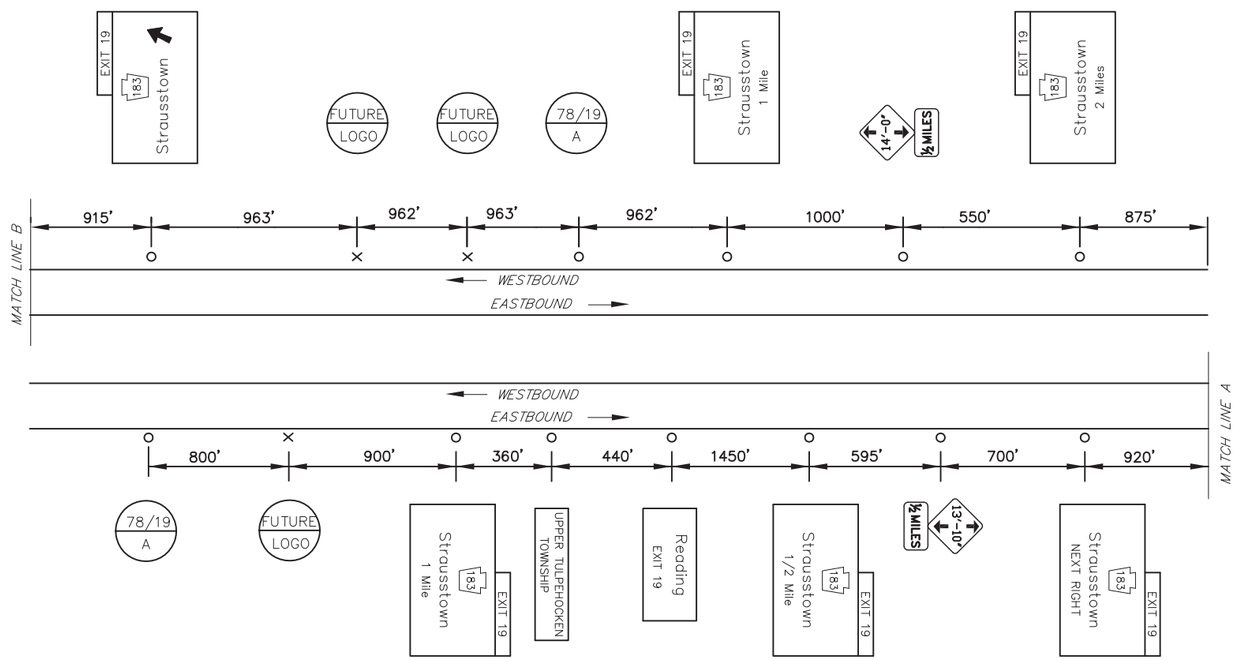

MAINLINE SCHEMATIC

NOT TO SCALE

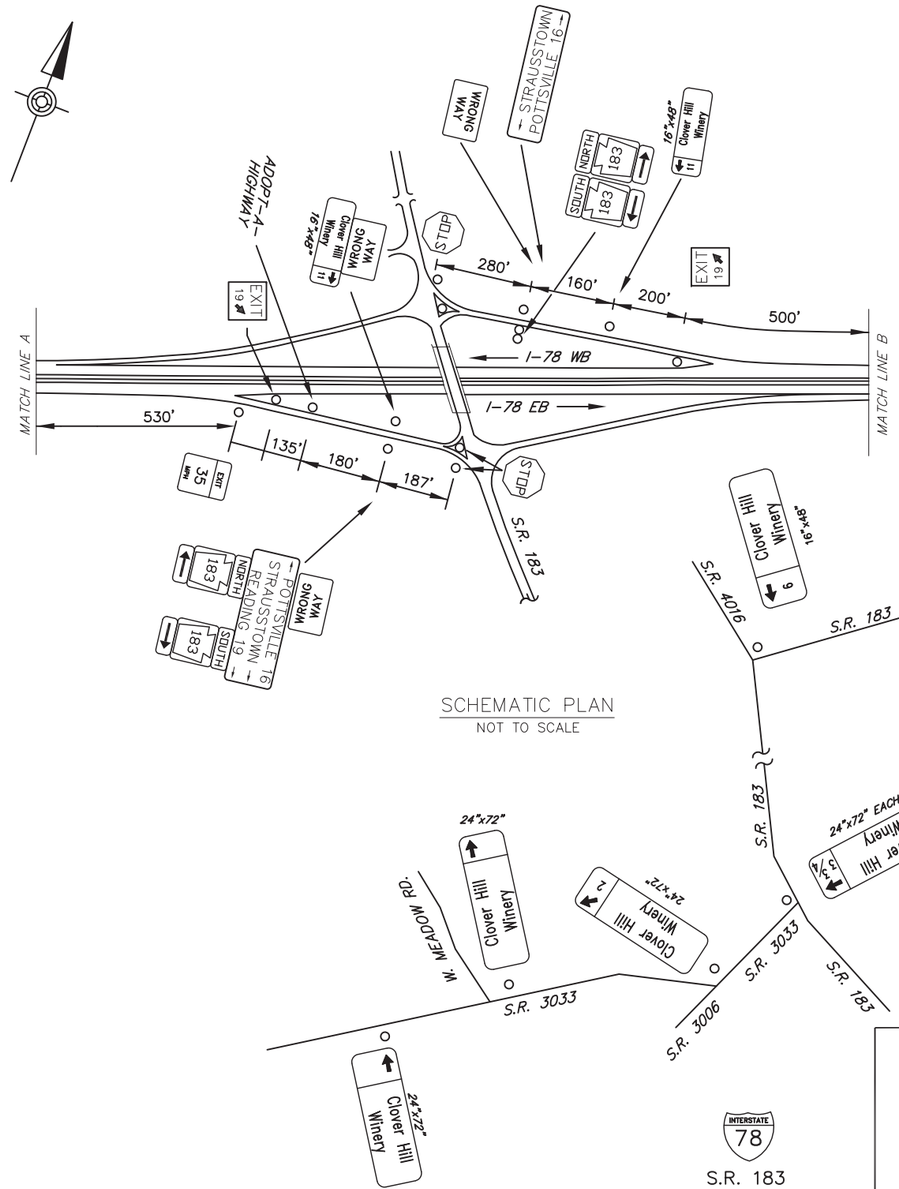

SCHEMATIC PLAN

NOT TO SCALE

EXIT 19 SPECIFIC INFORMATION PANEL			
SIGN NUMBER	LEGEND	BUSINESS	LOGO. NO.
78/19 A EB	ATTRACTION	CLOVER HILL WINERY	1
78/19 A WB			

EB SIGNS

6'Hx13'W
FUTURE 16'H
W14x30 A572
3M TYPE III
B650 – #2, #2

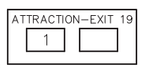

WB SIGNS

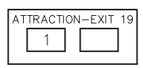

6'Hx13'W
FUTURE 16'H
W12x26 A572
3M TYPE III
B650 – #1, #1

D:\2015_JOBS\2015076-01\WW\PSE\AS-BUILT DRAWINGS\PENNDOT DISTRICT 05\BERKS - 0A10-XX SHTXX-178_EXIT 19 PLAN
July/23/2018 2:14 PM