DISTRICT	COUNTY	ROUTE	PROJECT	SHEET
12-0	GREENE	I-79		
PERRY TOWNSHIP				
REVISIONS				

TABULATION OF QUANTITIES		
ITEM	UNIT	QUANTITY
POST MOUNTED SIGNS, TYPE A, LOGO	SQ.FT.	–
POST MOUNTED SIGNS, TYPE B, LOGO	SQ.FT.	–
POST MOUNTED SIGNS, TYPE C, LOGO	SQ.FT.	–
BREAKAWAY SYSTEMS	EACH	–
* STEEL S OR W BEAM POSTS	LBS.	–
LOGO SIGN MOUNTING	EACH	–
FLAT SHEET PANEL REPLACEMENT	SQ. FT.	
EXTRUDED PANEL REPLACEMENT	SQ. FT.	
REMOVAL OF POST MOUNTED MOTORIST SERVICE SIGNS, TYPES B, C & F	L.S.	–

* APPROXIMATE QUANTITY FOR INFORMATION ONLY

SYMBOLS

- ○ *Existing Sign to Remain*
- △ *Existing Sign to be Removed*
- □ *Existing Sign Reset as Shown*
- ● NEW SIGN
- × FUTURE SIGN
- Ø *Existing Utility Pole*

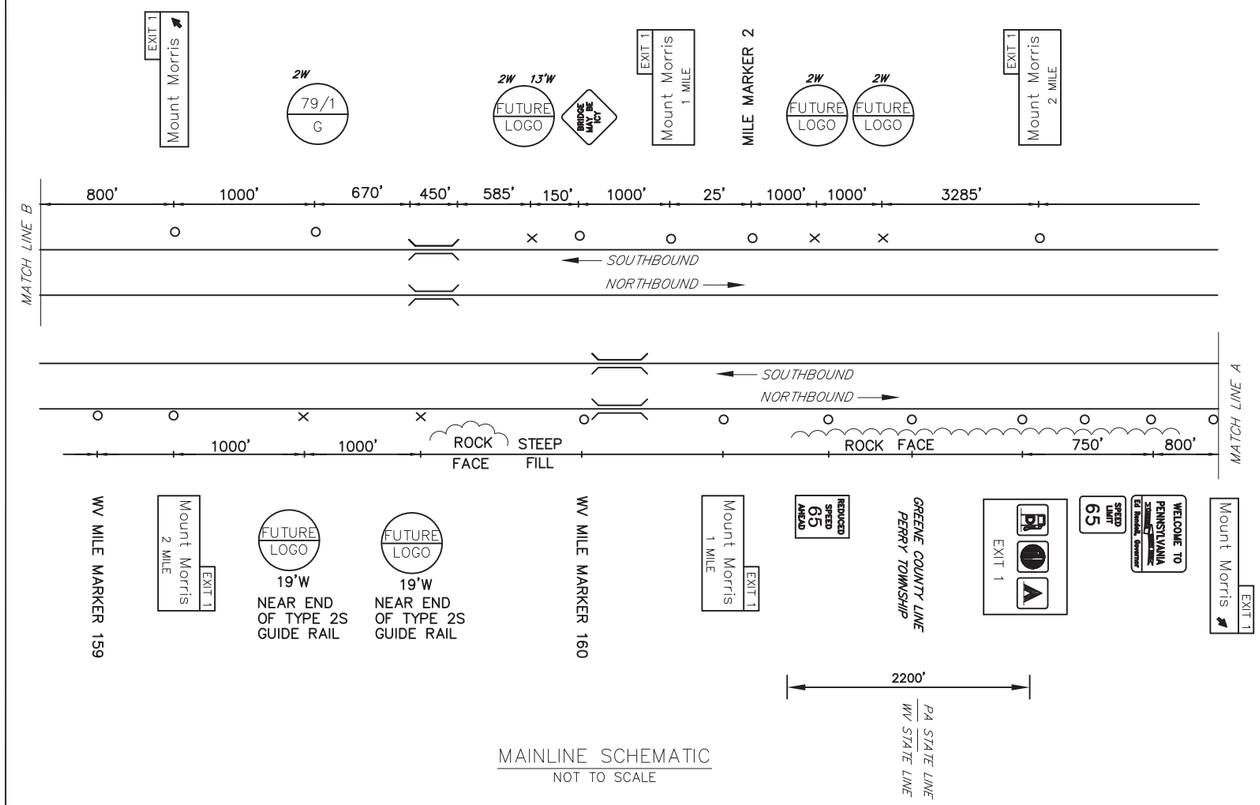

MAINLINE SCHEMATIC
NOT TO SCALE

EXIT 1 SPECIFIC INFORMATION PANEL			
SIGN NUMBER	LEGEND	BUSINESS	LOGO. NO.
79/1 G SB	GAS	MARATHON (Diesel)	1
		SUNOCO (DIESEL)	2

SB SIGNS

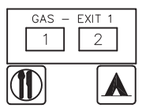

6'Hx13'W
FUTURE 12'H
W8x21
3M TYPE III
B525 – #2, #2

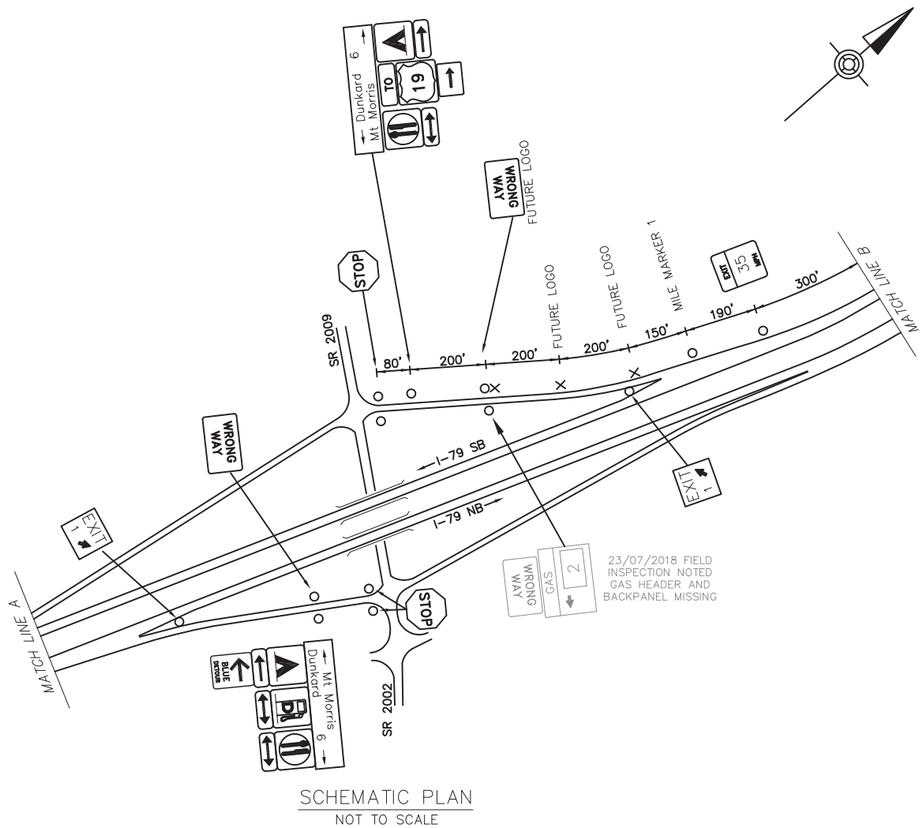

SCHEMATIC PLAN
NOT TO SCALE

INTERSTATE 79

MOUNT MORRIS

EXIT 1

D:\2015.JOBS\2125076-01\VA\PSE\AS-BUILT DRAWINGS\PENNDOT DISTRICT 12\GREENE - 30\10-XX SHTXX-179_ EXIT 1 PLAN
July/31/2018 11:01 AM