DISTRICT	COUNTY	ROUTE	PROJECT	SHEET
11-0	ALLEGHENY	PA 28		
EAST DEER & FRAZER TOWNSHIPS				
REVISIONS				

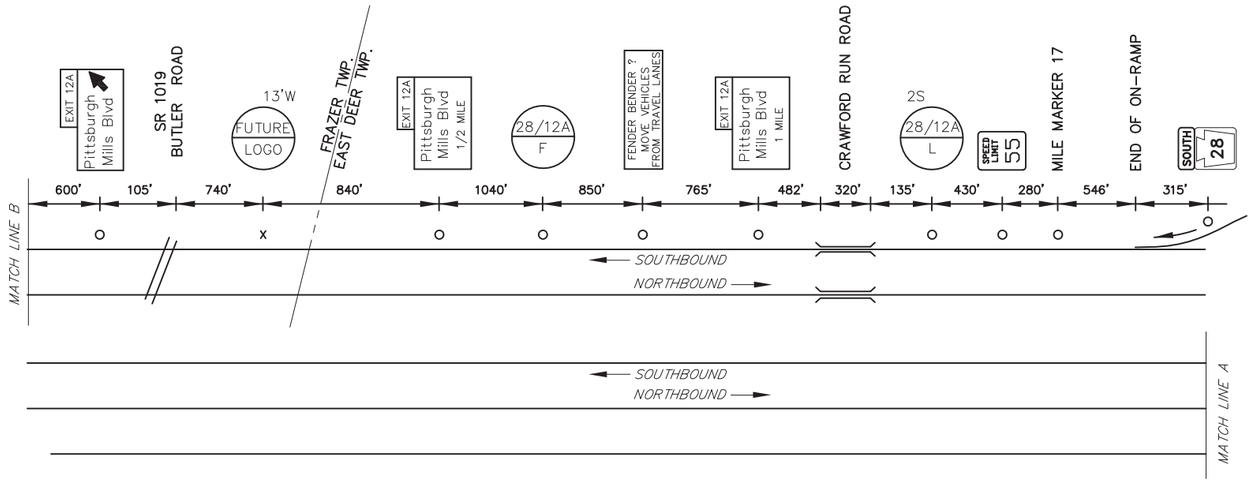

NORTHBOUND NOT ELIGIBLE – INSUFFICIENT SPACE

MAINLINE SCHEMATIC
NOT TO SCALE

TABULATION OF QUANTITIES		
ITEM	UNIT	QUANTITY
POST MOUNTED SIGNS, TYPE A, LOGO	SQ.FT.	
POST MOUNTED SIGNS, TYPE B, LOGO	SQ.FT.	
POST MOUNTED SIGNS, TYPE C, LOGO	SQ.FT.	
BREAKAWAY SYSTEMS	EACH	
* STEEL S OR W BEAM POSTS	LBS.	
LOGO SIGN MOUNTING	EACH	
REMOVAL OF POST MOUNTED MOTORIST SERVICE SIGNS, TYPES B, C & F	L.S.	

* APPROXIMATE QUANTITY FOR INFORMATION ONLY

SYMBOLS

- ○ *Existing Sign to Remain*
- △ *Existing Sign to be Removed*
- □ *Existing Sign Reset as Shown*
- ● NEW SIGN
- × FUTURE SIGN
- Ø *Existing Utility Pole*

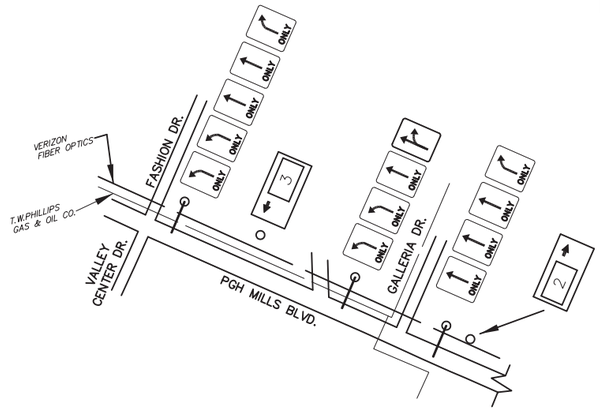

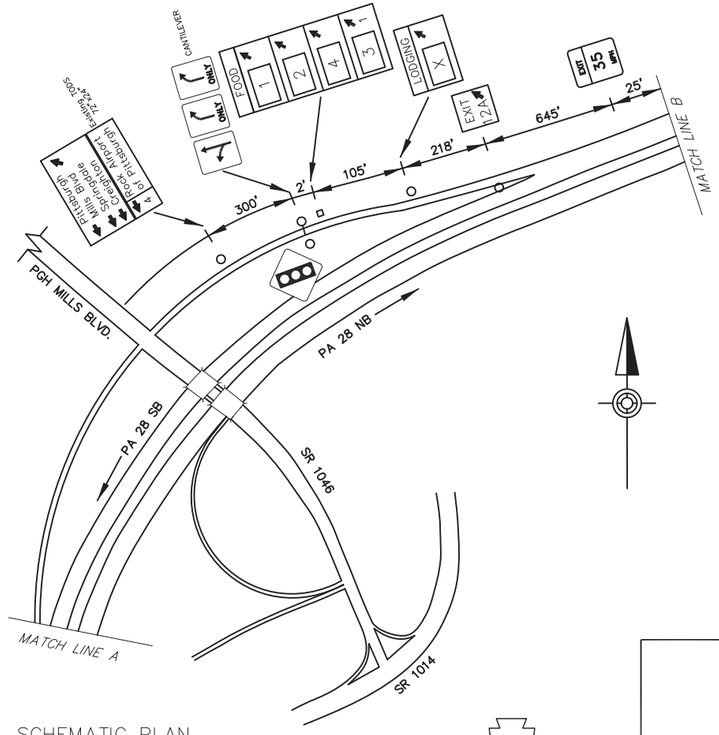

SCHEMATIC PLAN
NOT TO SCALE

WORK ONLY BETWEEN 9:00 AM AND 3:00 PM.
CONTACT DISTRICT 11-0
FOR ADDITIONAL TRAFFIC CONTROL REQUIREMENTS.

EXIT 12A SPECIFIC INFORMATION PANEL			
SIGN NUMBER	LEGEND	BUSINESS	LOGO. NO.
28/12A F SB	FOOD	EAT'N PARK	1
		OLIVE GARDEN FAMILY RESTAURANT	2
		APPLEBEE'S	3
		STARBUCKS	4
28/12A L SB	LODGING		

SB SIGNS

14'Hx13'W
FUTURE 16'H
W14x30
3M TYPE IX LEGEND
TYPE III BACKGROUND
B650 – #2, #2

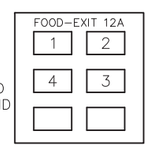

6'Hx13'W
FUTURE 16'H
W14x30
3M TYPE IX LEGEND
TYPE III BACKGROUND
B650 – #2, #2

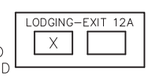

28

PGH MILLS BLVD

EXIT 12A

D:\2015_EBS\215276-01\PW\PSE\AS-BUILT DRAWINGS\PENNDOT DISTRICT 11\ALLEGHENY - 28\10-XX SHTXX-28_EXIT 12A PLAN
September/6/2018 10:41 AM