DISTRICT	COUNTY	ROUTE	PROJECT	SHEET
11-0	ALLEGHENY	PA-28		
FAWN, HARRISON, EAST DEER TWPS, TARENTUM BOROUGH				
REVISIONS				

TABULATION OF QUANTITIES		
ITEM	UNIT	QUANTITY
POST MOUNTED SIGNS, TYPE A, LOGO	SQ.FT.	
POST MOUNTED SIGNS, TYPE B, LOGO	SQ.FT.	
BREAKAWAY SYSTEMS	EACH	
* STEEL W BEAM BREAKAWAY POSTS	LBS.	
LOGO SIGN MOUNTING	EACH	
REMOVAL OF POST MOUNTED MOTORIST SERVICE SIGNS, TYPES A & E	EACH	
BREAKAWAY SYSTEM SUPPLIED BY TRUST	EACH	

* APPROXIMATE QUANTITY FOR INFORMATION ONLY

SYMBOLS

- ○ *Existing Sign to Remain*
- △ *Existing Sign to be Removed*
- □ *Existing Sign Reset as Shown*
- ● NEW SIGN
- × FUTURE SIGN
- Ø *Existing Utility Pole*

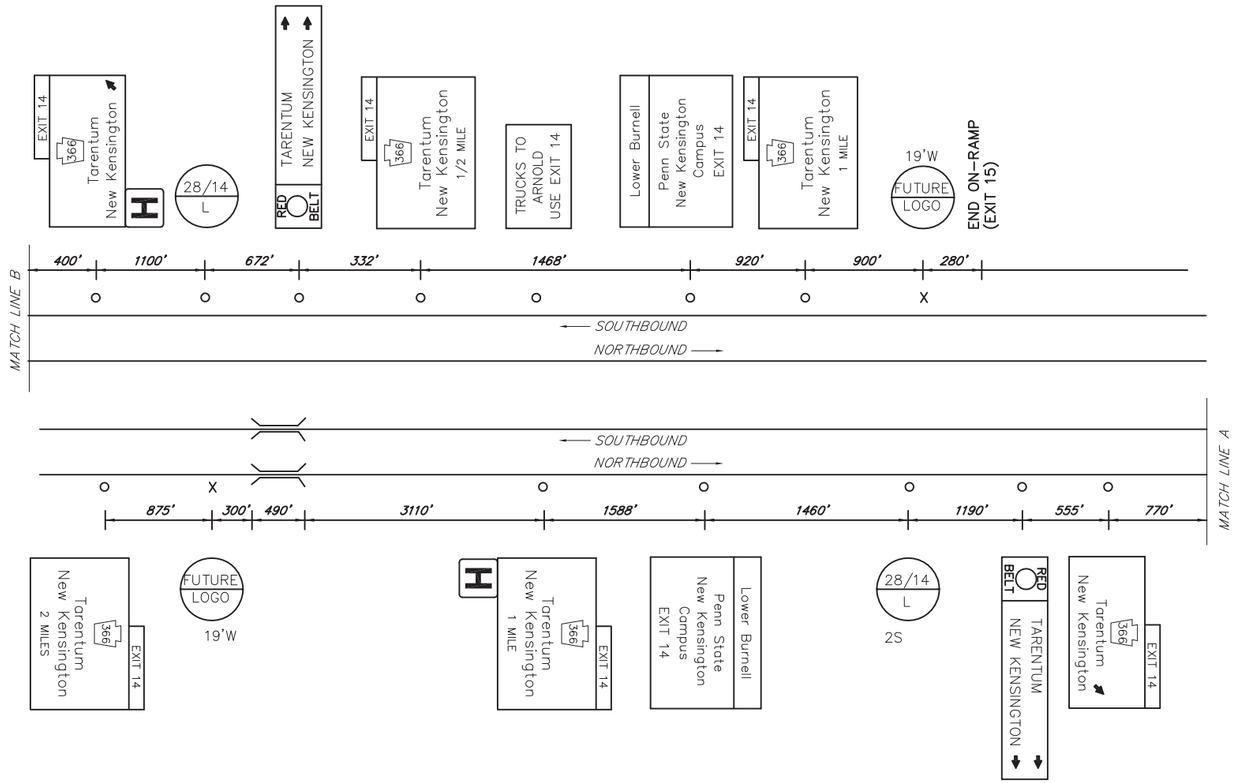

MAINLINE SCHEMATIC
NOT TO SCALE

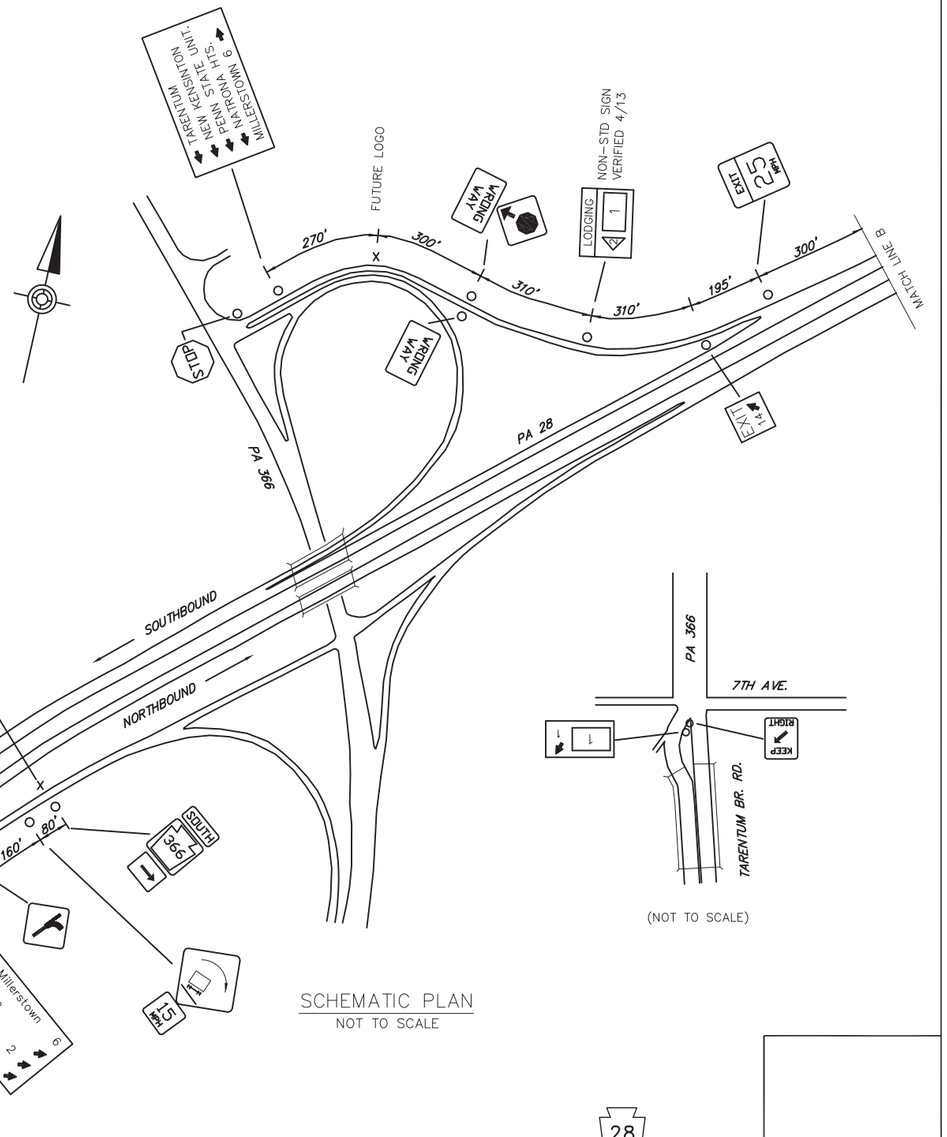

SCHEMATIC PLAN
NOT TO SCALE

(NOT TO SCALE)

EXIT 14 SPECIFIC INFORMATION PANEL			
SIGN NUMBER	LEGEND	BUSINESS	LOGO. NO.
28/14 L NB 28/14 L SB	LODGING	QUALITY INN	1

NB SIGNS

6'Hx13'W
FUTURE 10'H
W10x22
B650 – #2, #1

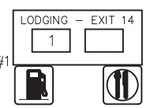

SB SIGNS

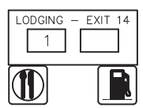

6'Hx13'W
FUTURE 12'H
W8x21
B525 – #1, #1

28

EXIT 14

D:\2015_JOBS\215076-01\VA\PSE\AS-BUILT DRAWINGS\PENNDOT DISTRICT 11\ALLEGHENY - 02\10-XX_SHTXX 28_EXIT 14 PLAN
September/6/2018 10:53 AM