DISTRICT	COUNTY	ROUTE	PROJECT	SHEET
11-0	ALLEGHENY	I-376		
FINDLAY TOWNSHIP				
REVISIONS				

TABULATION OF QUANTITIES		
ITEM	UNIT	QUANTITY
POST MOUNTED SIGNS, TYPE A, LOGO	SQ.FT.	
POST MOUNTED SIGNS, TYPE B, LOGO	SQ.FT.	
POST MOUNTED SIGNS, TYPE C, LOGO	SQ.FT.	
BREAKAWAY SYSTEMS	EACH	
* STEEL S OR W BEAM POSTS	LBS.	
LOGO SIGN MOUNTING	EACH	
REMOVAL OF POST MOUNTED MOTORIST SERVICE SIGNS, TYPES B, C & F	L.S.	

* APPROXIMATE QUANTITY FOR INFORMATION ONLY

SYMBOLS

- ○ *Existing Sign to Remain*
- △ *Existing Sign to be Removed*
- □ *Existing Sign Reset as Shown*
- ● NEW SIGN
- × FUTURE SIGN
- Ø *Existing Utility Pole*

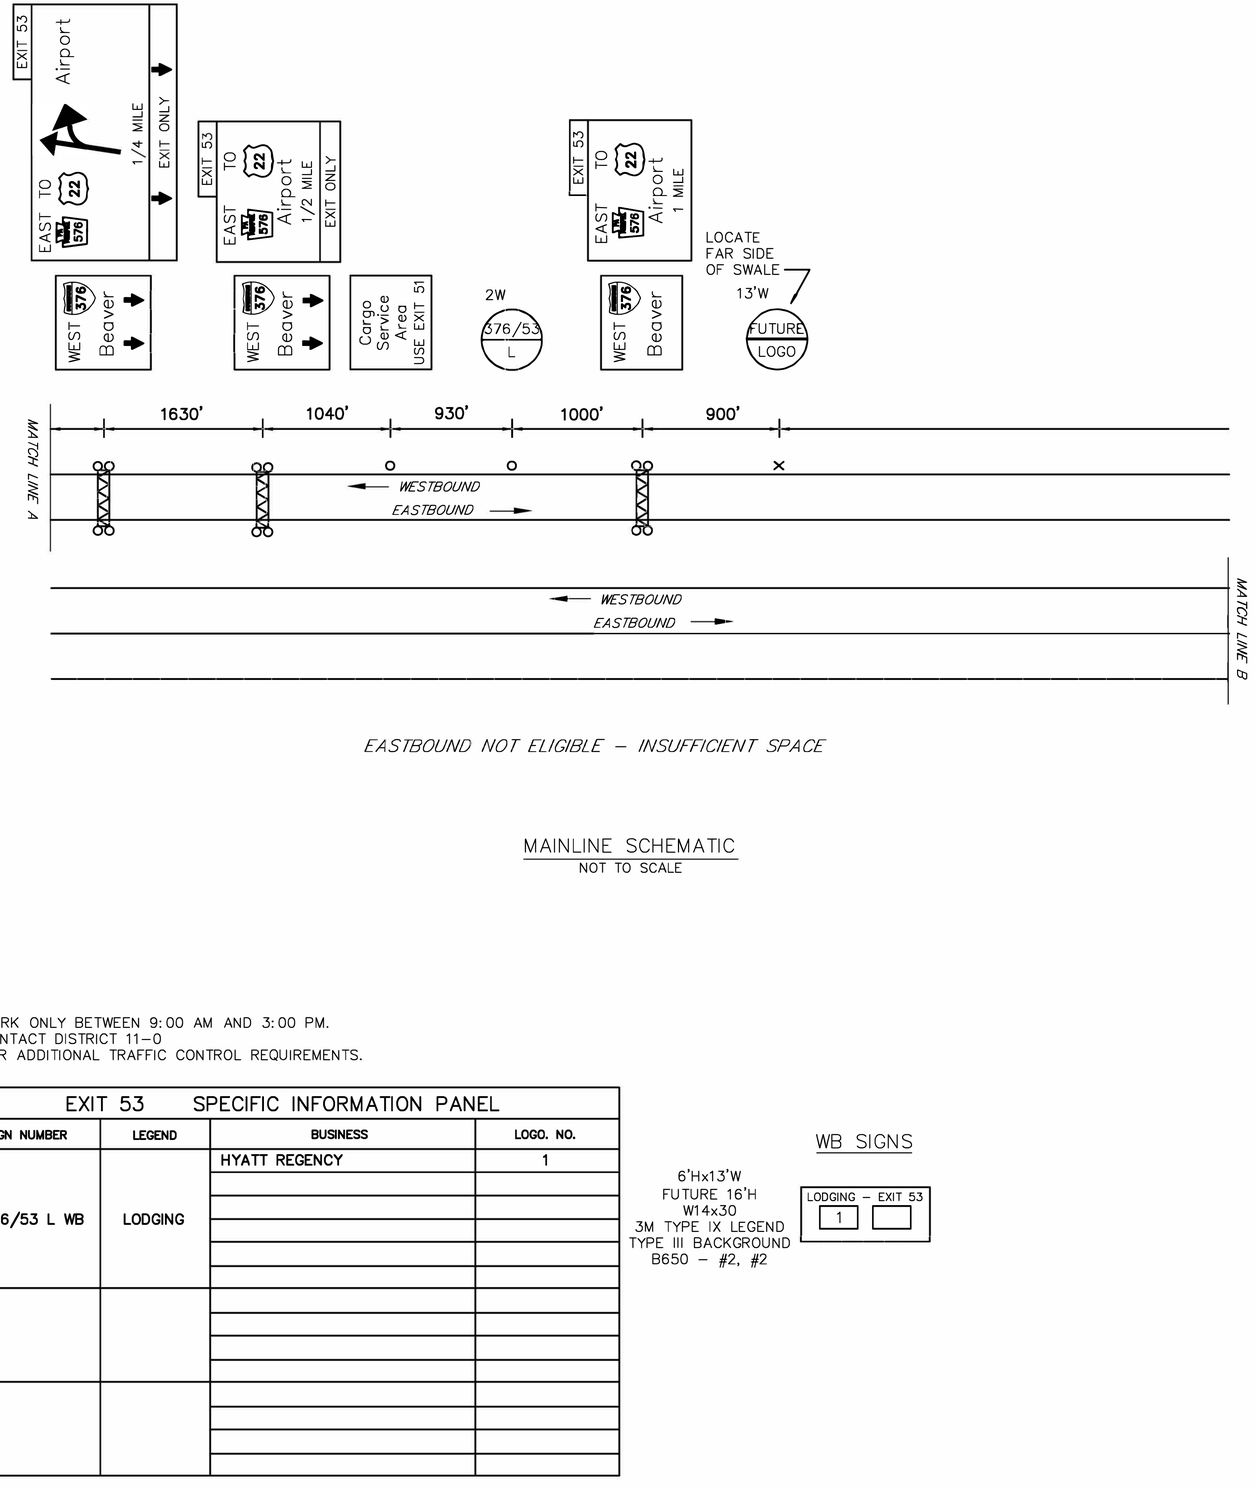

EASTBOUND NOT ELIGIBLE – INSUFFICIENT SPACE

MAINLINE SCHEMATIC
NOT TO SCALE

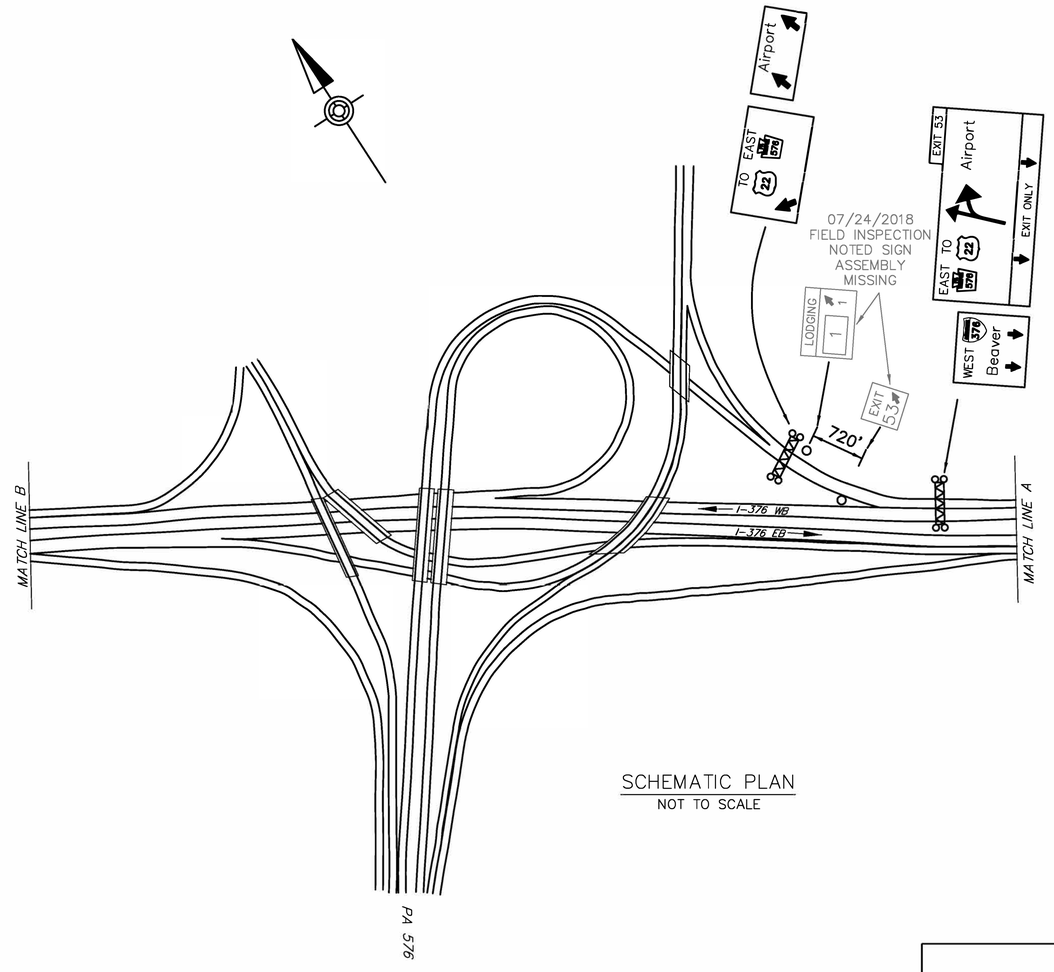

SCHEMATIC PLAN
NOT TO SCALE

WORK ONLY BETWEEN 9:00 AM AND 3:00 PM.
CONTACT DISTRICT 11-0
FOR ADDITIONAL TRAFFIC CONTROL REQUIREMENTS.

EXIT 53 SPECIFIC INFORMATION PANEL			
SIGN NUMBER	LEGEND	BUSINESS	LOGO. NO.
376/53 L WB	LODGING	HYATT REGENCY	1

WB SIGNS

6'Hx13'W
FUTURE 16'H
W14x30
3M TYPE IX LEGEND
TYPE III BACKGROUND
B650 – #2, #2

INTERSTATE 376

PGH INTN'L AIRPORT

EXIT 53

(OLD EXIT PA 60 EXIT 6)

D:\2015_JOBS\115276-01\WAPSE\AS-BUILT DRAWINGS\PENNDOT DISTRICT 11-ALLEGHENY - ROUTE-XX_SHTXX_I376_EXIT 53 PLAN
August 17, 2018 11:05 AM