DISTRICT	COUNTY	ROUTE	PROJECT	SHEET
11-0	ALLEGHENY	I-376		
CITY OF PITTSBURGH				
REVISIONS				

TABULATION OF QUANTITIES		
ITEM	UNIT	QUANTITY
POST MOUNTED SIGNS, TYPE A, LOGO	SQ.FT.	
POST MOUNTED SIGNS, TYPE B, LOGO	SQ.FT.	–
POST MOUNTED SIGNS, TYPE C, LOGO	SQ.FT.	–
BREAKAWAY SYSTEMS	EACH	
* STEEL S OR W BEAM POSTS	LBS.	
LOGO SIGN MOUNTING	EACH	
REMOVAL OF POST MOUNTED MOTORIST SERVICE SIGNS, TYPES B, C & F	L.S.	

* APPROXIMATE QUANTITY FOR INFORMATION ONLY

SYMBOLS

- ○ *Existing Sign to Remain*
- △ *Existing Sign to be Removed*
- □ *Existing Sign Reset as Shown*
- ● NEW SIGN
- × FUTURE SIGN
- Ø *Existing Utility Pole*

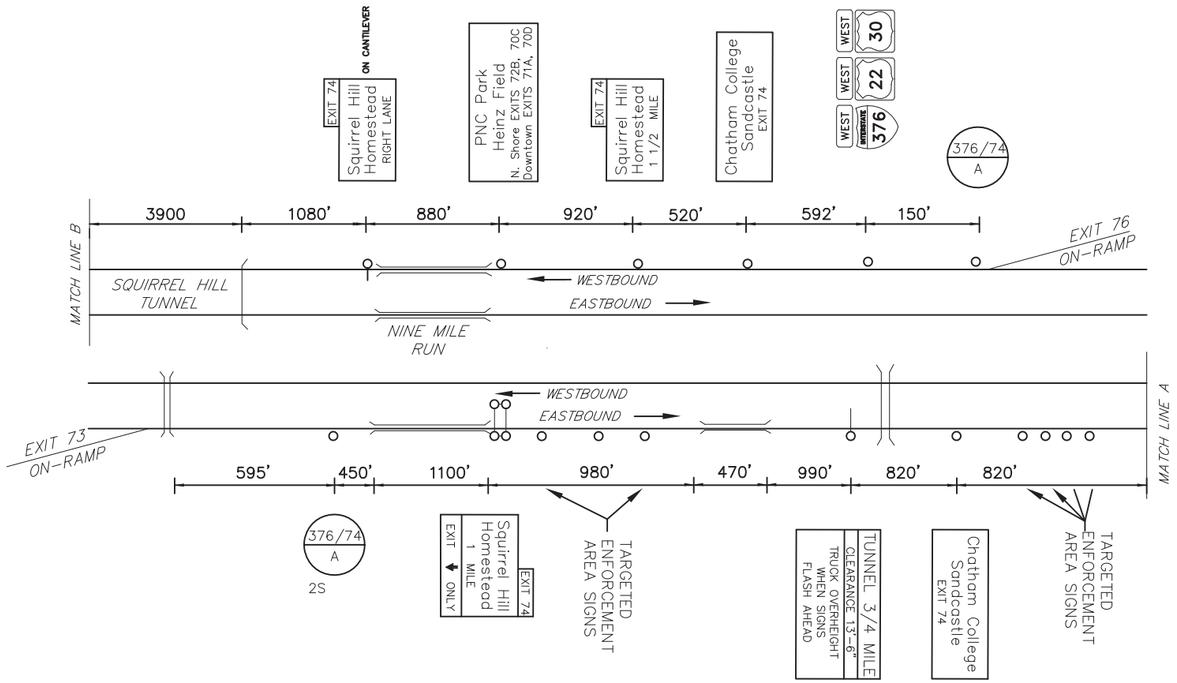

MAINLINE SCHEMATIC
NOT TO SCALE

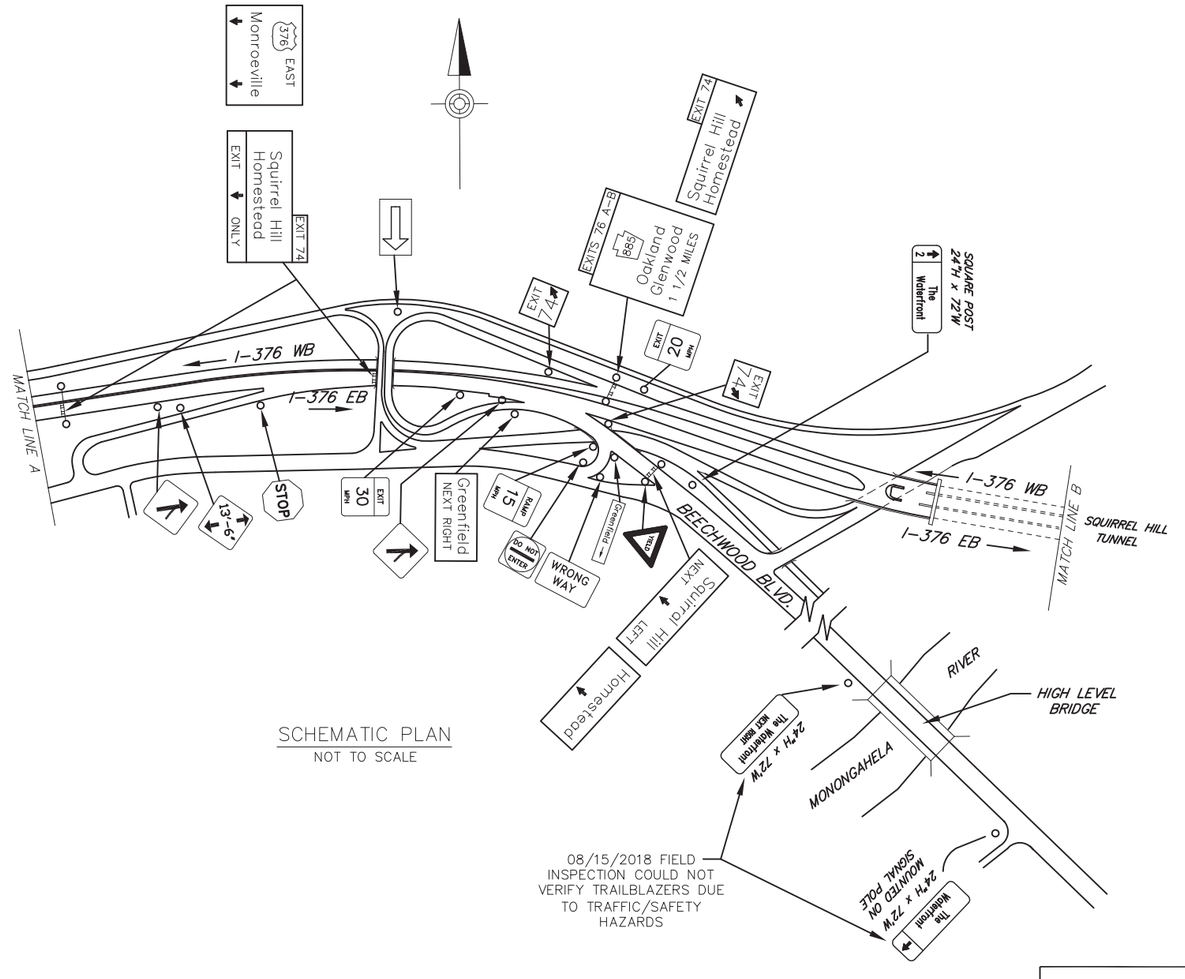

SCHEMATIC PLAN
NOT TO SCALE

08/15/2018 FIELD INSPECTION COULD NOT VERIFY TRAILBLAZERS DUE TO TRAFFIC/SAFETY HAZARDS

EB SIGNS

6H'x13'W
FUTURE 16'H
W14x30 A572
3M TYPE III
B650 – #2, #2

WB SIGNS

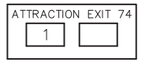

6H'x13'W
FUTURE 13'H
W14x30 A572
3M TYPE III

08/15/2018 FIELD INSPECTION COULD NOT VERIFY WB MAINLINE DUE TO TRAFFIC/SAFETY HAZARDS

EXIT 74 SPECIFIC INFORMATION PANEL			
SIGN NUMBER	LEGEND	BUSINESS	LOGO. NO.
376/74 A EB 376/74 A WB	ATTRACTION	THE WATERFRONT	1

INTERSTATE 376

SQUIRREL HILL / HOMESTEAD

EXIT 74

(OLD EXIT 5)

D:\2015_JOBS\215074-01\VA\PSE\AS-BUILT DRAWINGS\PENNDOT DISTRICT 11\ALLEGHENY - 02\10-XX_SHTXX I376_EXIT 74 PLAN
September/5/2018 11:43 AM