DISTRICT	COUNTY	ROUTE	PROJECT	SHEET
10-0	BUTLER	I-79		

LANCASTER & JACKSON TWPS. AND BOROUGH OF HARMONY

REVISIONS

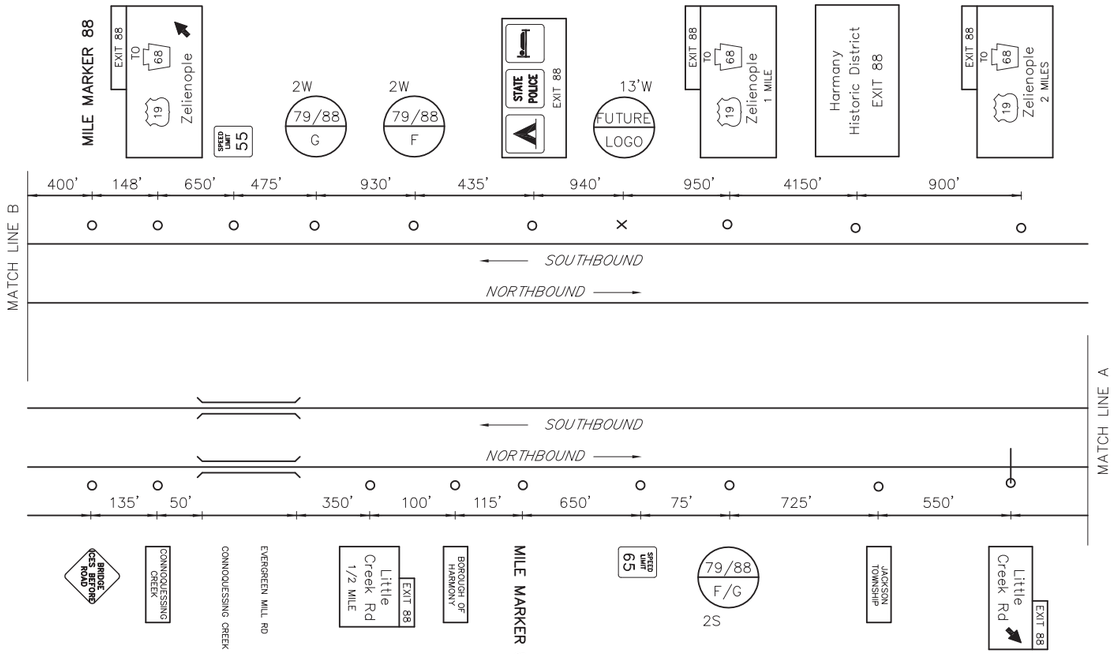

MAINLINE SCHEMATIC

NOT TO SCALE

TABULATION OF QUANTITIES		
ITEM	UNIT	QUANTITY
POST MOUNTED SIGNS, TYPE A, LOGO	SQ.FT.	
POST MOUNTED SIGNS, TYPE B, LOGO	SQ.FT.	–
POST MOUNTED SIGNS, TYPE C, LOGO	SQ.FT.	–
BREAKAWAY SYSTEMS	EACH	
* STEEL S OR W BEAM POSTS	LBS.	
LOGO SIGN MOUNTING	EACH	
REMOVAL OF POST MOUNTED MOTORIST SERVICE SIGNS, TYPES A, B, C, E & F	L.S.	

* APPROXIMATE QUANTITY FOR INFORMATION ONLY

SYMBOLS

- ○ *Existing Sign to Remain*
- △ *Existing Sign to be Removed*
- □ *Existing Sign Reset as Shown*
- ● NEW SIGN
- × FUTURE SIGN
- Ø *Existing Utility Pole*

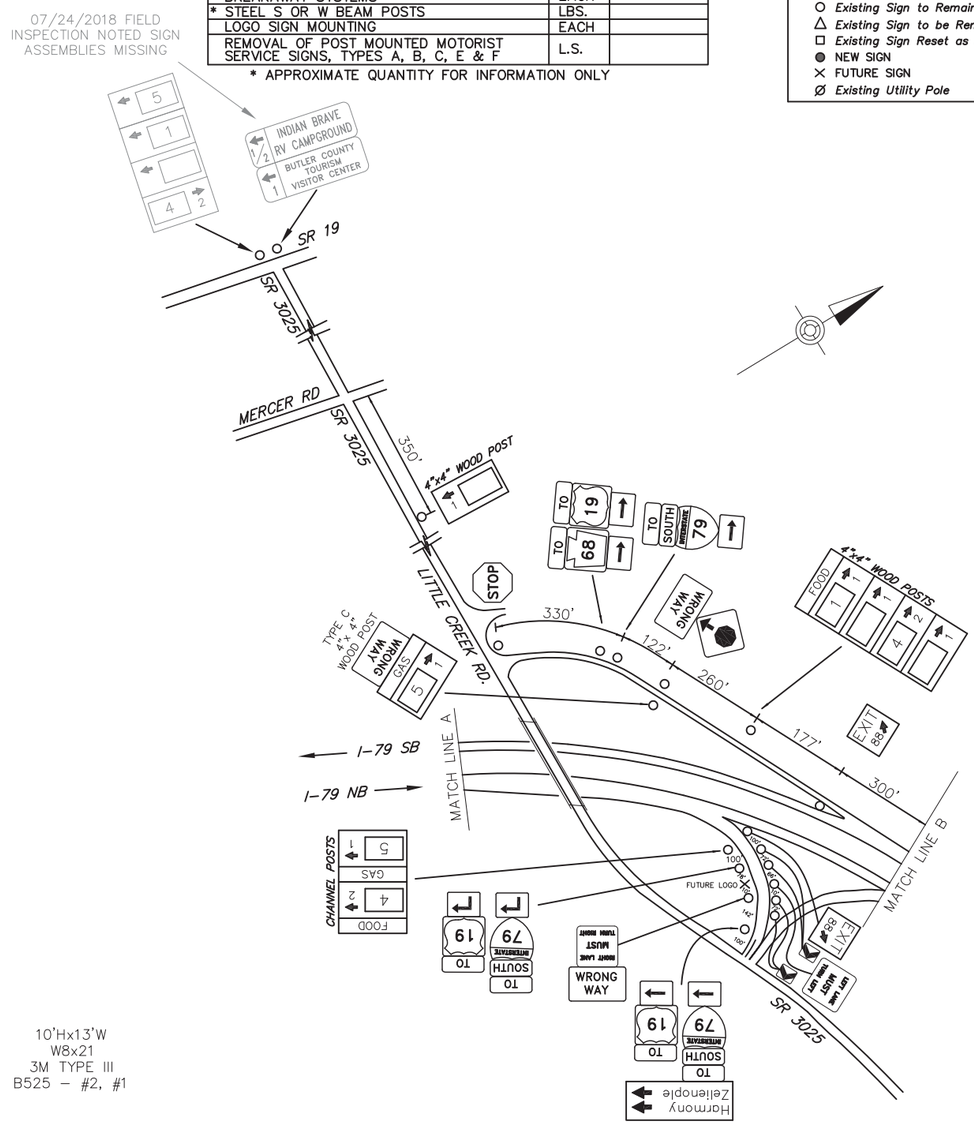

SCHEMATIC PLAN

NOT TO SCALE

EXIT 88 SPECIFIC INFORMATION PANEL			
SIGN NUMBER	LEGEND	BUSINESS	LOGO. NO.
79/88 F NB 79/88 F SB	FOOD	BURGER KING	1
		LOG CABIN INN	4
79/88 G NB 79/88 G SB	GAS	BILO (24 hrs – Diesel)	5

NB SIGNS

10'Hx19'W
W18x40 A572
TYPE IX LEGEND
TYPE III BACKGROUND
2'Hx6.5'W EXIT PANEL
B650 – #3, #2

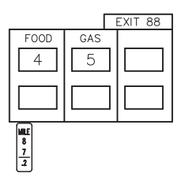

SB SIGNS

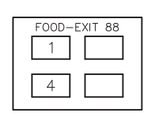

10'Hx13'W
W8x21
3M TYPE III
B525 – #2, #1

6'Hx13'W
FUTURE 16'H
W18x40
TYPE IX LEGEND
TYPE III BACKGROUND
B650 – #2, #2

INTERSTATE 79

LITTLE CREEK ROAD
ZELIENOPLE

EXIT 88

D:\2015_JOBS\215076-01\HW\PSE\AS-BUILT DRAWINGS\PENNDOT DISTRICT 10\BUTLER - 10\10-XX SHTXX-I79_EXIT 88 PLAN
August/9/2018 5:19 PM