DISTRICT	COUNTY	ROUTE	PROJECT	SHEET
2-0	CENTRE	I-80		

BOGGS, MARION AND SPRINGS TOWNSHIP

REVISIONS

TABULATION OF QUANTITIES		
ITEM	UNIT	QUANTITY
POST MOUNTED SIGNS, TYPE A, LOGO	SQ.FT.	–
POST MOUNTED SIGNS, TYPE B, LOGO	SQ.FT.	–
POST MOUNTED SIGNS, TYPE C, LOGO	SQ.FT.	–
BREAKAWAY SYSTEMS	EACH	–
* STEEL S OR W BEAM POSTS	LBS.	–
LOGO SIGN MOUNTING	EACH	–
FLAT SHEET PANEL REPLACEMENT	SQ.FT.	–
EXTRUDED PANEL REPLACEMENT	SQ.FT.	–
REMOVAL OF POST MOUNTED MOTORIST SERVICE SIGNS, TYPES B, C & F	L.S.	–

* APPROXIMATE QUANTITY FOR INFORMATION ONLY

SYMBOLS

- Existing Sign to Remain
- Existing Sign to be Removed
- Existing Sign Reset as Shown
- NEW SIGN
- FUTURE SIGN
- Existing Utility Pole

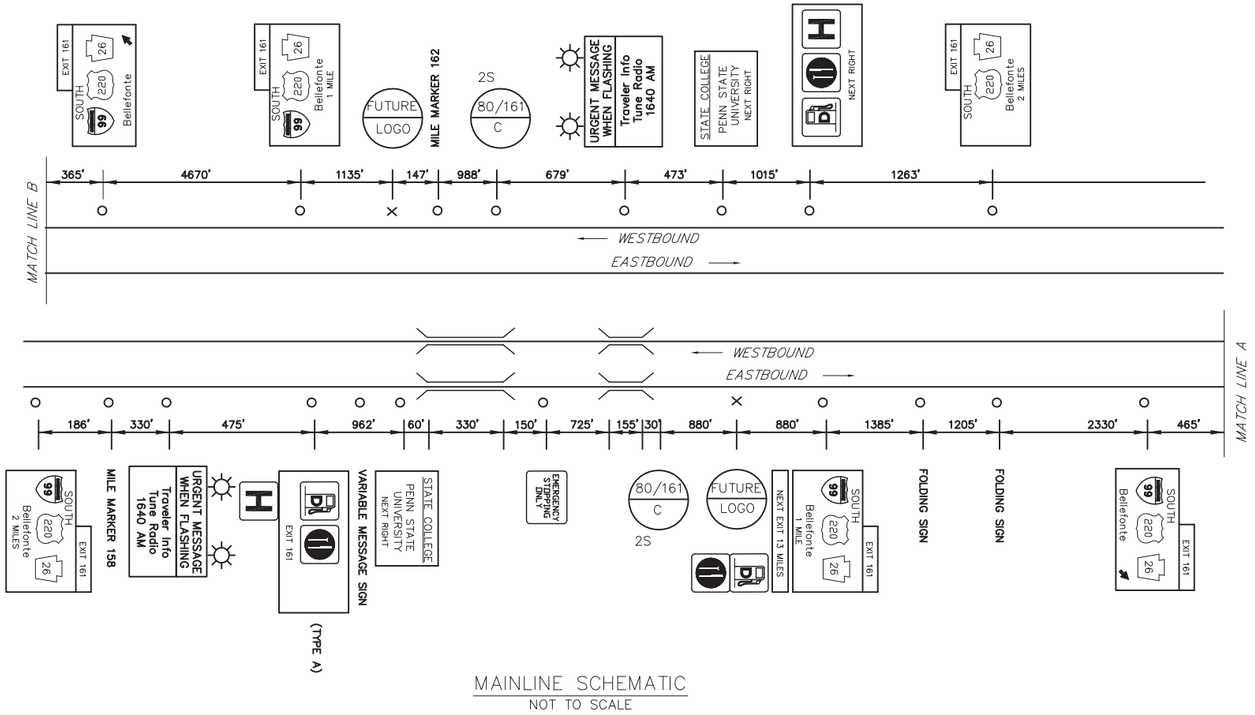

MAINLINE SCHEMATIC

NOT TO SCALE

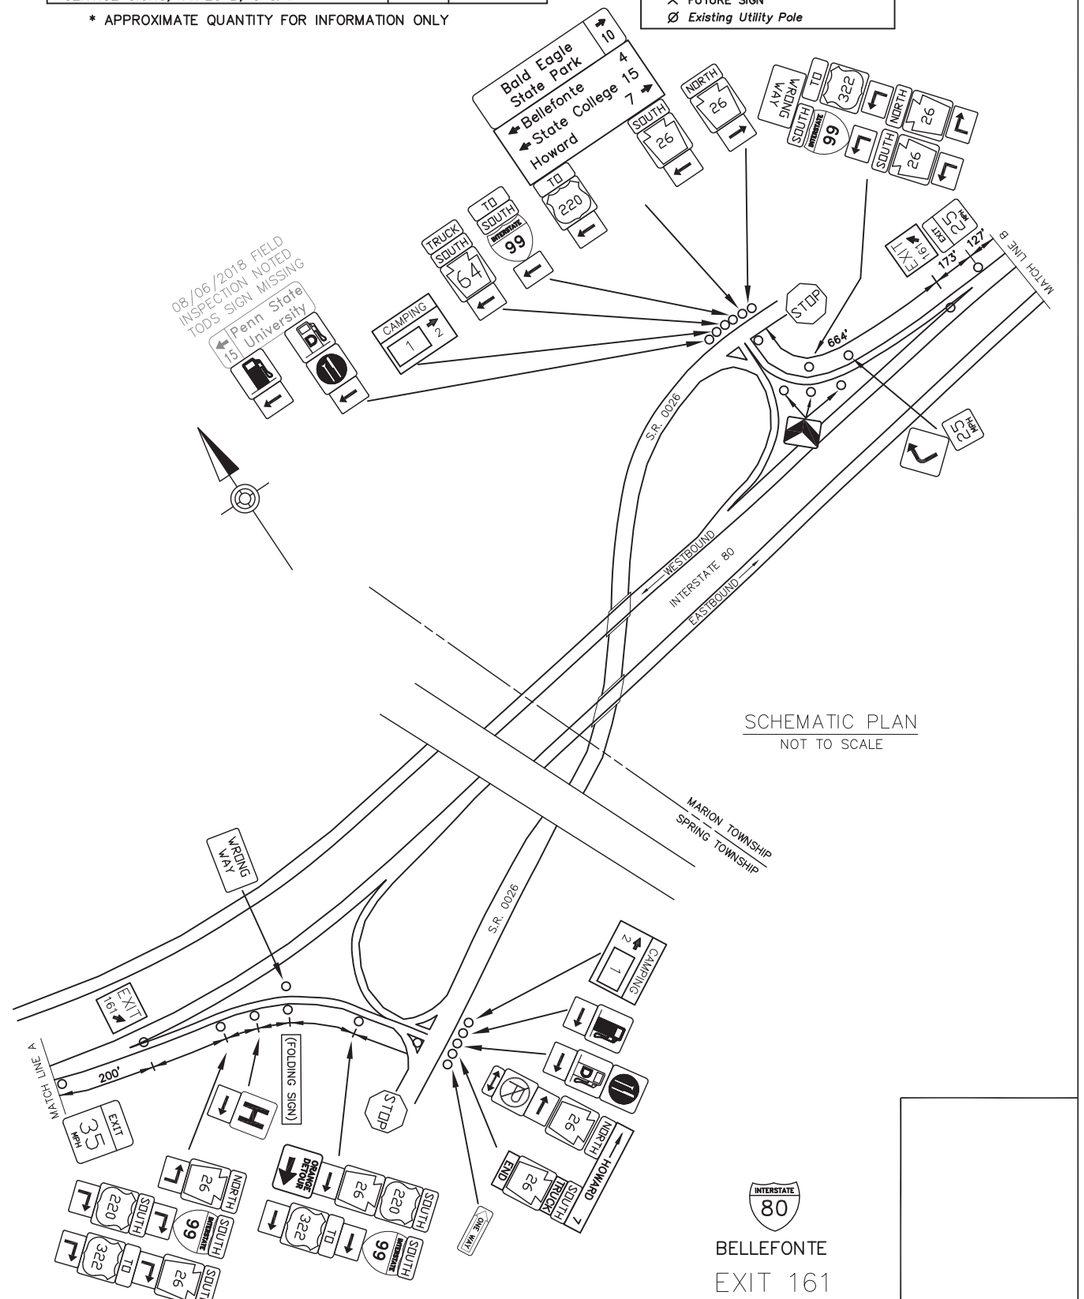

SCHEMATIC PLAN

NOT TO SCALE

EXIT 161 SPECIFIC INFORMATION PANEL			
SIGN NUMBER	LEGEND	BUSINESS	LOGO. NO.
80/161 C EB 80/161 C WB	CAMPING	KOA KAMPGROUND	1

EB SIGNS

6'Hx13'W
FUTURE 12'H
W10x26 A36
B650 – #2, #1

CAMPING – EXIT 161 | 1 |

WB SIGNS

CAMPING – EXIT 161 | 1 |

6'Hx13'W
FUTURE 12'H
W10x26 A36
B650 – #2, #1

INTERSTATE 80

BELLEFONTE

EXIT 161

D:\2015_0285\215974-01\MxD\PSE\AS-BUILT DRAWINGS\PENNDOT DISTRICT 02\CENTRE - 14\10-XX SHTXX-180_EXIT 161 PLAN
August 10, 2018 3:07 PM