DISTRICT	COUNTY	ROUTE	PROJECT	SHEET
10-0	JEFFERSON	I-80		

PINE CREEK TOWNSHIP

REVISIONS

TABULATION OF QUANTITIES		
ITEM	UNIT	QUANTITY
POST MOUNTED SIGNS, TYPE A, LOGO	SQ.FT.	-
POST MOUNTED SIGNS, TYPE B, LOGO	SQ.FT.	-
POST MOUNTED SIGNS, TYPE C, LOGO	SQ.FT.	-
BREAKAWAY SYSTEMS	EACH	-
* STEEL S OR W BEAM POSTS	LBS.	-
LOGO SIGN MOUNTING	EACH	-

* APPROXIMATE QUANTITY FOR INFORMATION ONLY

SYMBOLS

- ○ *Existing Sign to Remain*
- △ *Existing Sign to be Removed*
- □ *Existing Sign Reset as Shown*
- ● NEW SIGN
- × FUTURE SIGN
- Ø *Existing Utility Pole*

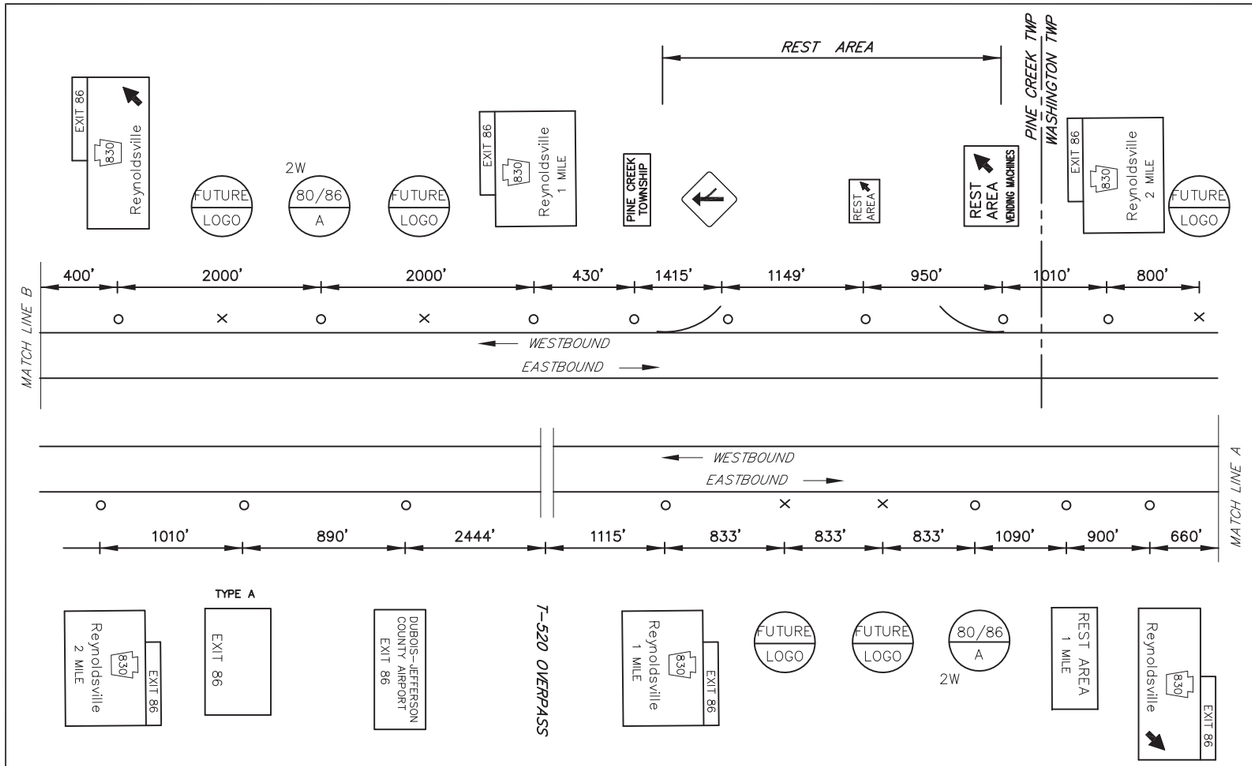

MAINLINE SCHEMATIC
NOT TO SCALE

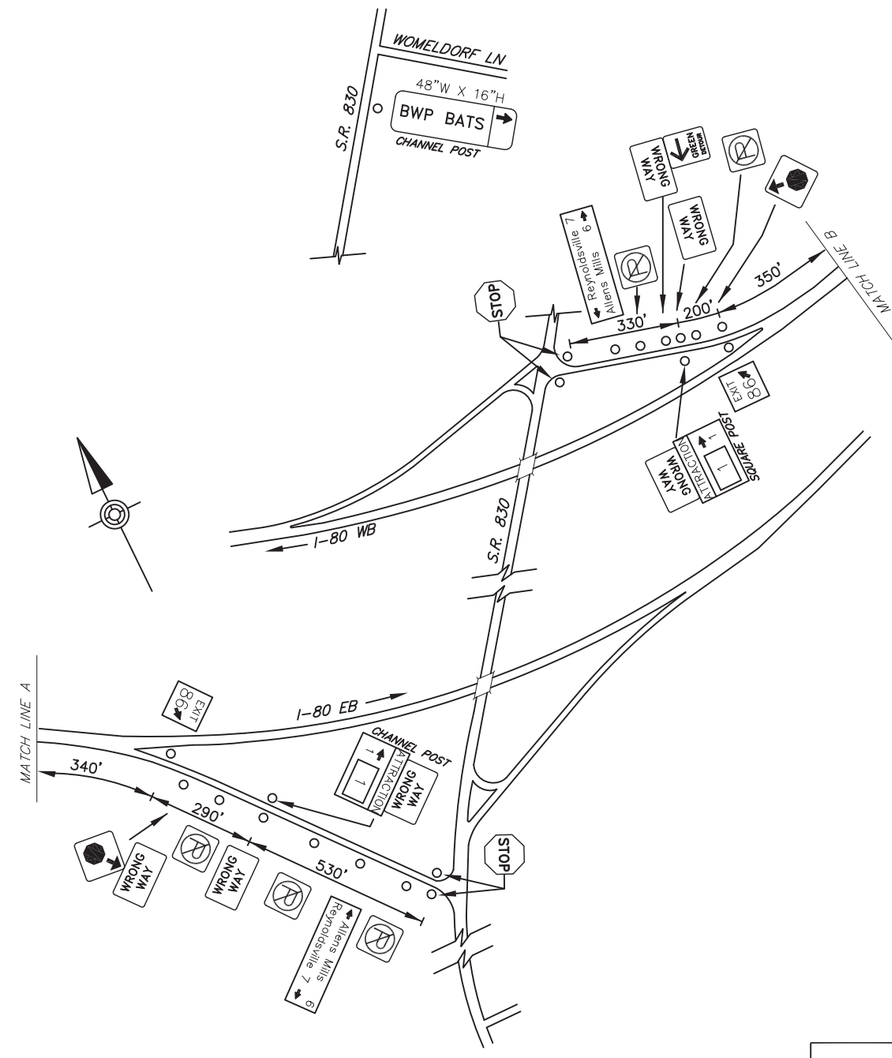

SCHEMATIC PLAN
NOT TO SCALE

EXIT 86 SPECIFIC INFORMATION PANEL			
SIGN NUMBER	LEGEND	BUSINESS	LOGO. NO.
80/86 A WB	ATTRACTION	BWP BATS	1
80/86 A EB			

EB SIGNS

6'Hx19'W
FUTURE 10'H
W14x30
B650 - #2, #1

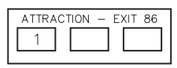

WB SIGNS

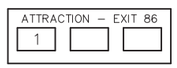

6'Hx19'W
FUTURE 10'H
W10x26
B650 - #2, #1

INTERSTATE 80

REYNOLDSVILLE/PA 830

EXIT 86

D:\2015_JOB\12\12507E-01\MV_PSE\AS-BUILT DRAWINGS\PENNDOT DISTRICT 10\JEFFERSON - 33\10-XX SHTX180_EXIT 86 PLAN
August/16/2018 4:38 PM