DISTRICT	COUNTY	ROUTE	PROJECT	SHEET
6-0	PHILADELPHIA	I-95		

CITY OF PHILADELPHIA
REVISIONS

TABULATION OF QUANTITIES		
ITEM	UNIT	QUANTITY
POST MOUNTED SIGNS, TYPE A, LOGO	SQ.FT.	
POST MOUNTED SIGNS, TYPE B, LOGO	SQ.FT.	
POST MOUNTED SIGNS, TYPE C, LOGO	SQ.FT.	–
BREAKAWAY SYSTEMS	EACH	
* STEEL S OR W BEAM POSTS	LBS.	
LOGO SIGN MOUNTING	EACH	
TYPE B SIGNS SUPPLIED BY TRUST	SQ.FT.	

* APPROXIMATE QUANTITY FOR INFORMATION ONLY

SYMBOLS

- ○ *Existing Sign to Remain*
- △ *Existing Sign to be Removed*
- □ *Existing Sign Reset as Shown*
- ● NEW SIGN
- × FUTURE SIGN
- Ø *Existing Utility Pole*

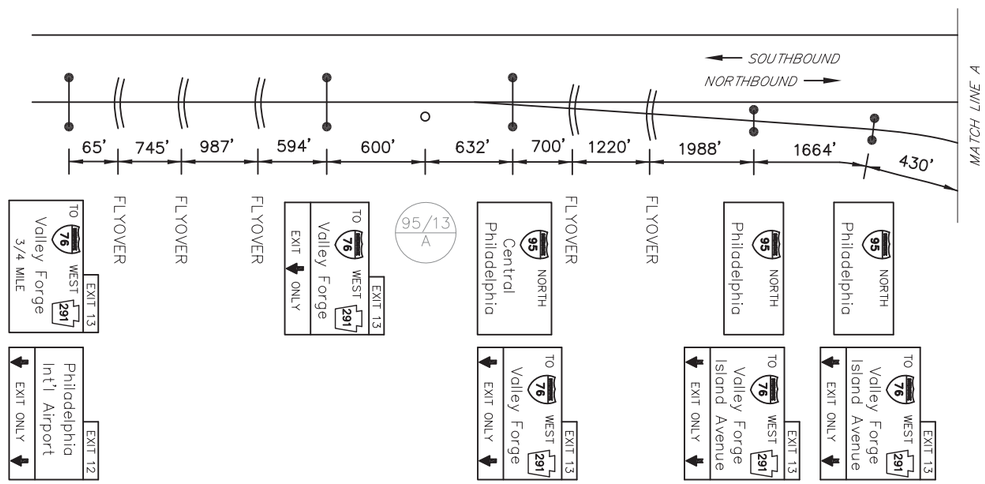

MAINLINE SCHEMATIC
NOT TO SCALE

LANE CLOSURES & RESTRICTIONS ON I-95 ONLY PERMITTED BETWEEN 10:00 PM AND 5:00 AM MONDAY THRU FRIDAY, AND MUST BE SCHEDULED & COORDINATED WITH DISTRICT 6-0 TRAFFIC UNIT AT LEAST TWO WEEKS IN ADVANCE – CONTACT EDWARD BURNS 610-205-6925.

EXIT 13 SPECIFIC INFORMATION PANEL			
SIGN NUMBER	LEGEND	BUSINESS	LOGO. NO.
95/13 A NB	ATTRACTION		

NB SIGNS

6'Hx19'W
FUTURE 14'H
W10x26 A572
TYPE IX LEGEND
TYPE III BACKGROUND
B650 – #1, #1

ATTRACTION – EXIT 13

08/24/2018 FIELD INSPECTION NOTED MAINLINE SIGN MISSING

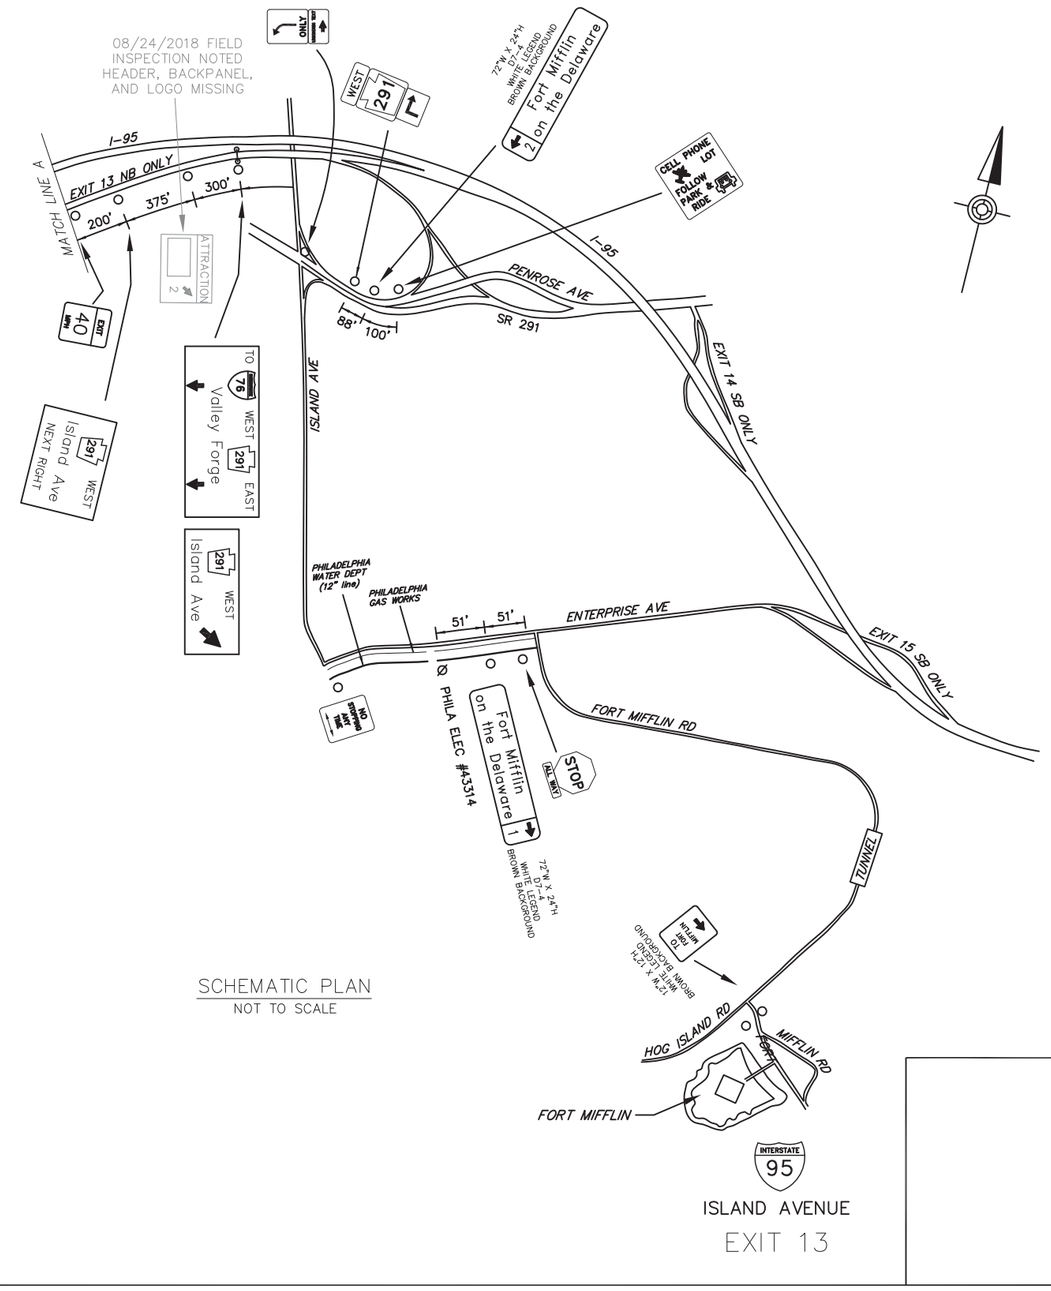

SCHEMATIC PLAN
NOT TO SCALE

ISLAND AVENUE
EXIT 13

D:\2015_EIBS\215076-01\HW\PSE\AS-BUILT DRAWINGS\PENNDOT DISTRICT 06\PHILADELPHIA - 67\10-XX SHTXX-195_EXIT 13 PLAN
September/5/2018 10:15 AM