DISTRICT	COUNTY	ROUTE	PROJECT	SHEET
1-0	ERIE	I-90		
FAIRVIEW & McKEAN TOWNSHIPS				
REVISIONS				

TABULATION OF QUANTITIES		
ITEM	UNIT	QUANTITY
POST MOUNTED SIGNS, TYPE A, LOGO	SQ.FT.	–
POST MOUNTED SIGNS, TYPE B, LOGO	SQ.FT.	–
POST MOUNTED SIGNS, TYPE C, LOGO	SQ.FT.	–
BREAKAWAY SYSTEMS	EACH	–
* STEEL S OR W BEAM POSTS	LBS.	–
LOGO SIGN MOUNTING	EACH	–
FLAT SHEET PANEL REPLACEMENT	SQ. FT.	
EXTRUDED PANEL REPLACEMENT	SQ. FT.	
REMOVAL OF POST MOUNTED MOTORIST SERVICE SIGNS, TYPES B, C & F	L.S.	–

* APPROXIMATE QUANTITY FOR INFORMATION ONLY

SYMBOLS

- *Existing Sign to Remain*
- *Existing Sign to be Removed*
- *Existing Sign Reset as Shown*
- NEW SIGN
- FUTURE SIGN
- *Existing Utility Pole*

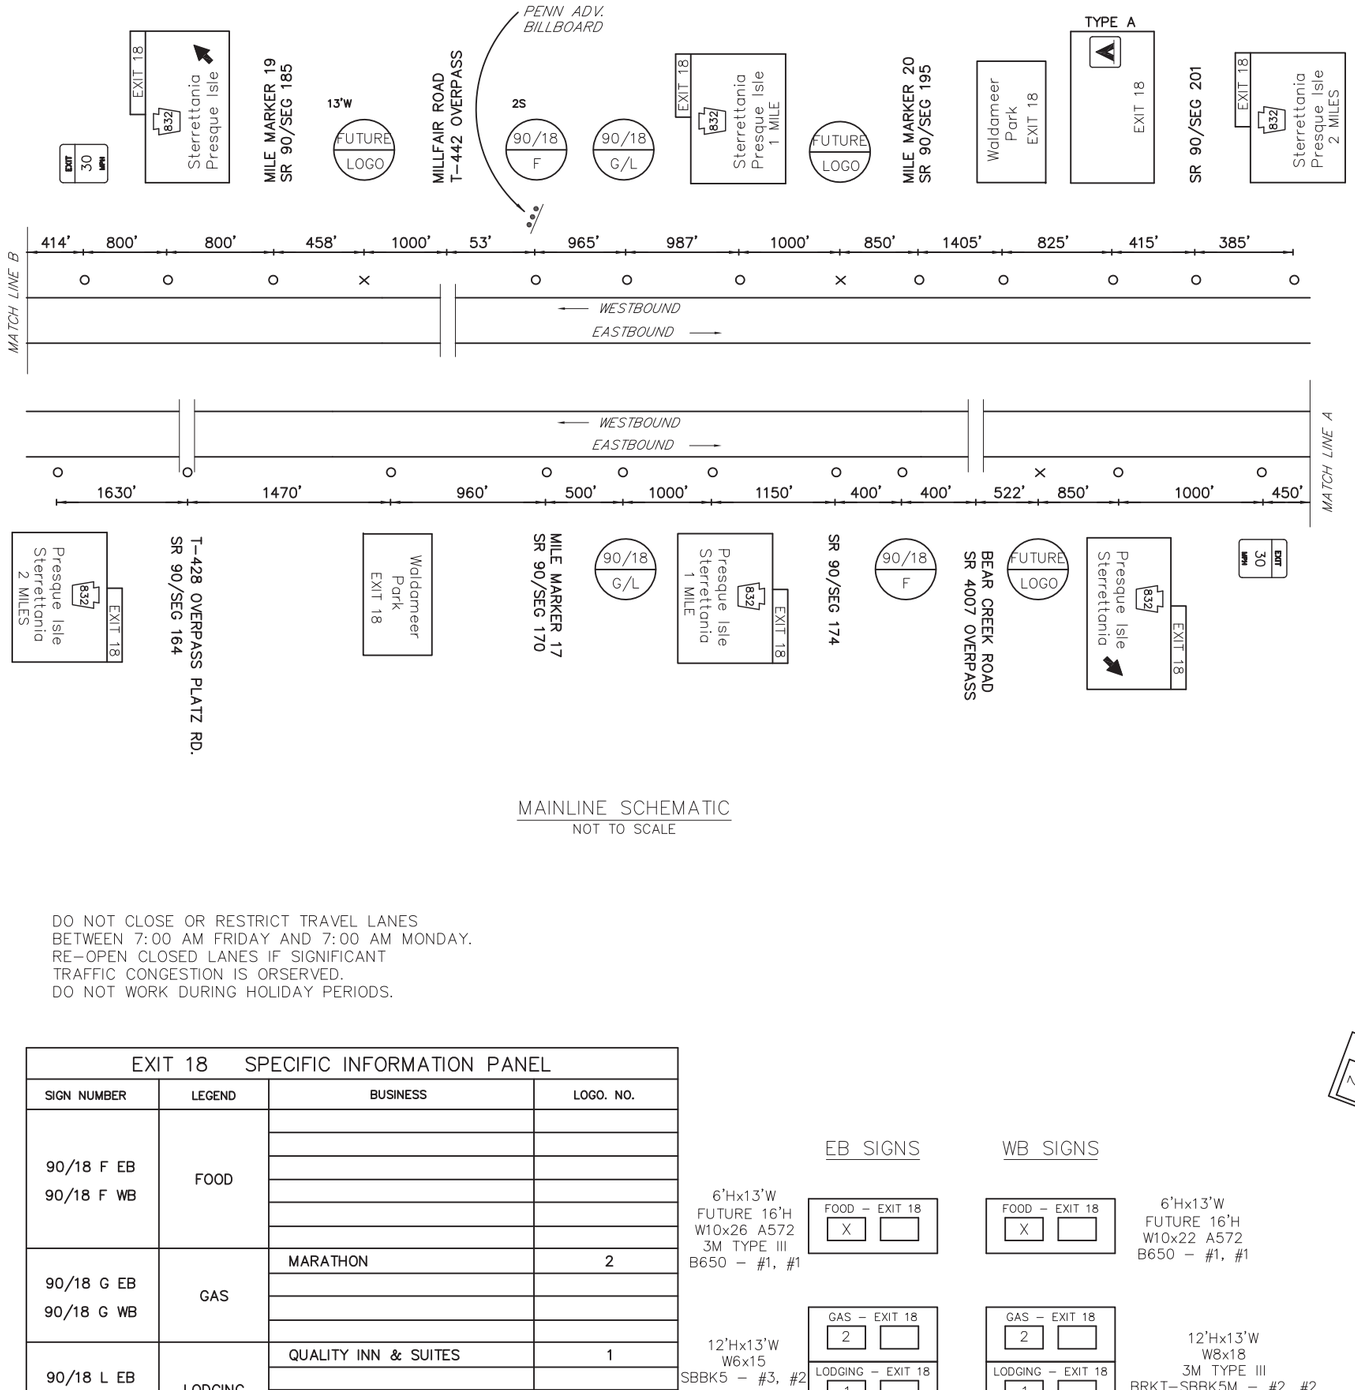

MAINLINE SCHEMATIC
NOT TO SCALE

DO NOT CLOSE OR RESTRICT TRAVEL LANES
BETWEEN 7:00 AM FRIDAY AND 7:00 AM MONDAY.
RE-OPEN CLOSED LANES IF SIGNIFICANT
TRAFFIC CONGESTION IS ORSERVED.
DO NOT WORK DURING HOLIDAY PERIODS.

EXIT 18 SPECIFIC INFORMATION PANEL			
SIGN NUMBER	LEGEND	BUSINESS	LOGO. NO.
90/18 F EB 90/18 F WB	FOOD		
90/18 G EB 90/18 G WB	GAS	MARATHON	2
90/18 L EB 90/18 L WB	LODGING	QUALITY INN & SUITES	1

EB SIGNS

6'Hx13'W FUTURE 16'H W10x26 A572 3M TYPE III B650 – #1, #1

12'Hx13'W W6x15 SBBK5 – #3, #2

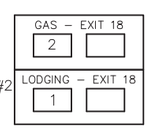

WB SIGNS

6'Hx13'W FUTURE 16'H W10x22 A572 B650 – #1, #1

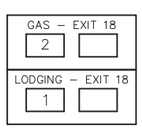

12'Hx13'W W8x18 3M TYPE III BRKT-SBBK5M – #2, #2

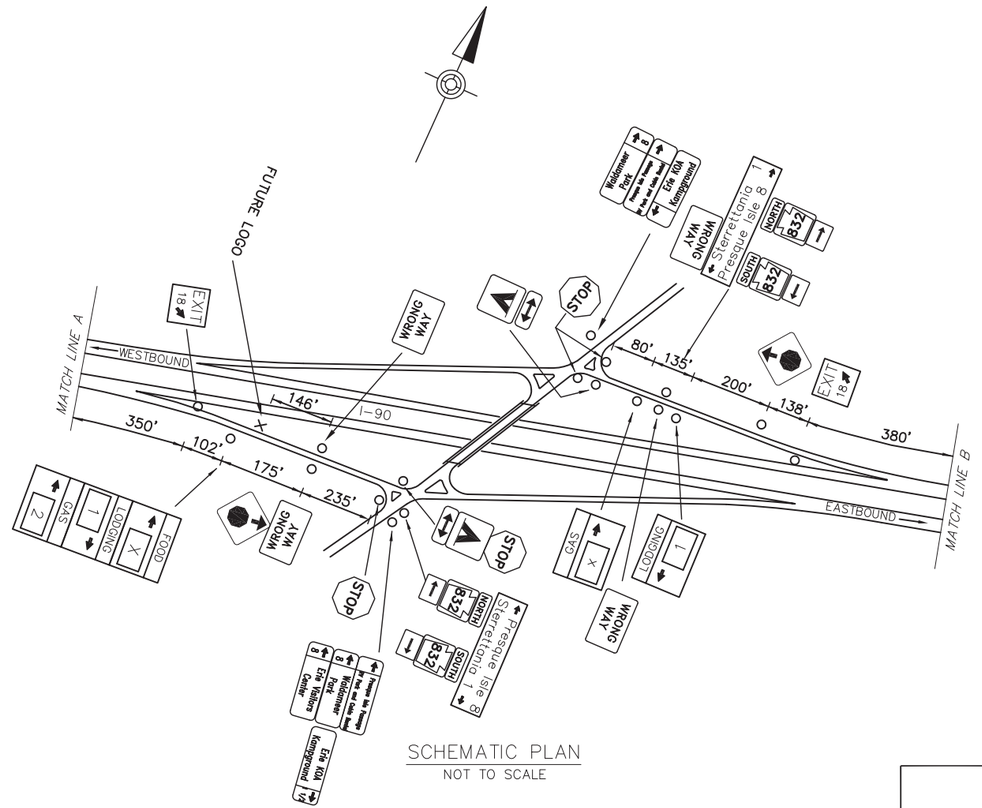

SCHEMATIC PLAN
NOT TO SCALE

INTERSTATE 90

PRESQUE ISLE/STERRETTANIA
EXIT 18

D:\2015\D0151\215976-01\MVPSE\AS-BUILT DRAWINGS\PENNDOT DISTRICT 01\ERIE - 2015-XX SHTXX-190_EXIT 18 PLAN
October/2/2018 1:46 PM