DISTRICT	COUNTY	ROUTE	PROJECT	SHEET
4-0	SUSQUEHANNA	I-81		

NEW MILFORD BOROUGH AND NEW MILFORD TOWNSHIP

REVISIONS

TABULATION OF QUANTITIES		
ITEM	UNIT	QUANTITY
POST MOUNTED SIGNS, TYPE A, LOGO	SQ.FT.	
POST MOUNTED SIGNS, TYPE B, LOGO	SQ.FT.	
POST MOUNTED SIGNS, TYPE C, LOGO	SQ.FT.	
BREAKAWAY SYSTEMS	EACH	
* STEEL S OR W BEAM POSTS	LBS.	
LOGO SIGN MOUNTING	EACH	
REMOVAL OF POST MOUNTED MOTORIST SERVICE SIGNS, TYPES A & E	EACH	
REMOVAL OF POST MOUNTED MOTORIST SERVICE SIGNS, TYPES B, C & F	L.S.	

* APPROXIMATE QUANTITY FOR INFORMATION ONLY

SYMBOLS

- ○ *Existing Sign to Remain*
- △ *Existing Sign to be Removed*
- □ *Existing Sign Reset as Shown*
- ● NEW SIGN
- × FUTURE SIGN
- Ø *Existing Utility Pole*

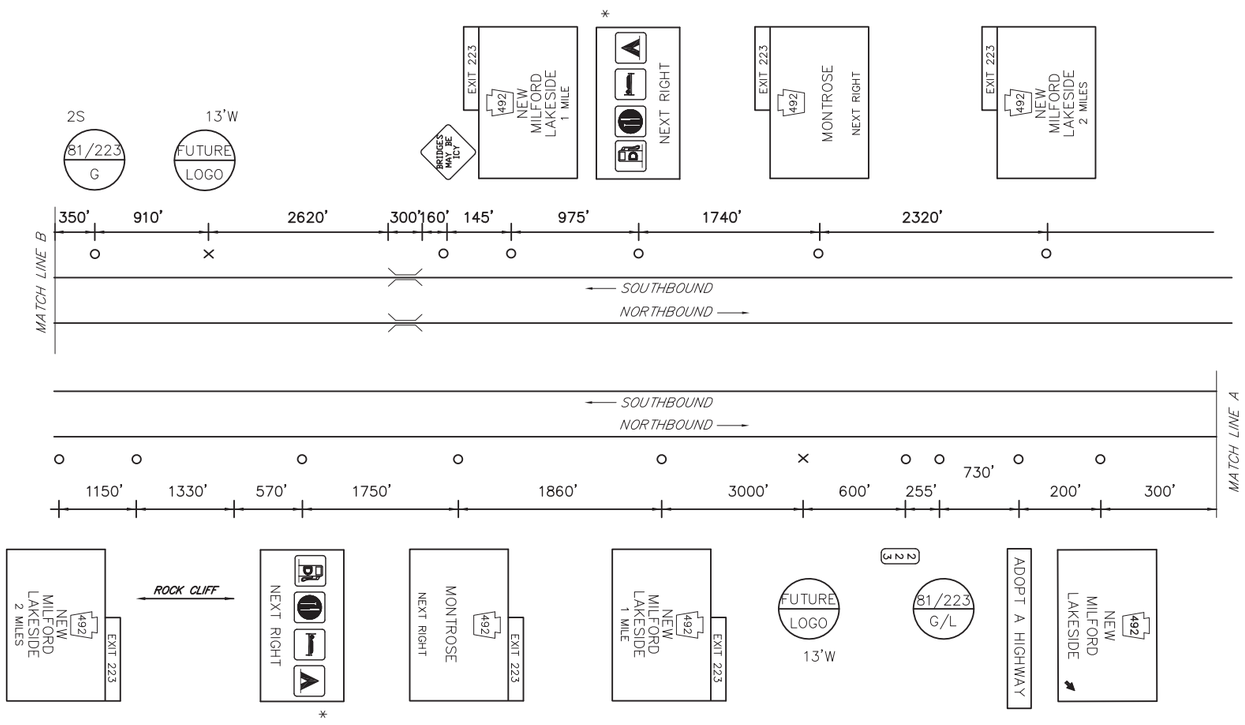

MAINLINE SCHEMATIC

NOT TO SCALE

* DIESEL GMS SYMBOLS TO REMAIN

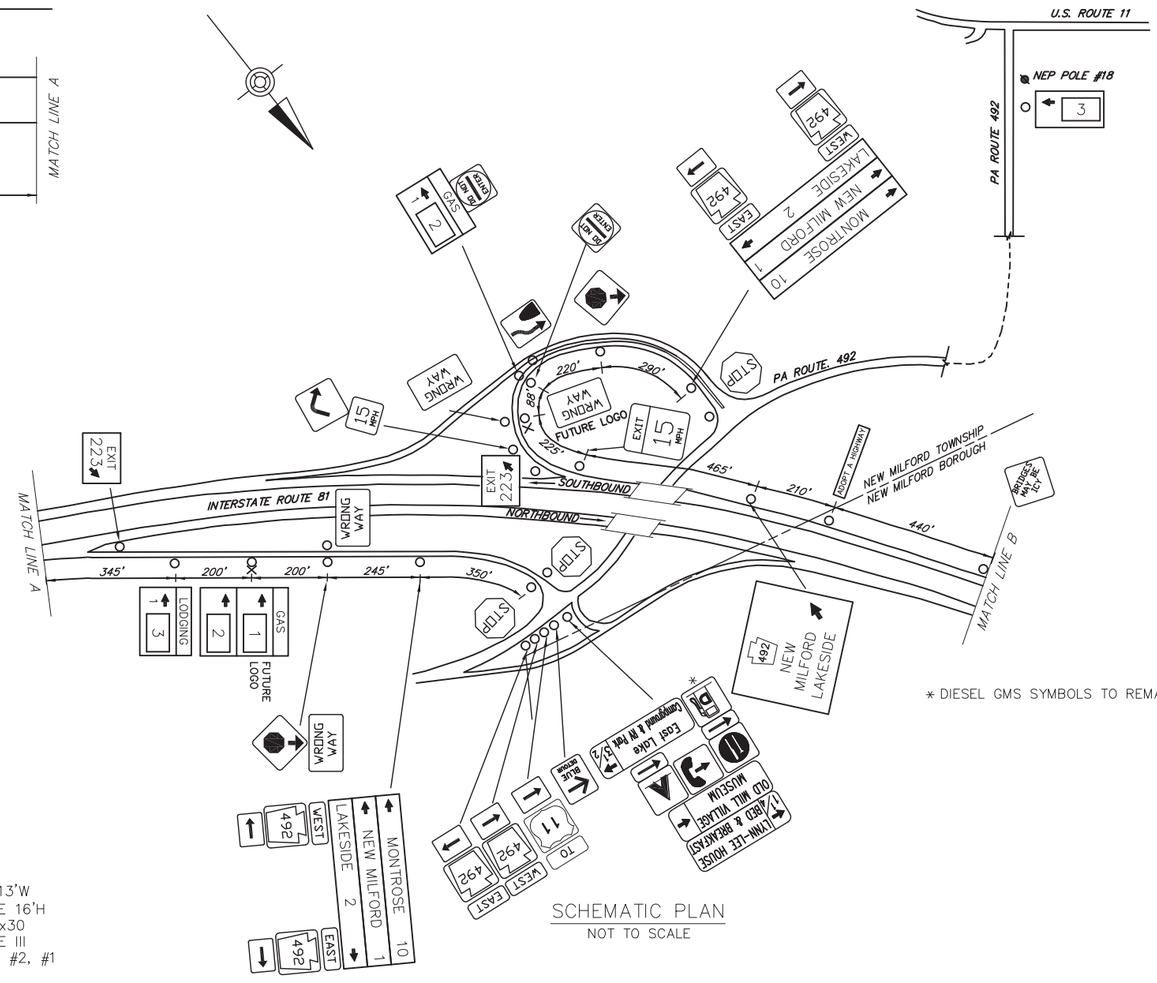

* DIESEL GMS SYMBOLS TO REMAIN

SCHEMATIC PLAN

NOT TO SCALE

EXIT #223 SPECIFIC INFORMATION PANEL			
SIGN NUMBER	LEGEND	BUSINESS	LOGO. NO.
81/233 G NB 81/233 G SB	GAS	GULF (DIESEL)	1
		CITGO	2
81/233 L NB	LODGING	BLUE RIDGE MOTEL	3

NB SIGNS

12'Hx13'W
FUTURE 16'H
W12x26
TYPE III
B650 – #1, #2

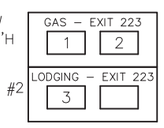

SB SIGNS

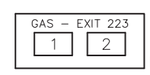

6'Hx13'W
FUTURE 16'H
W14x30
TYPE III
B650 – #2, #1

INTERSTATE 81

NEW MILFORD

EXIT 223

\\DAWPROJ01\PROJECTS\2015JOBS\215076-01\HW\PSE\AS-BUILT DRAWINGS\PENNDOT DISTRICT 04\SUSQUEHANNA - 57\10-XX SHTXX-181_EXIT223 PLAN
February/8/2019 1:49 PM