DISTRICT	COUNTY	ROUTE	PROJECT	SHEET
12-0	WASHINGTON	1-79		
NORTH STRABANE TWP. & CANONSBURG BORO				
REVISIONS				

TABULATION OF QUANTITIES		
ITEM	UNIT	QUANTITY
POST MOUNTED SIGNS, TYPE A, LOGO	SQ.FT.	–
POST MOUNTED SIGNS, TYPE B, LOGO	SQ.FT.	–
POST MOUNTED SIGNS, TYPE C, LOGO	SQ.FT.	–
BREAKAWAY SYSTEMS	EACH	–
* STEEL S OR W BEAM POSTS	LBS.	–
LOGO SIGN MOUNTING	EACH	–
FLAT SHEET PANEL REPLACEMENT	SQ. FT.	
EXTRUDED PANEL REPLACEMENT	SQ. FT.	–
REMOVAL OF POST MOUNTED MOTORIST SERVICE SIGNS, TYPES B, C & F	L.S.	–

* APPROXIMATE QUANTITY FOR INFORMATION ONLY

SYMBOLS

- ○ *Existing Sign to Remain*
- △ *Existing Sign to be Removed*
- □ *Existing Sign Reset as Shown*
- ● NEW SIGN
- × FUTURE SIGN
- Ø *Existing Utility Pole*

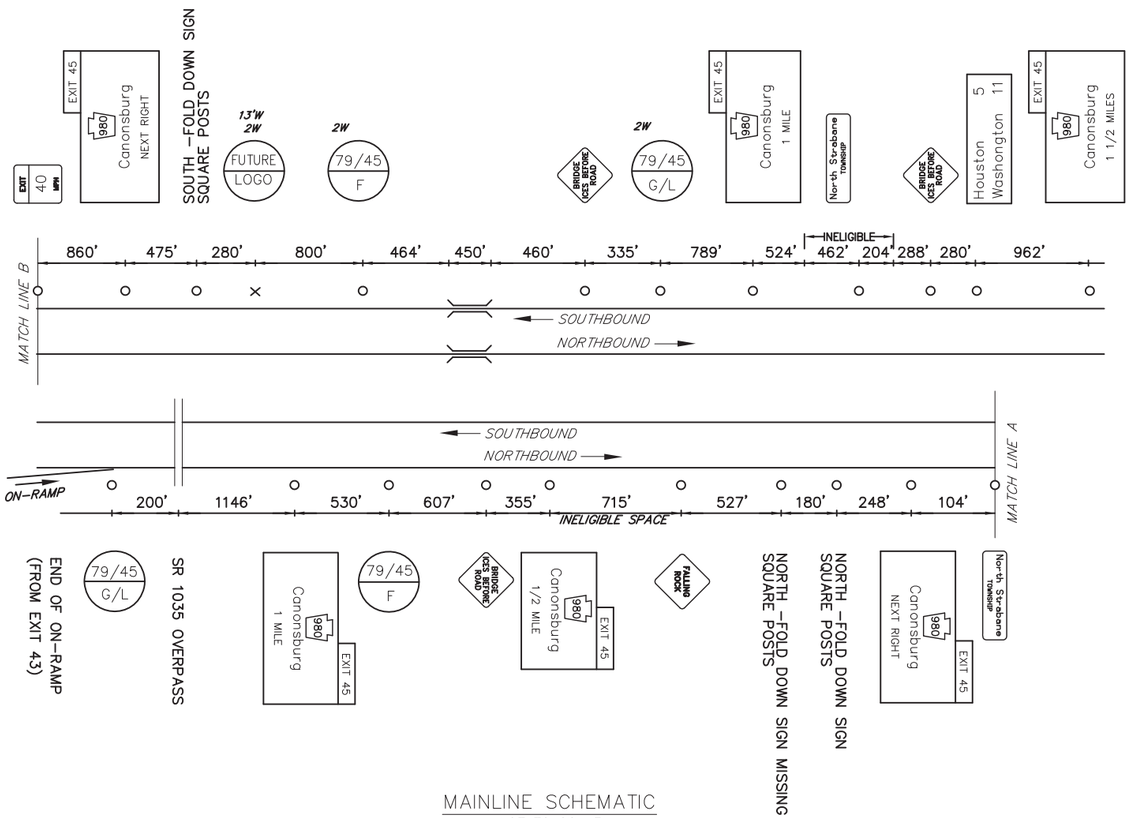

MAINLINE SCHEMATIC
NOT TO SCALE

WORK ALONG FREEWAY PERMITTED
BETWEEN 9:00 AM AND 3:00 PM.
DO NOT WORK DURING HOLIDAY PERIODS.
REINSTALL GUIDE RAIL AT END OF EACH DAY.

EXIT 45 SPECIFIC INFORMATION PANEL			
SIGN NUMBER	LEGEND	BUSINESS	LOGO. NO.
79/45 F NB 79/45 F SB	FOOD	McDONALD'S	1
		TACO BELL	2
		DUNKIN' DONUTS	3
		WENDY'S	4
		SUBWAY	7
		STARBUCKS	8
79/45 L NB 79/45 L SB	LODGING		
79/45 G NB	GAS	BP (24 HOURS)	9

NB SIGNS

14'Hx13'W
W10x26 A572
3M TYPE III

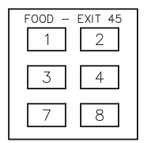

12'Hx13'W
W8x21 A572
3M TYPE III
B525 – #1, #2

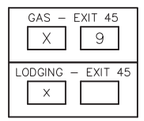

SB SIGNS

14'Hx13'W
W12x26 A572
3M TYPE III
B650 – #2, #1

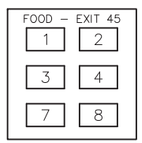

12'Hx13'W
FUTURE 16'H
W12x26 A572
3M TYPE III
B650 – #1, #1

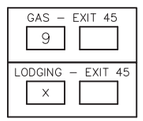

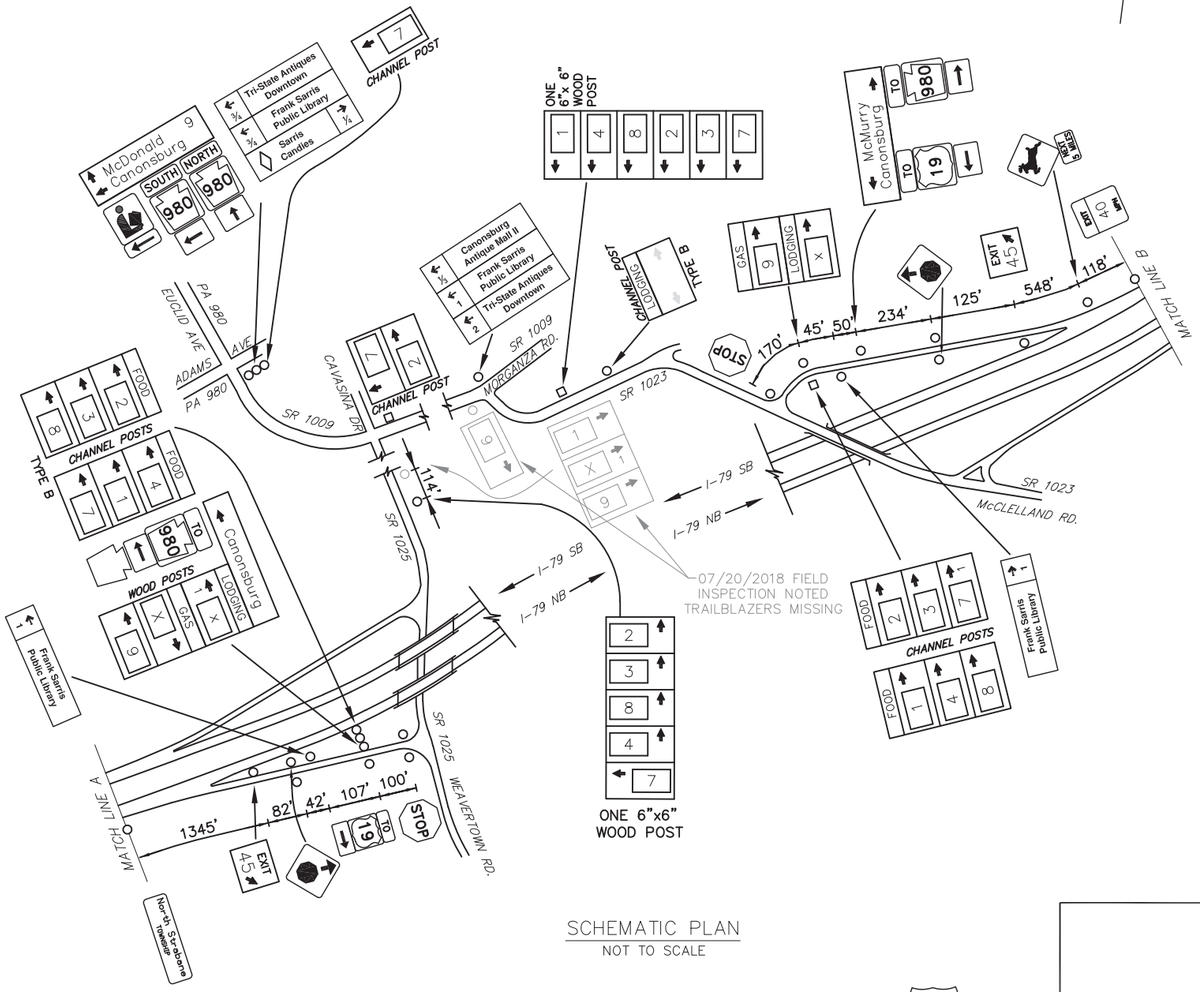

SCHEMATIC PLAN
NOT TO SCALE

INTERSTATE 79

CANONSBURG

EXIT 45

D:\2015_0285\215976-01\MKA\PSE\AS-BUILT DRAWINGS\PENNDOT DISTRICT 12\WASHINGTON - 6X10-XX SHTXX-179_EXIT 45 PLAN
Apr 1/5/2019 4:54 PM