DISTRICT	COUNTY	ROUTE	PROJECT	SHEET
11-0	ALLEGHENY	PA-28		

FAWN AND HARRISON TOWNSHIPS

REVISIONS

TABULATION OF QUANTITIES		
ITEM	UNIT	QUANTITY
POST MOUNTED SIGNS, TYPE A, LOGO	SQ.FT.	–
POST MOUNTED SIGNS, TYPE B, LOGO	SQ.FT.	–
BREAKAWAY SYSTEMS	EACH	–
* STEEL S OR W BEAM POSTS	LBS.	–
LOGO SIGN MOUNTING	EACH	–

* APPROXIMATE QUANTITY FOR INFORMATION ONLY

SYMBOLS

- ○ *Existing Sign to Remain*
- △ *Existing Sign to be Removed*
- *Existing Sign Reset as Shown*
- ● NEW SIGN
- × FUTURE SIGN
- Ø *Existing Utility Pole*

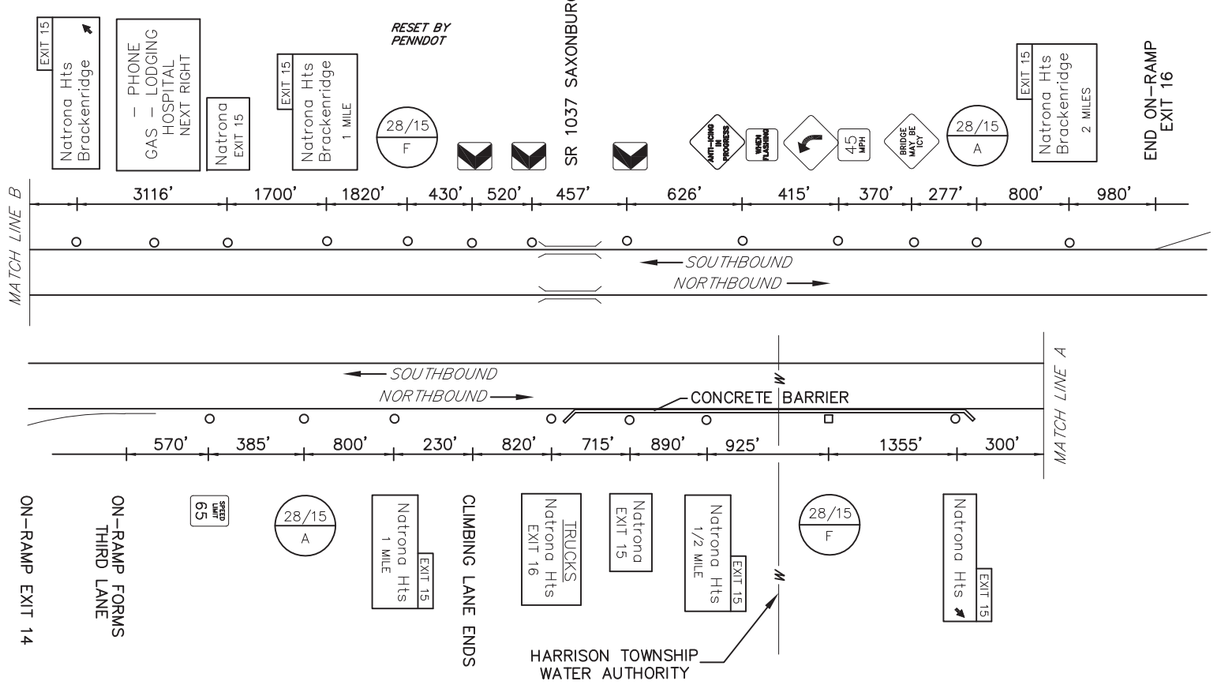

MAINLINE SCHEMATIC
NOT TO SCALE

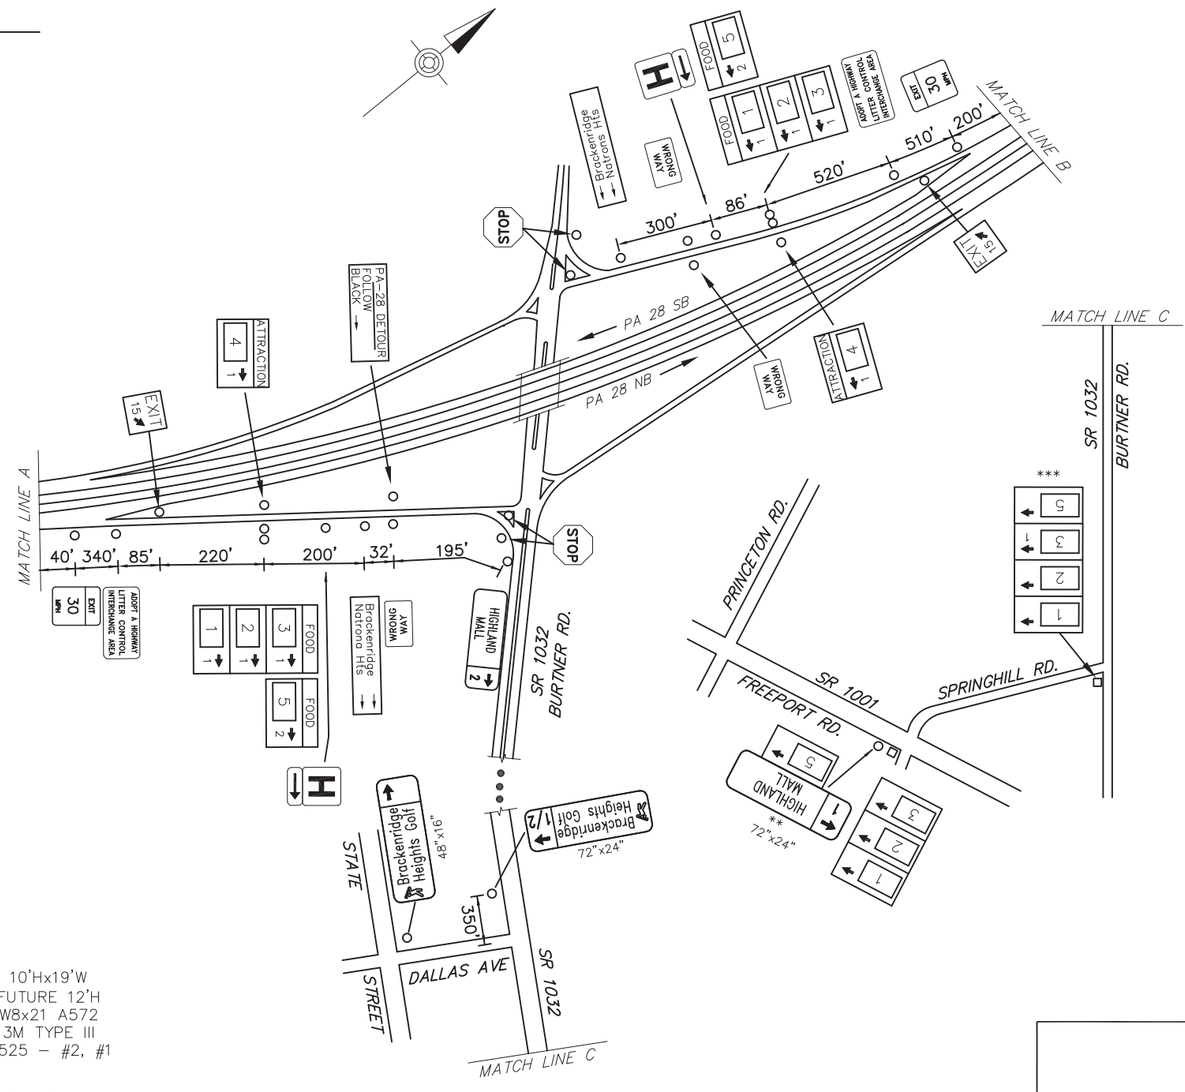

SCHEMATIC PLAN
NOT TO SCALE

EXIT 15 SPECIFIC INFORMATION PANEL			
SIGN NUMBER	LEGEND	BUSINESS	LOGO. NO.
28/15 F NB 28/15 F SB	FOOD	McDONALD'S	1
		WENDY'S	2
		EAT'N PARK (24HOURS)	3
		SHEETZ	5
28/15 A NB 28/15 A SB	ATTRACTION	BRACKENRIDGE HEIGHTS GOLF	4

NB SIGNS

10'Hx19'W
FUTURE 12'H
W10x22 A572
3M TYPE III
B650 – #2, #2

FOOD – EXIT 15: 1 2 3 / 5

6'Hx13'W
FUTURE 16'H
W14x30 A572
3M TYPE III
SBM – 650

ATTRACTION – EXIT 15: 4

SB SIGNS

FOOD – EXIT 15: 1 2 3 / 5

10'Hx19'W
FUTURE 12'H
W8x21 A572
3M TYPE III
B525 – #2, #1

ATTRACTION – EXIT 15: 4

6'Hx13'W
FUTURE 16'H
W14x30 A572
3M TYPE III
SBM – 650

28
NATRONA HEIGHTS
EXIT 15

\\DAVAPROJ01\PROJECTS\2015_ED\ES\025076-01\Wk\PSE\AS-BUILT DRAWINGS\PENNDOT DISTRICT 11\ALLEGHENY - 02\10-XX SHTXX 28_EXIT 15 PLAN
May/14/2019 1:07 PM