DISTRICT	COUNTY	ROUTE	PROJECT	SHEET
9-0	BEDFORD	I-99		

BEDFORD TOWNSHIP

REVISIONS

TABULATION OF QUANTITIES		
ITEM	UNIT	QUANTITY
* STEEL S OR W BEAM POSTS	LBS.	-
BREAKAWAY SYSTEMS	EACH	-
POST MOUNTED SIGNS, TYPE A, LOGO	SQ.FT.	-
POST MOUNTED SIGNS, TYPE B, LOGO	SQ.FT.	-
POST MOUNTED SIGNS, TYPE C, LOGO	SQ.FT.	-
LOGO SIGN MOUNTING	EACH	-
FLAT SHEET REPLACEMENT PANEL	SQ.FT.	-
EXTRUDED PANEL REPLACEMENT	SQ.FT.	-
REMOVAL OF POST MOUNTED MOTORIST SERVICE SIGNS, TYPES B, C & F	L.S.	-

* APPROXIMATE QUANTITY FOR INFORMATION ONLY

SYMBOLS

- ○ *Existing Sign to Remain*
- △ *Existing Sign to be Removed*
- □ *Existing Sign Reset as Shown*
- ● NEW SIGN
- × FUTURE SIGN
- Ø *Existing Utility Pole*

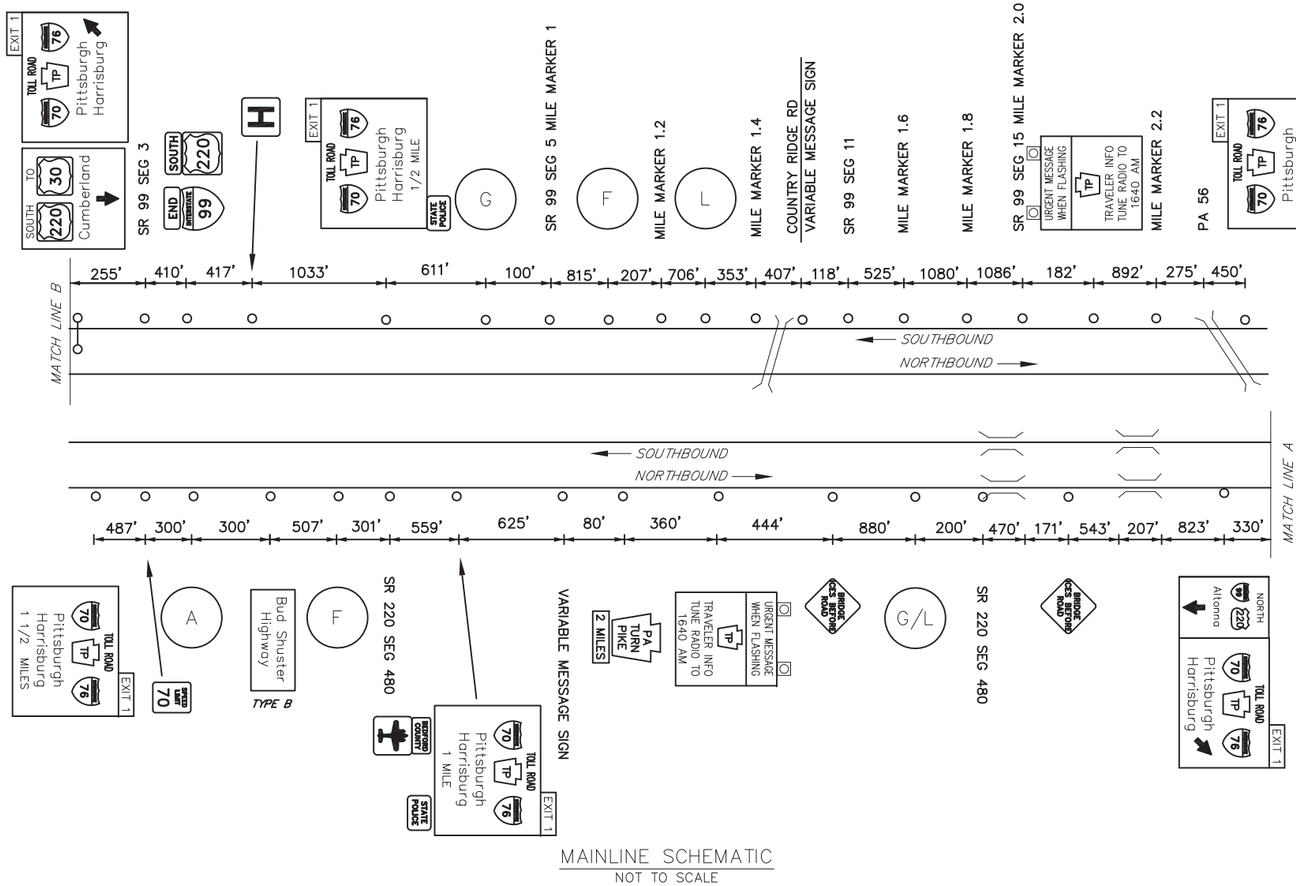

MAINLINE SCHEMATIC
NOT TO SCALE

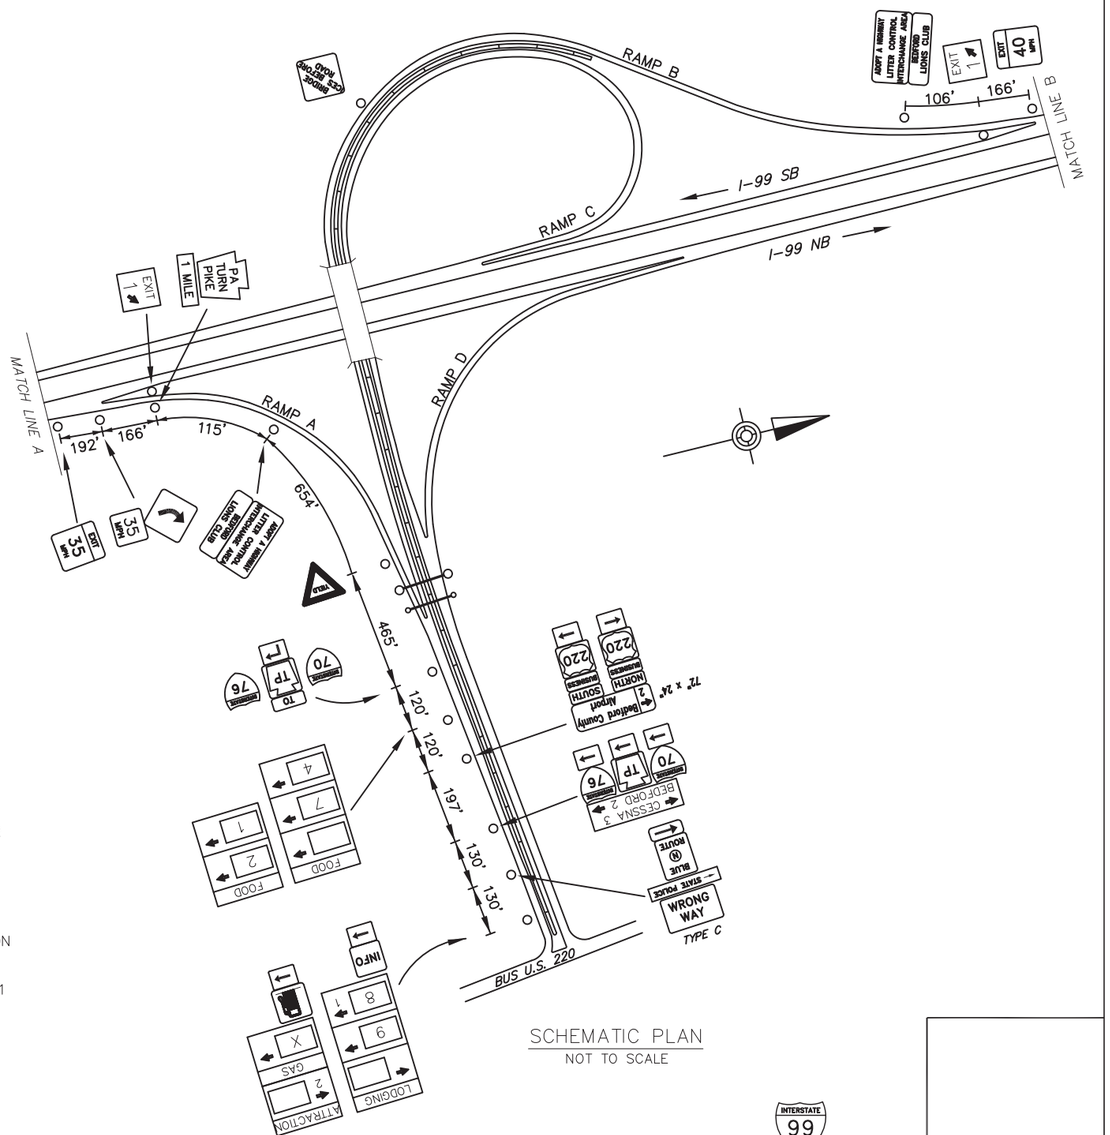

SCHEMATIC PLAN
NOT TO SCALE

EXIT 1 SPECIFIC INFORMATION PANEL			
LEGEND	DIRECTION	BUSINESS	LOGO. NO.
GAS	NB/SB	X	X
FOOD	NB/SB	PIZZA HUT	1
		HOSS'S FAMILY STEAK & SEA	2
		TACO BELL	11
		McDONALD'S	7
		WENDY'S	4
LODGING	NB/SB	HAMPTON INN	8
		QUALITY INN	9
ATTRACTION	NB		

NB SIGNS

16'Hx13'W
W14x30 A572
3M TYPE III
B650 - #3, #1

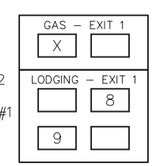

14'Hx13'W
W12x26
3M TYPE III
B650 - #1, #1

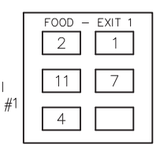

10'Hx13'W
FUTURE 14'H
W10x26
3M TYPE III
B650 - #1, #1

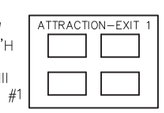

SB SIGNS

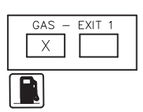

6'Hx13'W
FUTURE 18'H
W18x40 A572
3M TYPE III
B650 - #2, #2

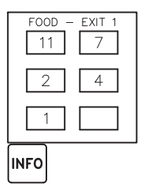

14'Hx13'W
16' TOP SECTION
W12x26
3M TYPE III
B650 - #2, #1

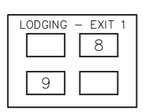

10'Hx13'W
FUTURE 14'H
W10x26
3M TYPE III
BURIED,
B650-#1

INTERSTATE 99

TOLL ROAD BEDFORD,
BUS. 220
EXIT 1

D:\2015_ADB\315976-01\WK\PSE\AS-BUILT DRAWINGS\PENNDOT DISTRICT 09\BEDFORD - 03\10-XX SHTXX-I99_EXIT 01 PLAN
June/11/2019 2:44 PM