DISTRICT	COUNTY	ROUTE	PROJECT	SHEET
9-0	BEDFORD	I-99		
BEDFORD & EAST ST. CLAIR TOWNSHIPS				
REVISIONS				

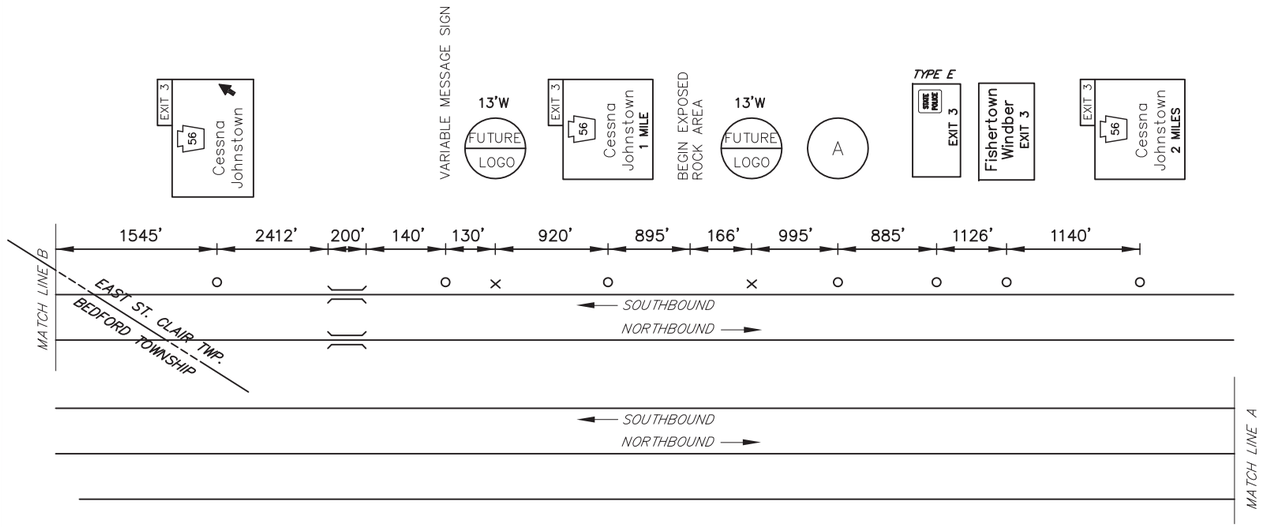

MAINLINE SCHEMATIC
NOT TO SCALE

TABULATION OF QUANTITIES		
ITEM	UNIT	QUANTITY
POST MOUNTED SIGNS, TYPE A, LOGO	SQ.FT.	
POST MOUNTED SIGNS, TYPE B, LOGO	SQ.FT.	
POST MOUNTED SIGNS, TYPE C, LOGO	SQ.FT.	
BREAKAWAY SYSTEMS	EACH	
* STEEL S OR W BEAM POSTS	LBS.	
LOGO SIGN MOUNTING	EACH	
REMOVAL OF POST MOUNTED MOTORIST SERVICE SIGNS, TYPES A & E	EACH	
REMOVAL OF POST MOUNTED MOTORIST SERVICE SIGNS, TYPES B, C & F	L.S.	

* APPROXIMATE QUANTITY FOR INFORMATION ONLY

SYMBOLS

- ○ *Existing Sign to Remain*
- △ *Existing Sign to be Removed*
- □ *Existing Sign Reset as Shown*
- ● NEW SIGN
- × FUTURE SIGN
- Ø *Existing Utility Pole*

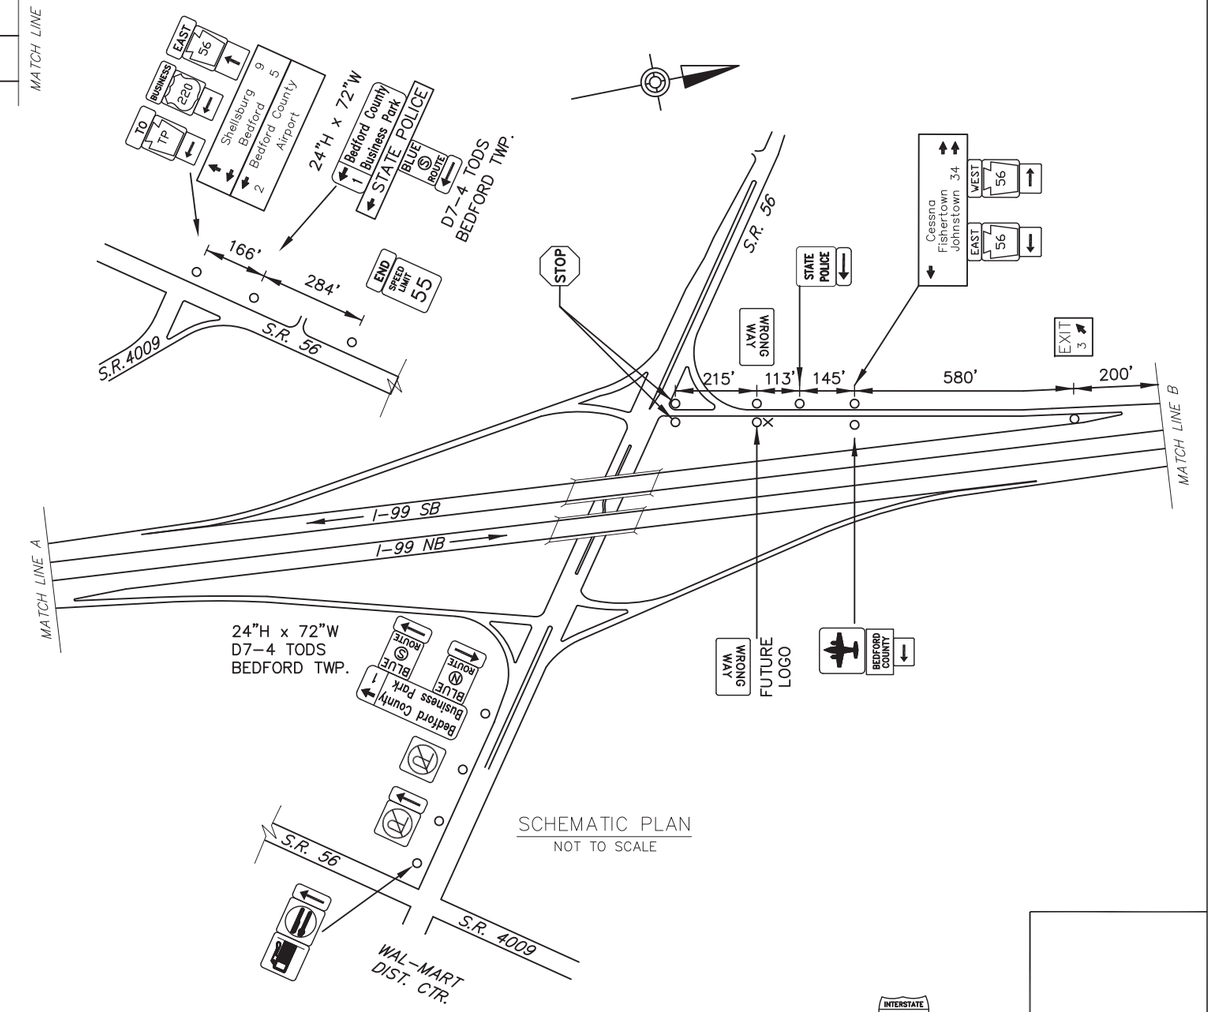

SCHEMATIC PLAN
NOT TO SCALE

EXIT 3 SPECIFIC INFORMATION PANEL			
LEGEND	DIRECTION	BUSINESS	LOGO. NO.
ATTRACTION	SB		

SB SIGNS

6'Hx13'W
FUTURE 16'H
W14x30 A572
3M TYPE III
B650 – #2, #2

INTERSTATE 99

S.R. 56 CESSNA

EXIT 3

D:\2015\JOB\215076-01\INV\PSE\AS-BUILT DRAWINGS\PENNDOT DISTRICT 09\BEDFORD - I99\0-XX SHT\XX-I99_EXIT 03 PLAN
June/6/2019 1:36 PM